0374_416

04DM14 - 1050
SECTIONS Book 23-8-90

5 cm

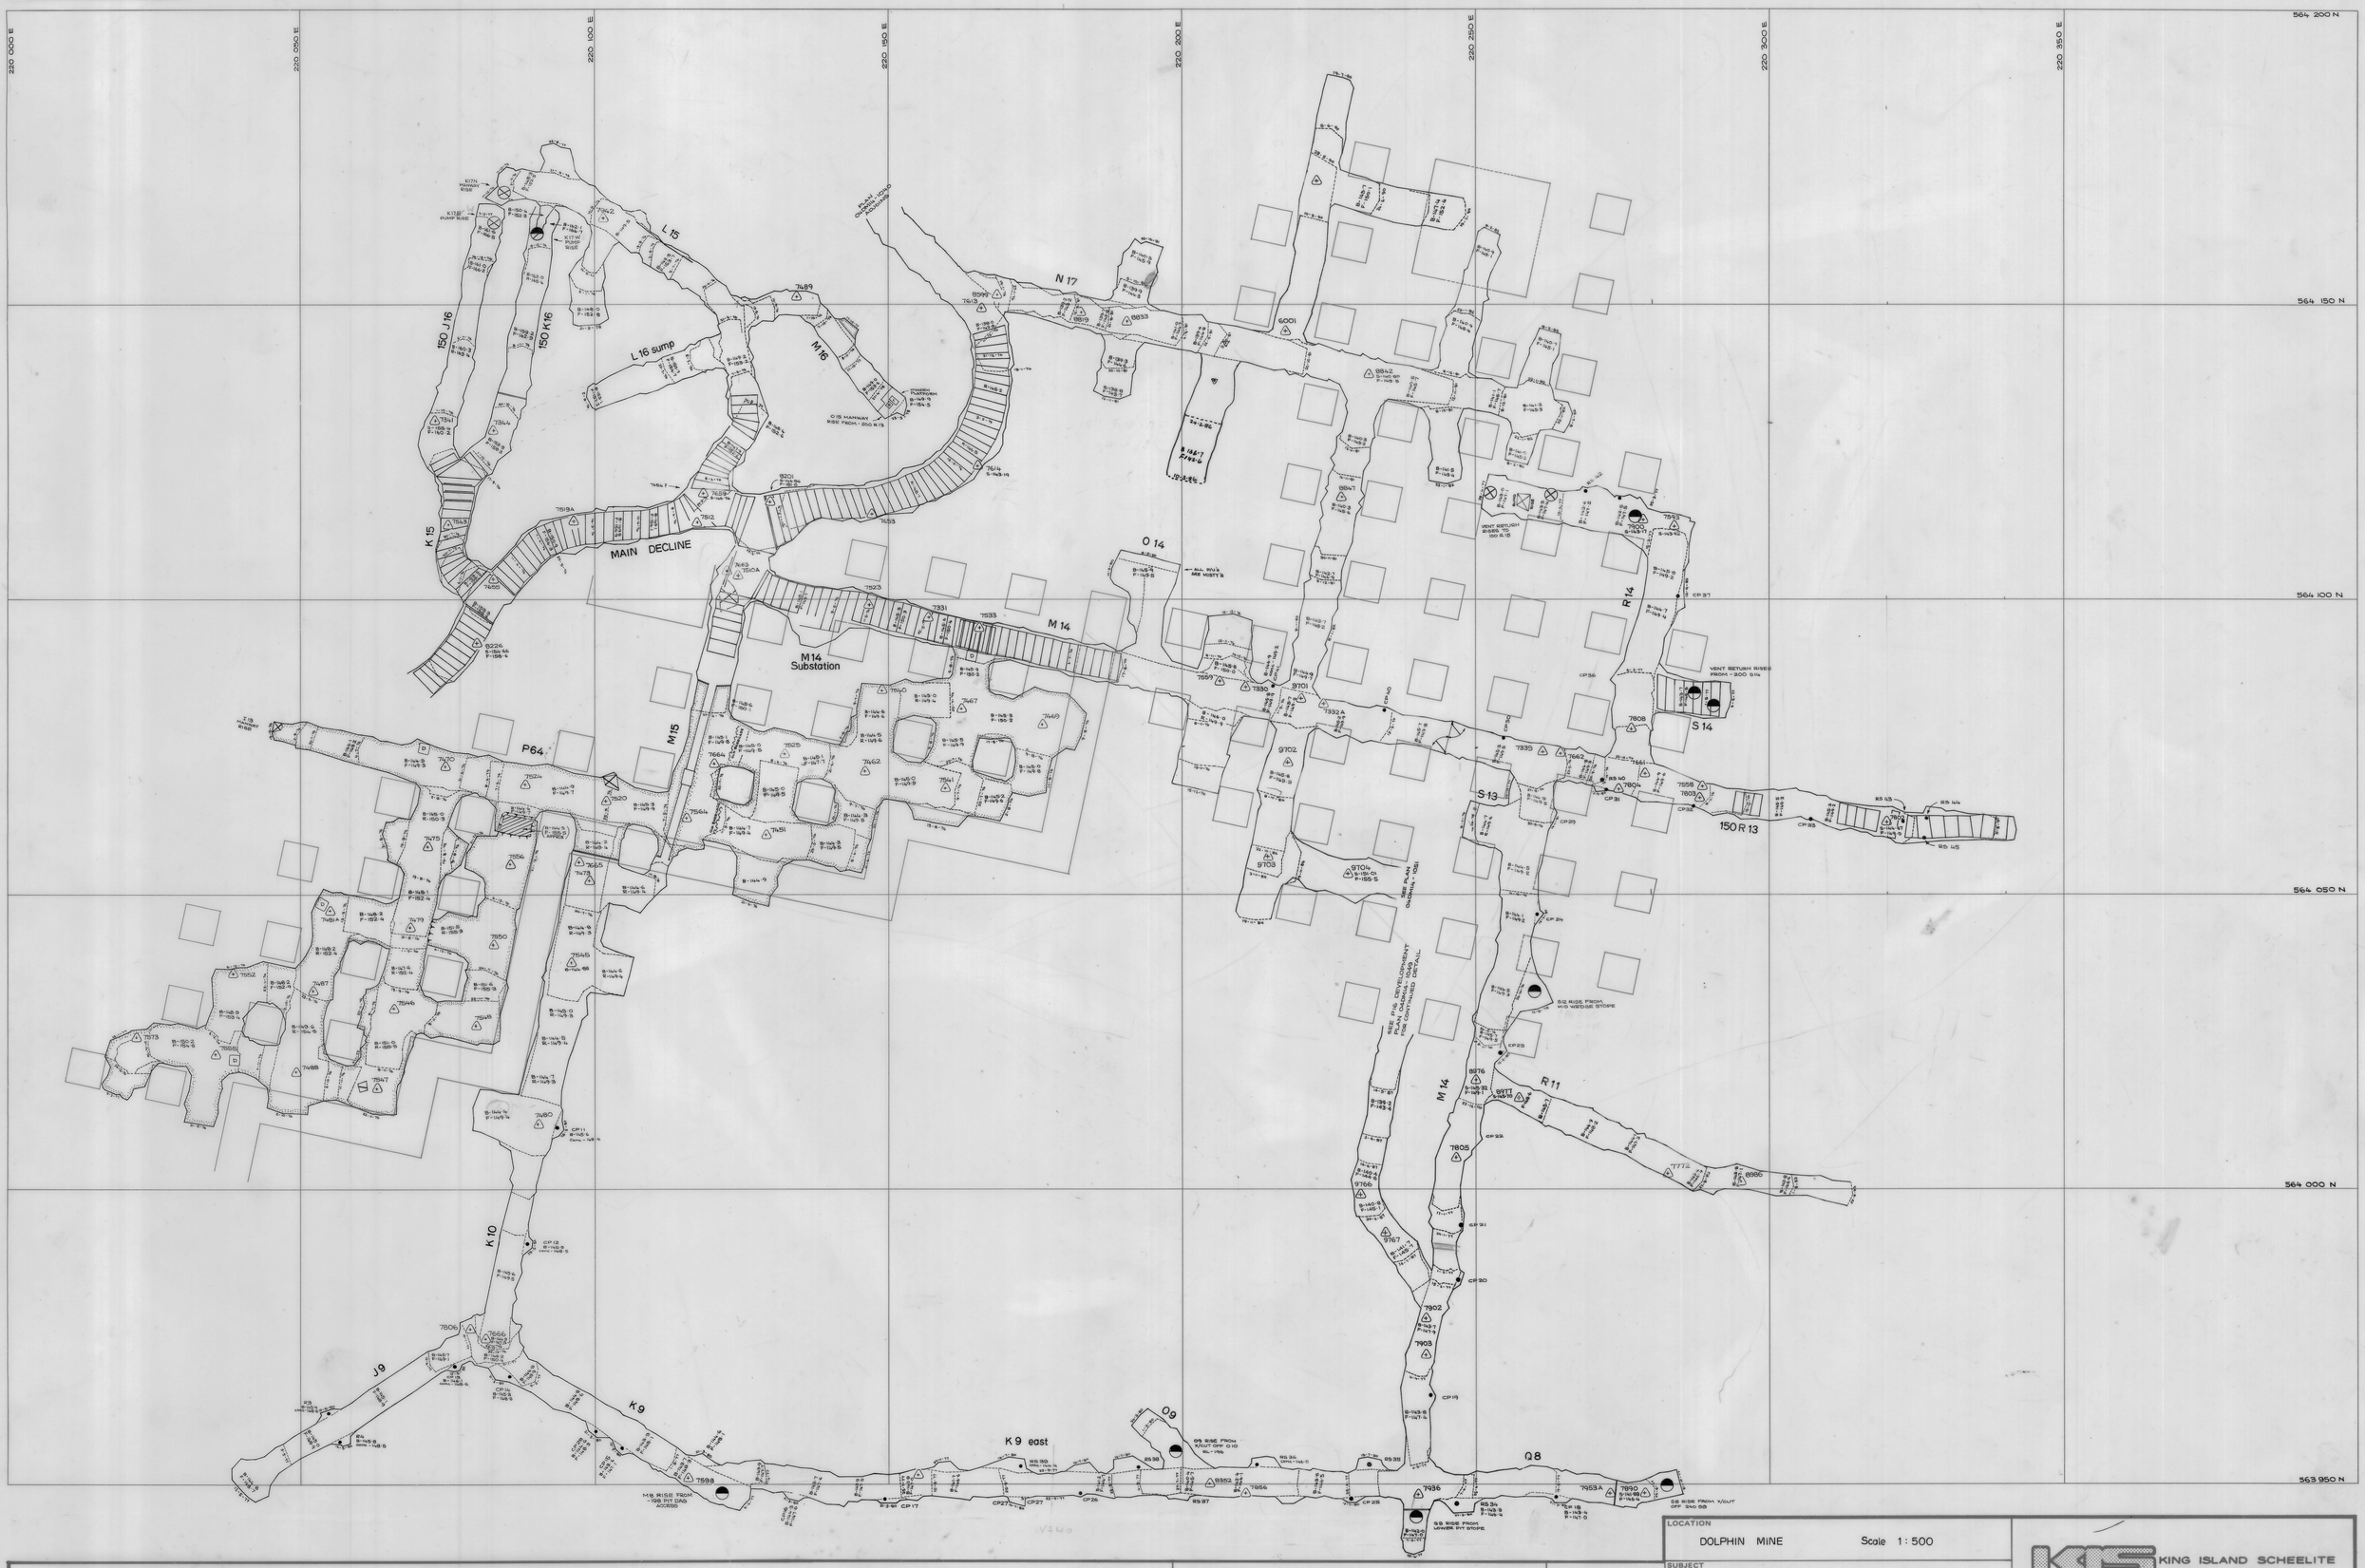

north

LOCATION
DOLPHIN MINE Scale 1:500

SUBJECT
-150 m ZONE DEVELOPMENT

KING ISLAND SCHEELITE
A DIVISION OF WARMAN INTERNATIONAL
GRASSY KING ISLAND

PLAN NUMBER
04DM14 - 1050