5 cm

04 BH11 . 1009

0374 _ 4167

H 50
4th lift

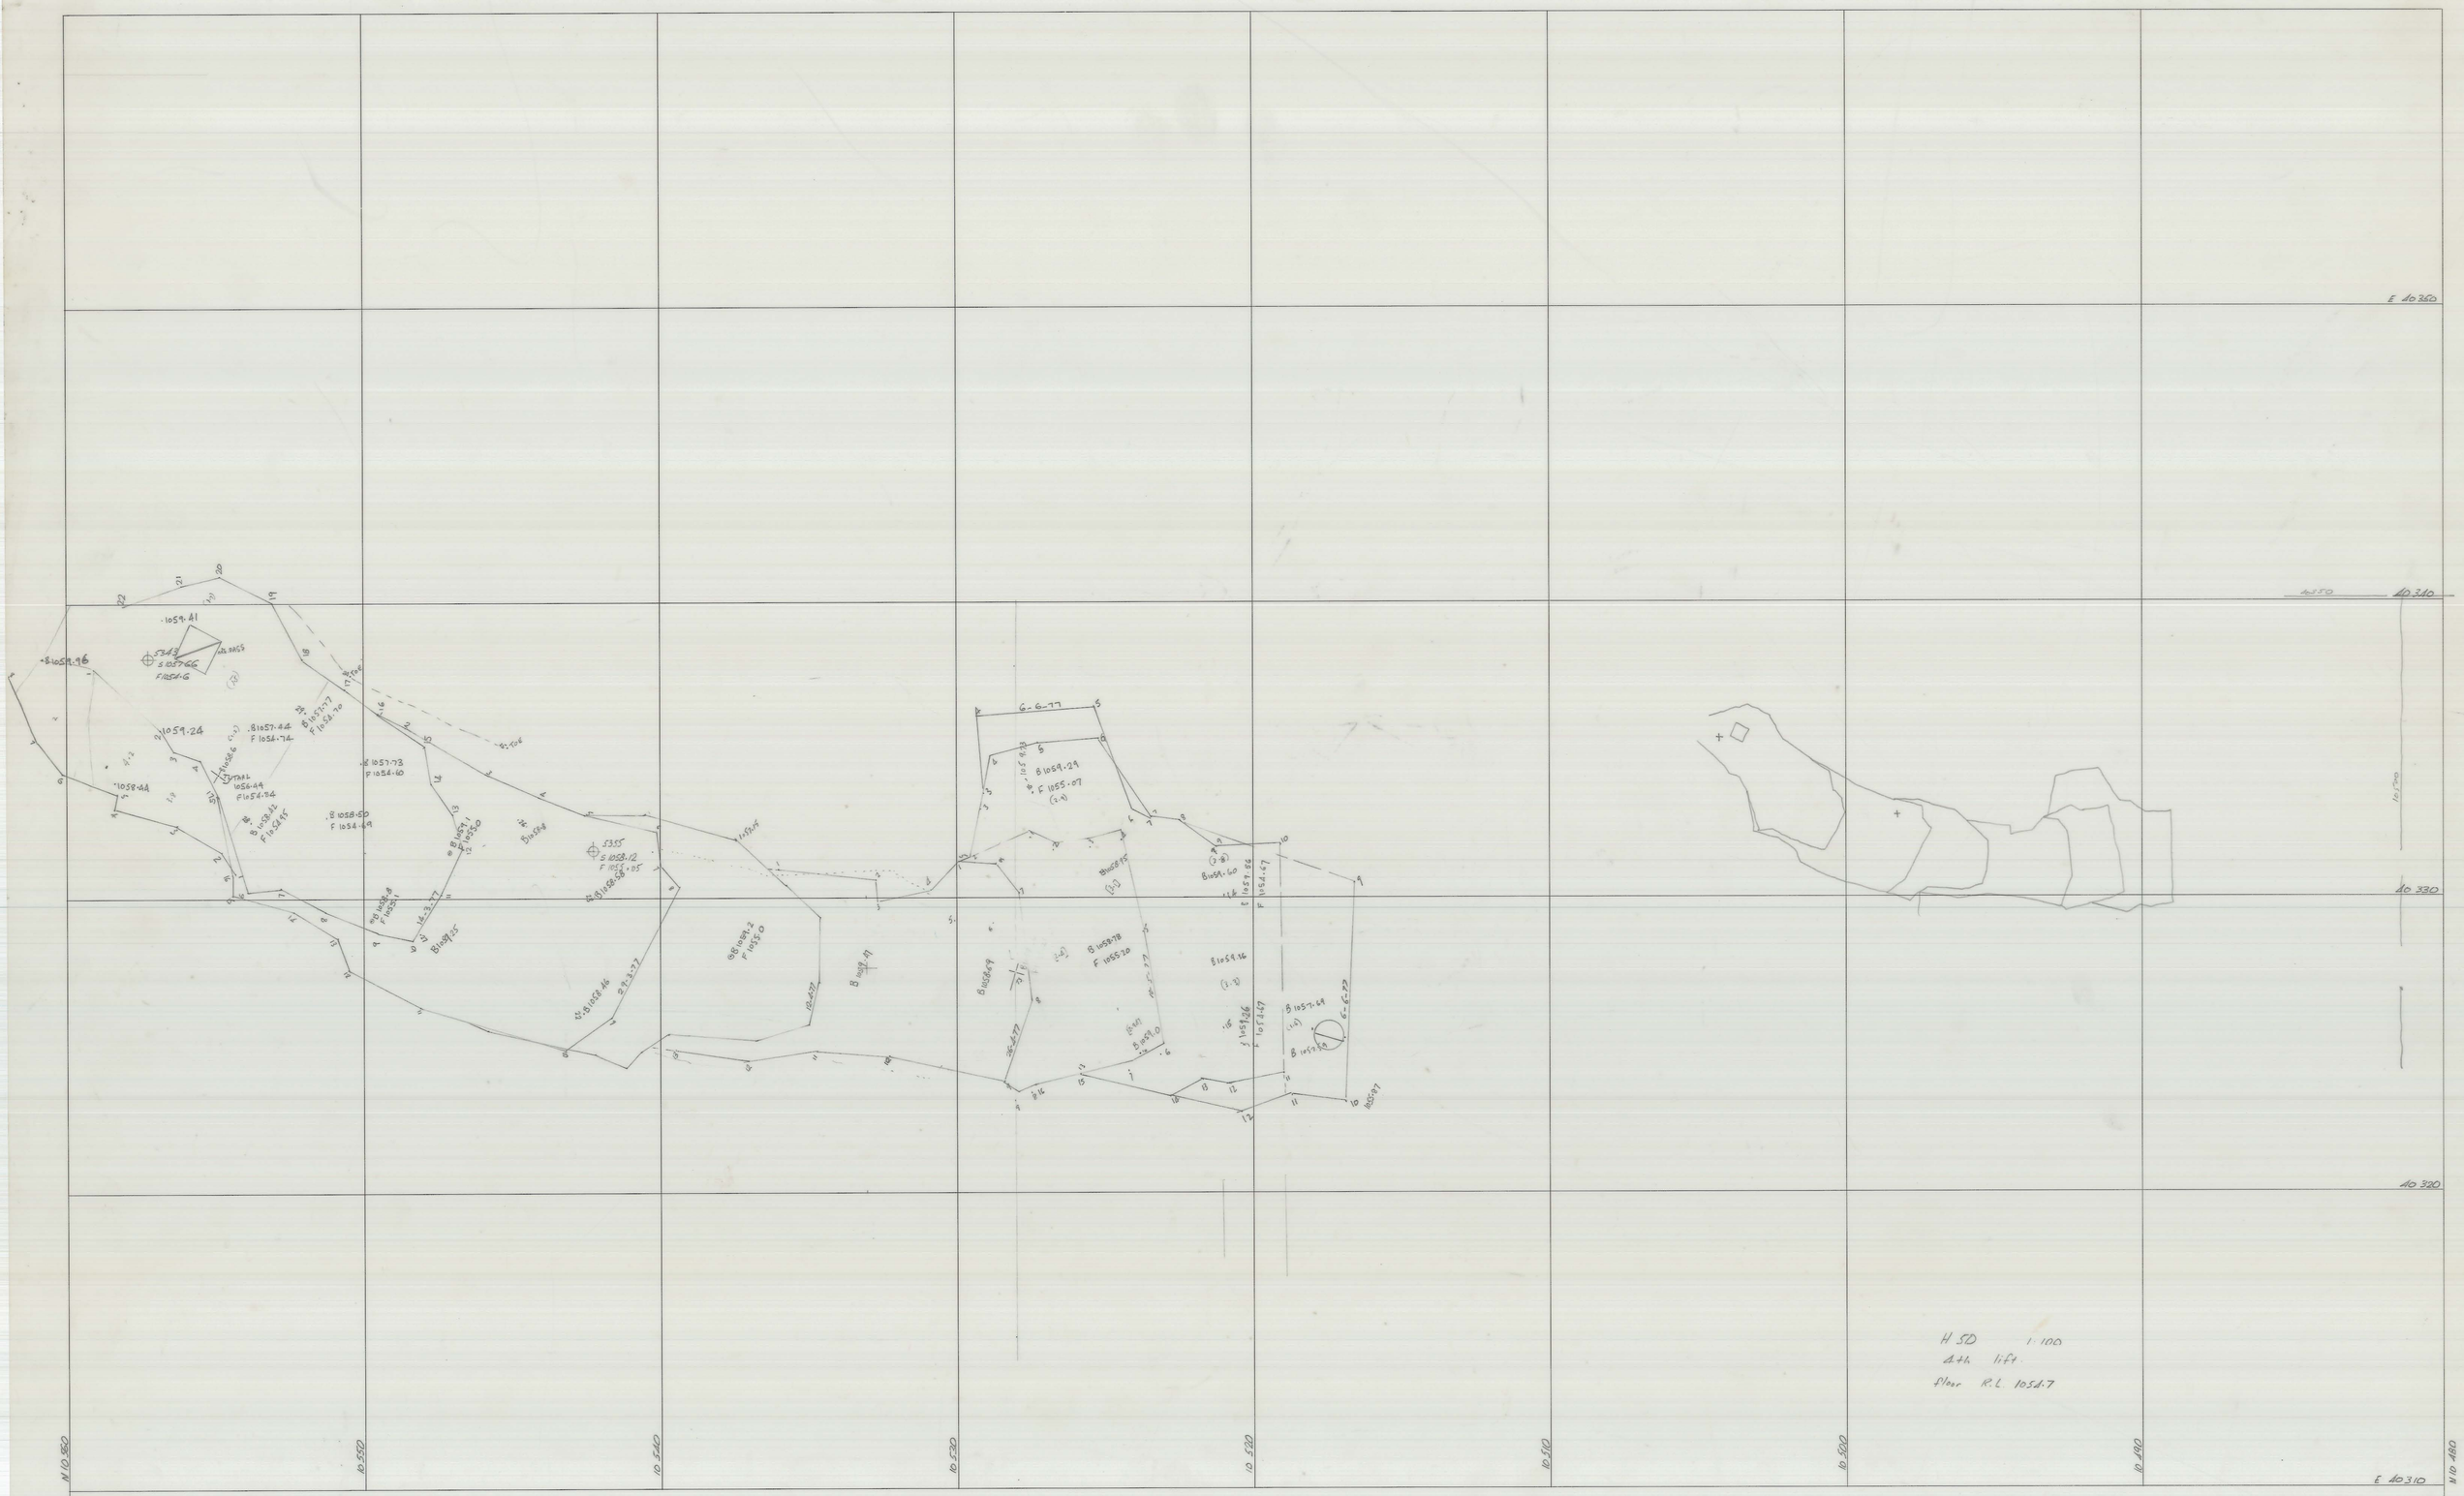

M-23-3-77