5 cm

04BH11-015
0374_4172

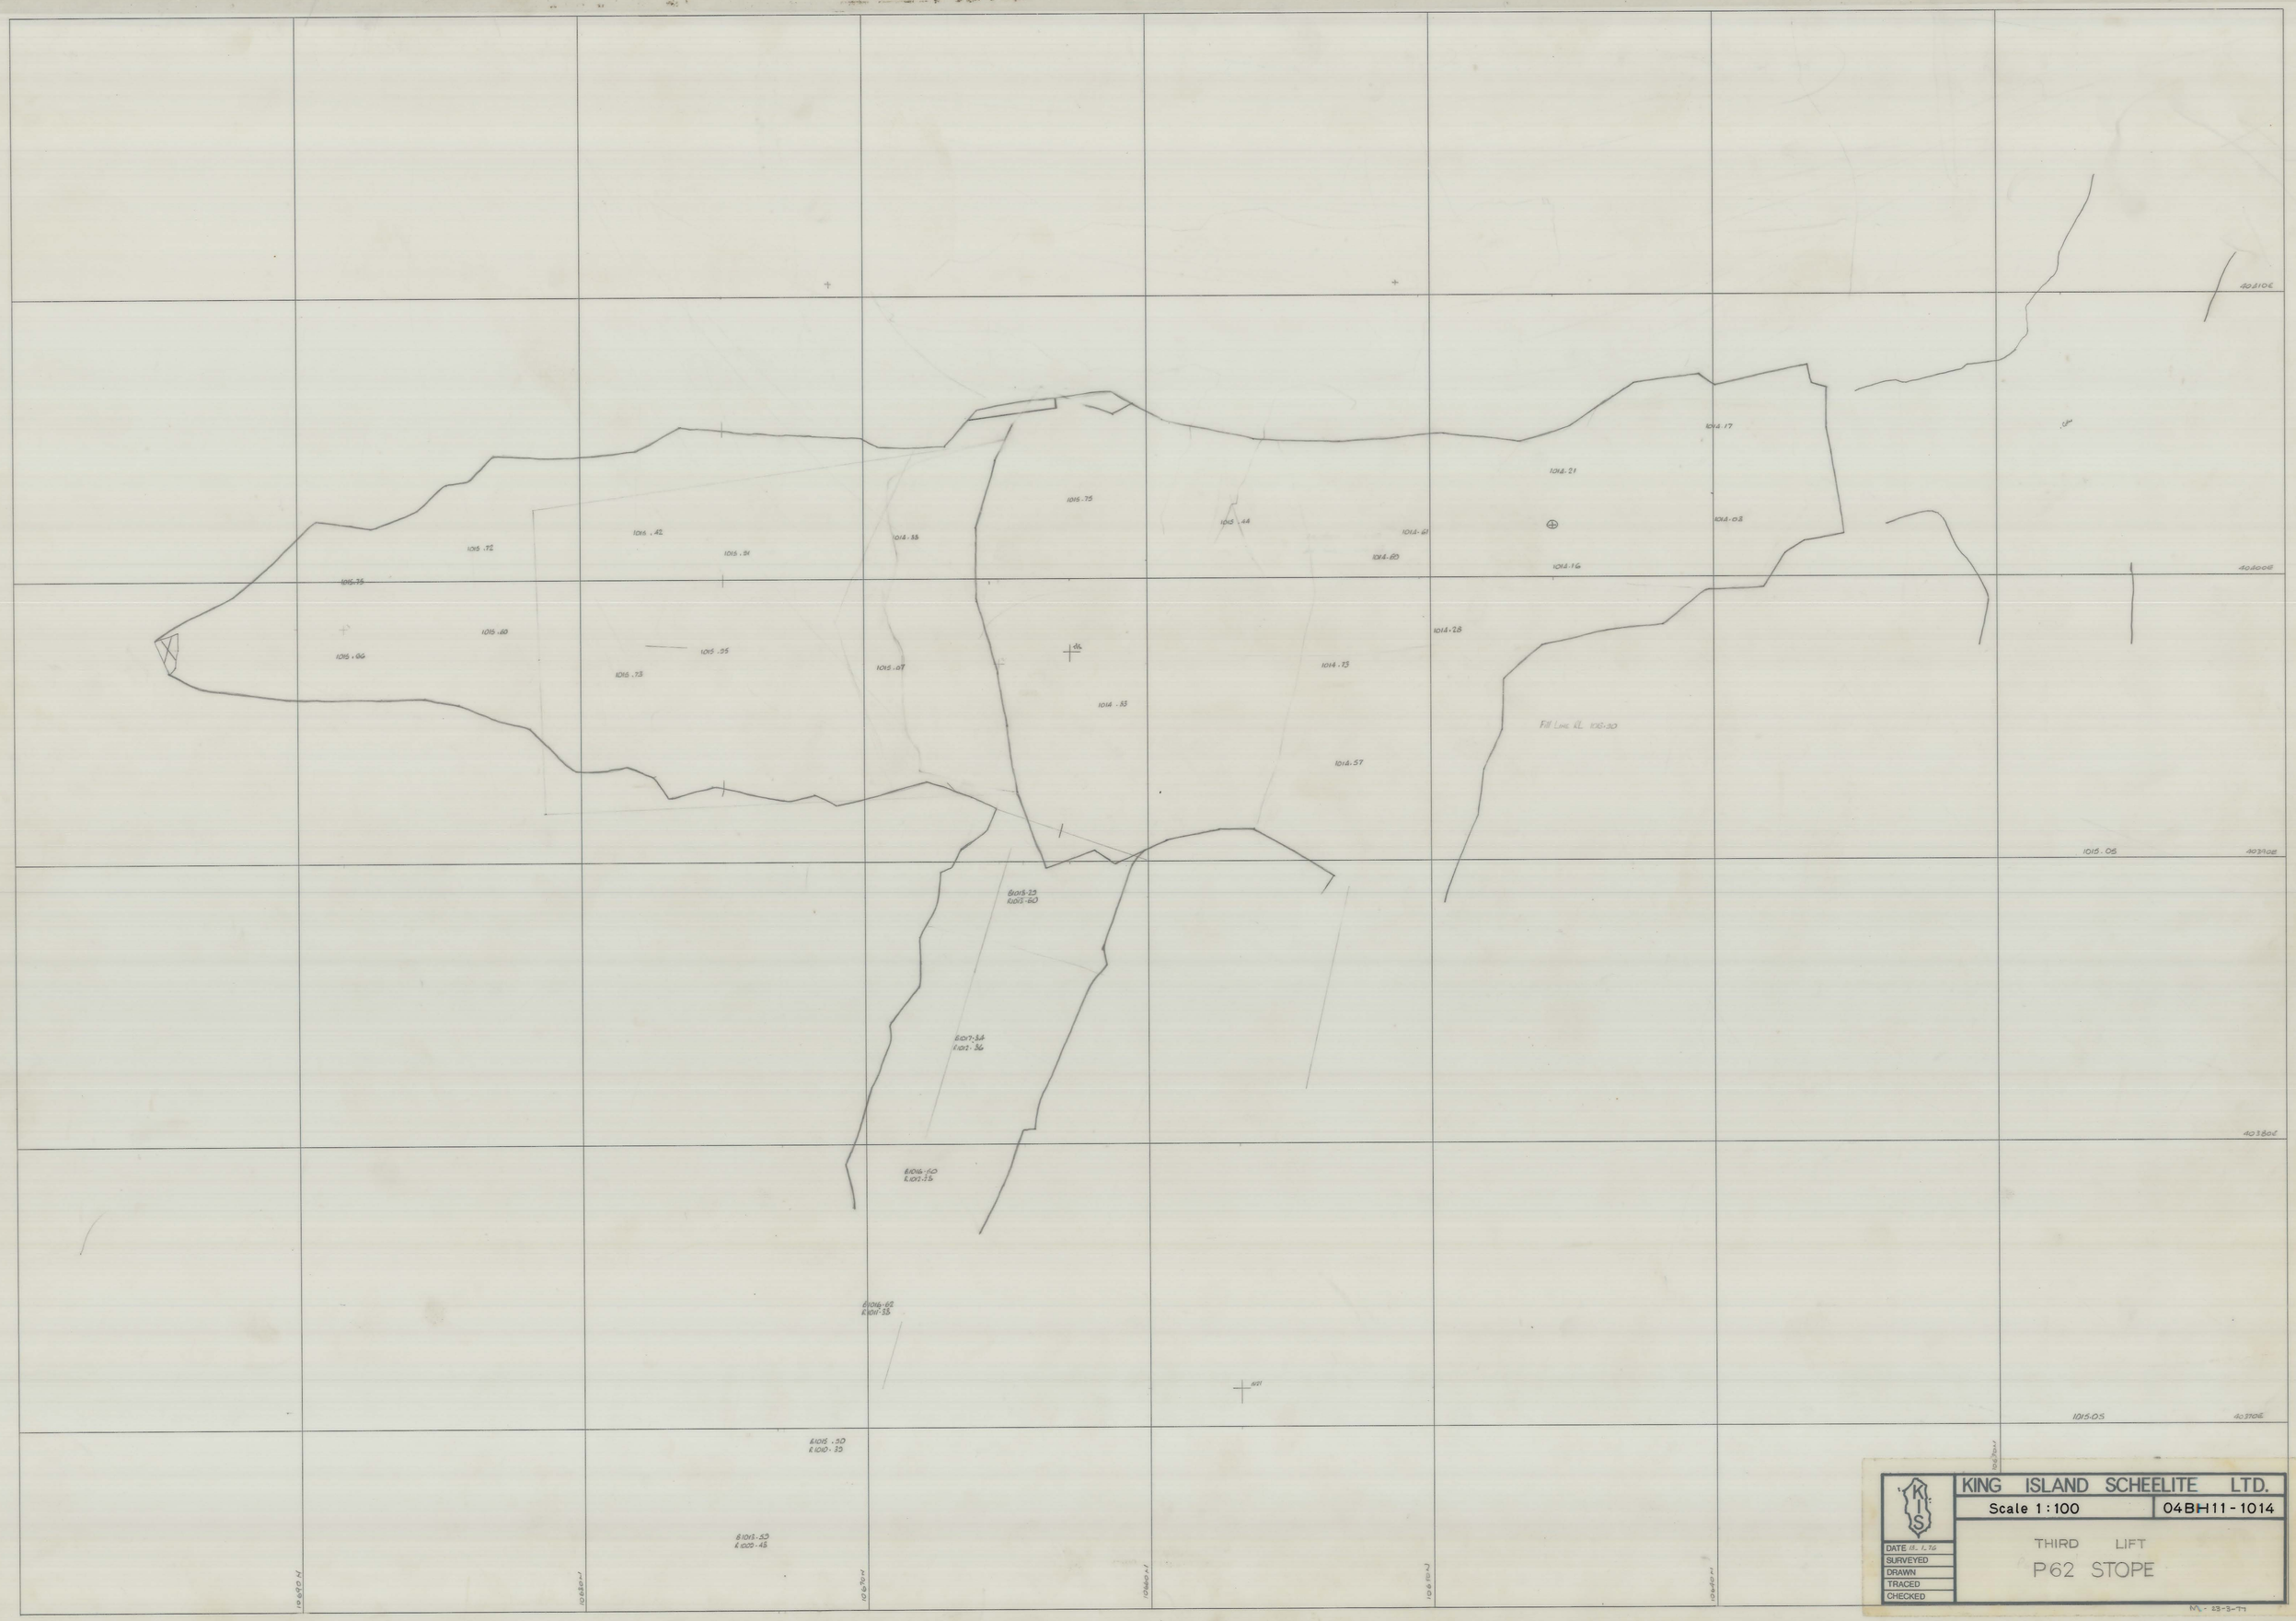
1015.72
1015.75
1015.66
1015.60
1015.42
1015.91
1015.55
1015.73
1015.07
1014.55
1015.75
1015.44
1014.61
1014.80
1014.21
1014.17
1014.08
1014.16
1014.28
1014.73
1014.53
1014.57
Fill Line RL 106.30
1015.05
1015.05
1015.05