5 cm

0374_4180

OA BH 11-1.66 120

P57
1st lift

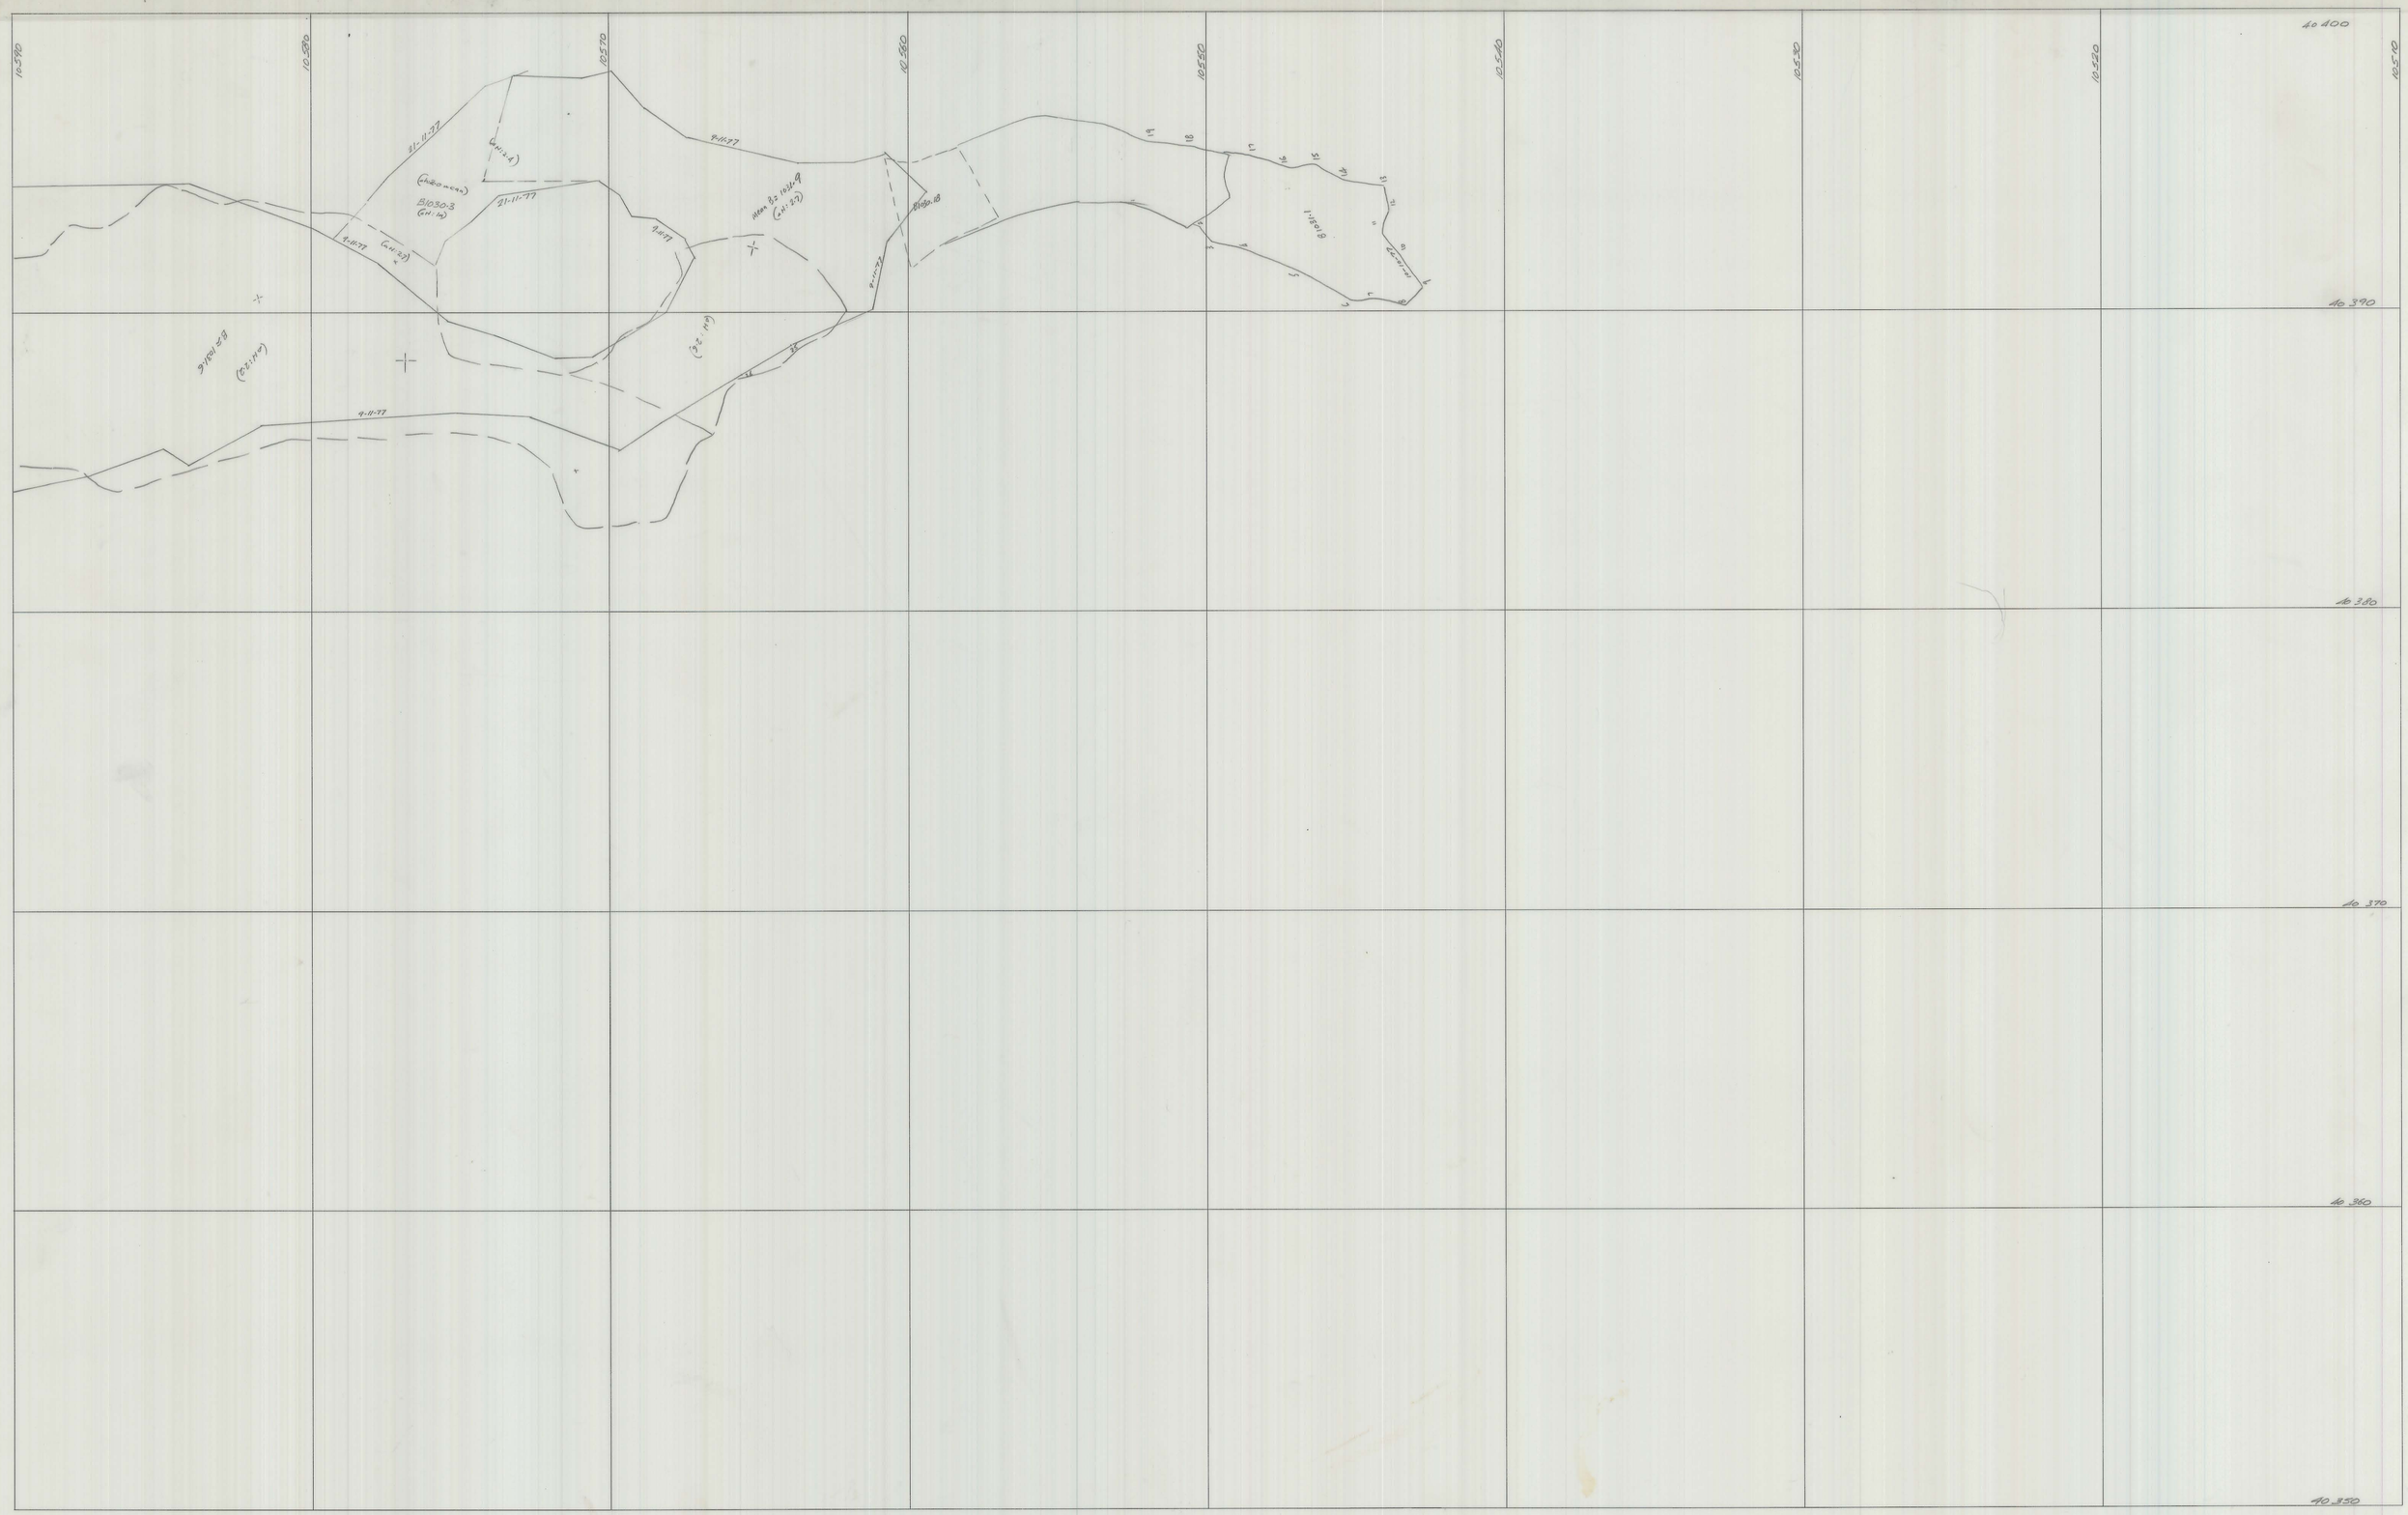

	SCALE 1	north	LOCATION SUBJECT

KING ISLAND SCHEELITE
A DIVISION OF WARMAN INTERNATIONAL

GRASSY KING ISLAND

PLAN NUMBER