5 cm

0374-4183

04 3H 11 — 144 208

R40.

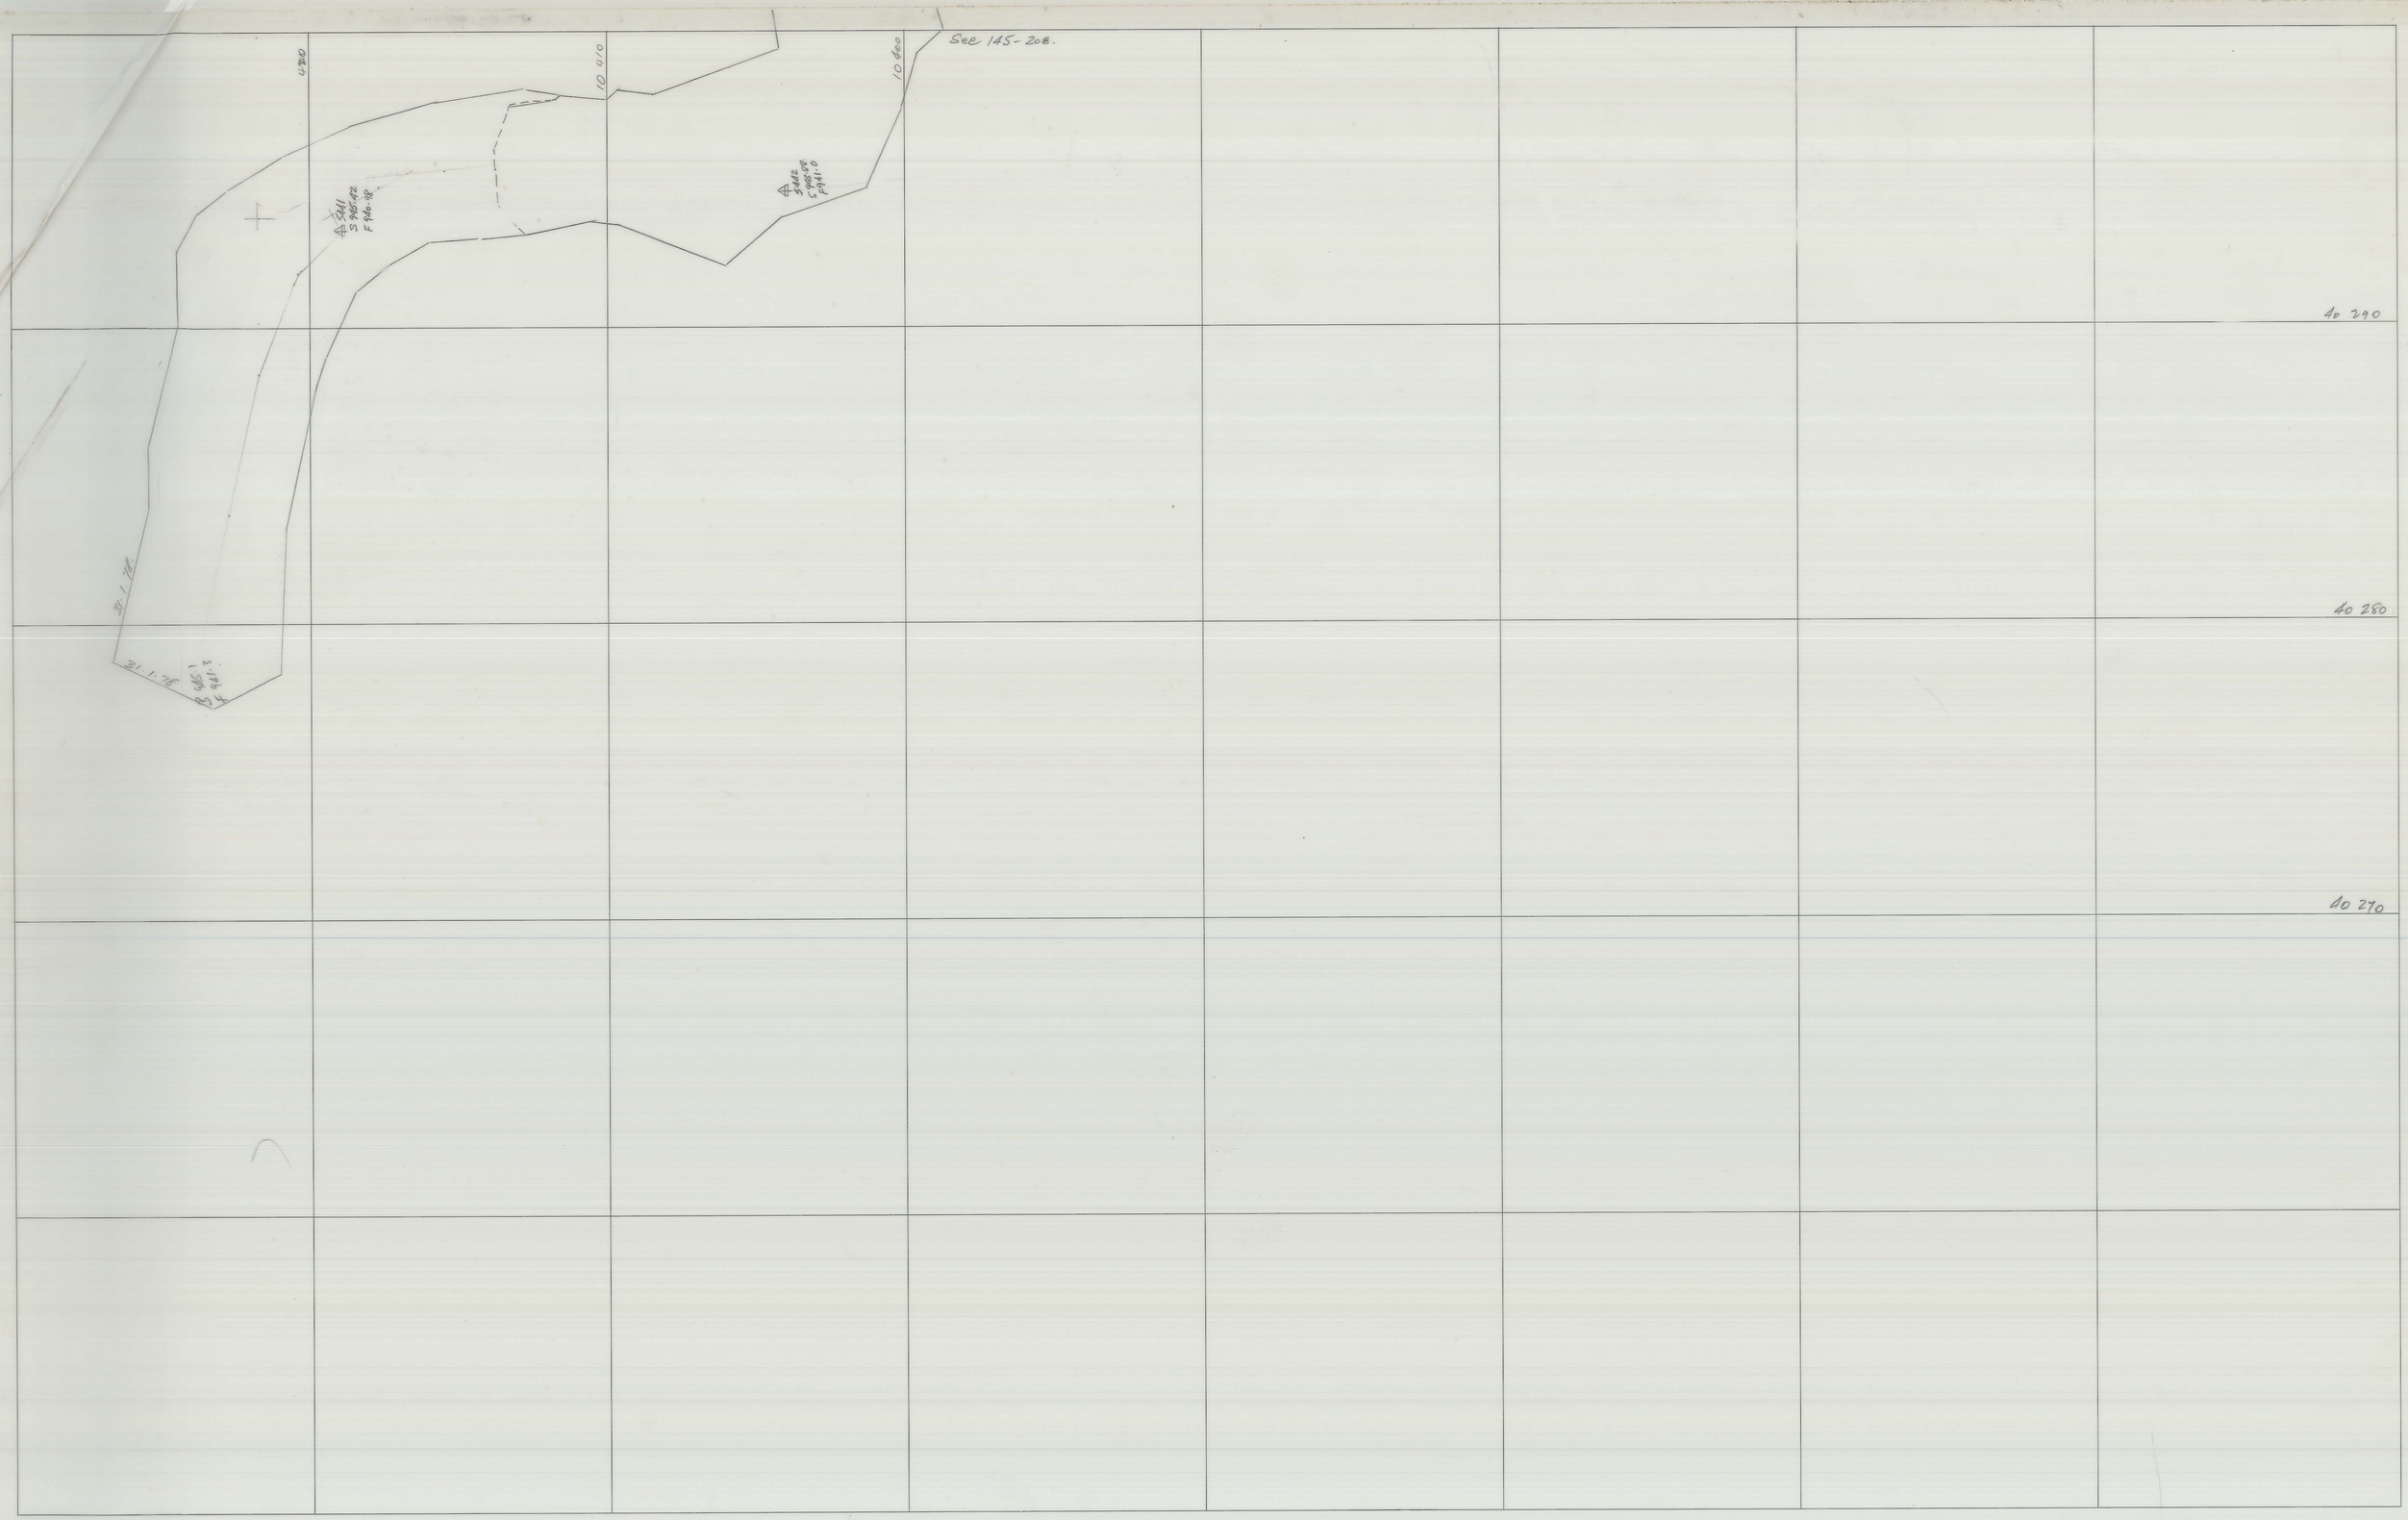

	SCALE 1	north	LOCATION	KING ISLAND SCHEELITE A DIVISION OF WARMAN INTERNATIONAL
			SUBJECT	GRASSY KING ISLAND
				PLAN NUMBER