5 cm

04 BH 11 - 157215

Q51

0374_4188

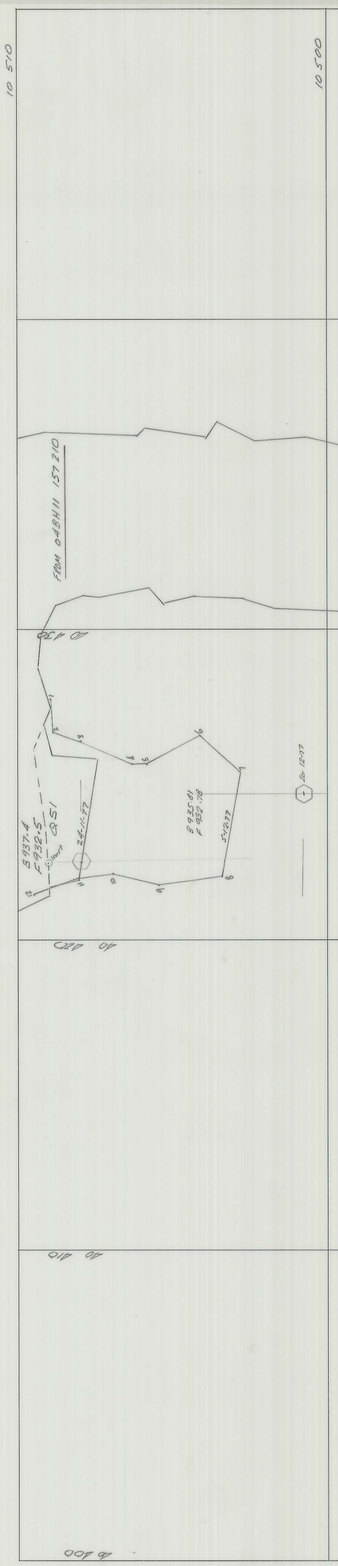

SCALE	1
LOCATION	
SUBJECT	
north	
KING ISLAND SCHEELITE — A DIVISION OF WARMAN INTERNATIONAL	
GRASSY	KING ISLAND
PLAN NUMBER	