0374_4190

HSD
6th lift

04BH11 1 65089

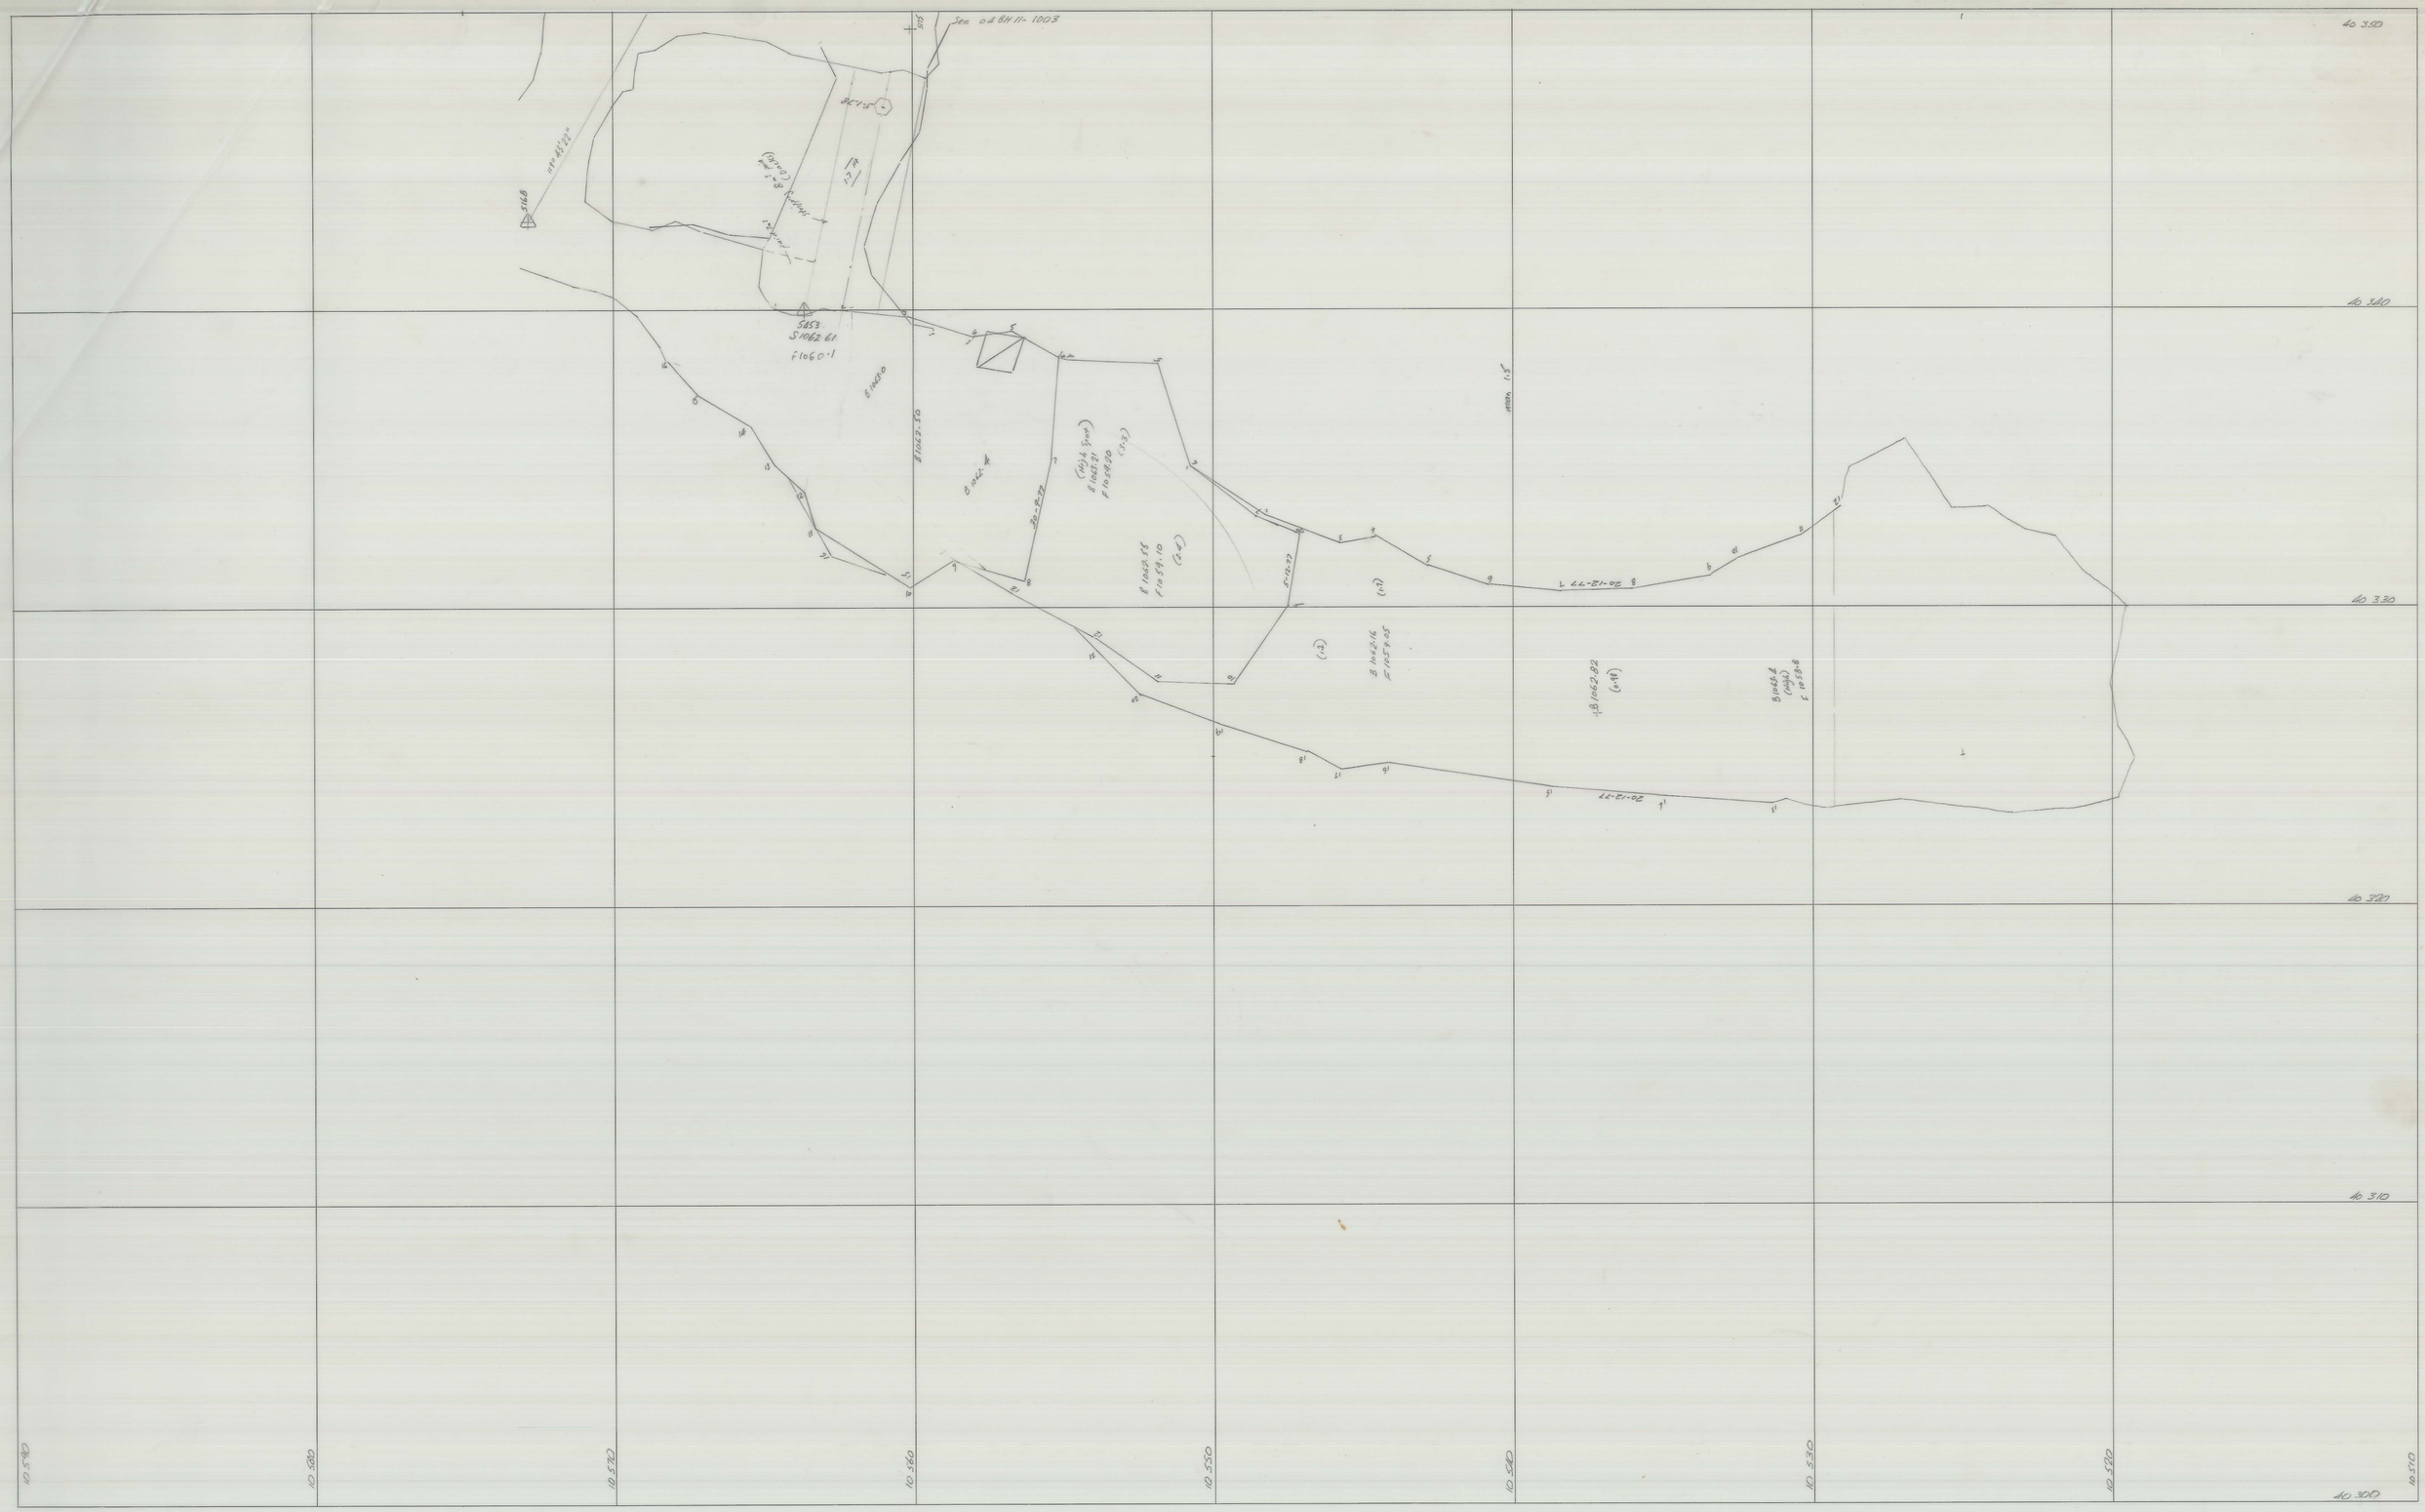

SCALE 1

north

LOCATION

SUBJECT

KING ISLAND SCHEELITE
A DIVISION OF WARMAN INTERNATIONAL

GRASSY KING ISLAND

PLAN NUMBER