5 cm

04BH11 147 220

043 STOPE

0374_4197

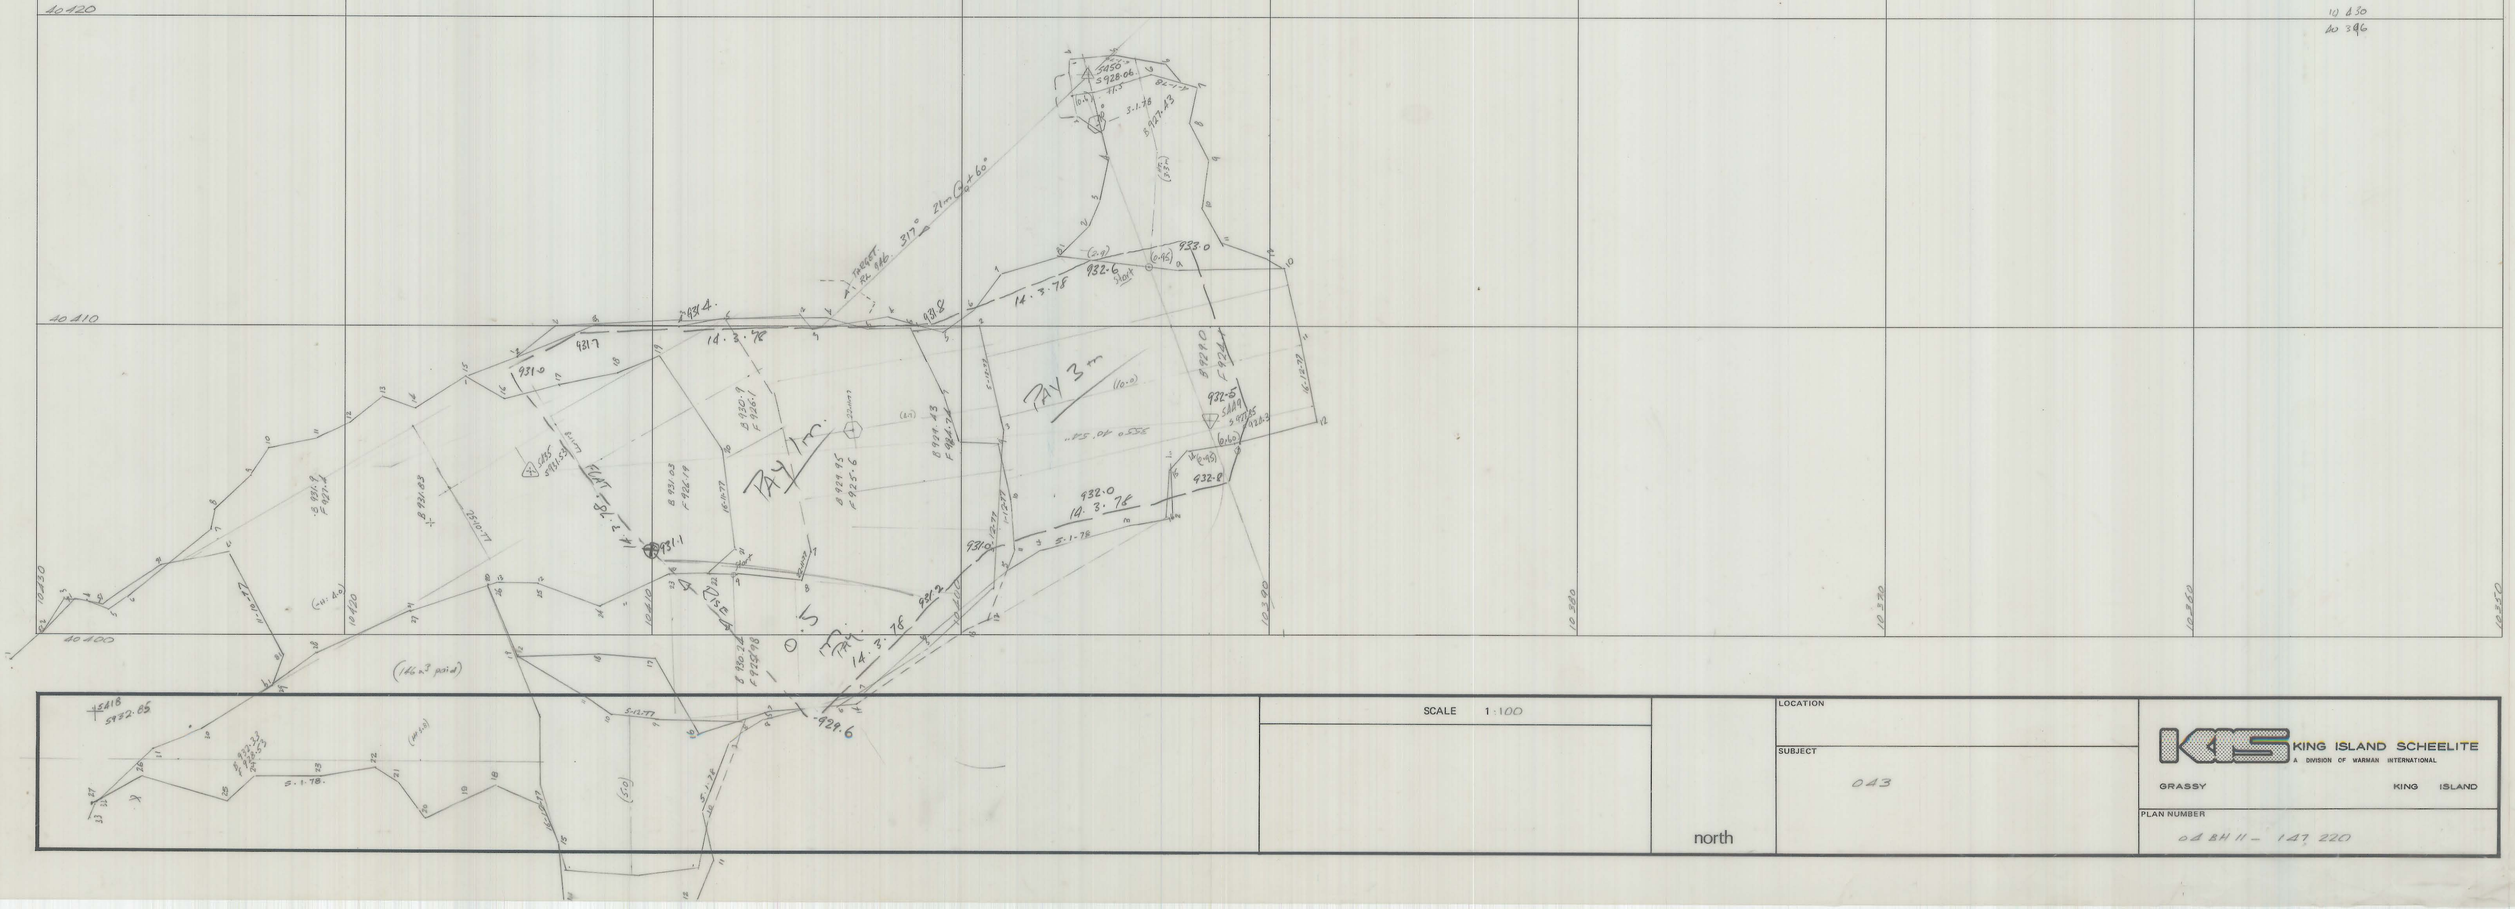

SCALE 1:100

north

LOCATION

SUBJECT

043

KING ISLAND SCHEELITE
A DIVISION OF WARMAN INTERNATIONAL

GRASSY KING ISLAND

PLAN NUMBER

04 BH 11 – 147 220