5 cm

0374 -4198

04 BH 11 1 A6 220

046

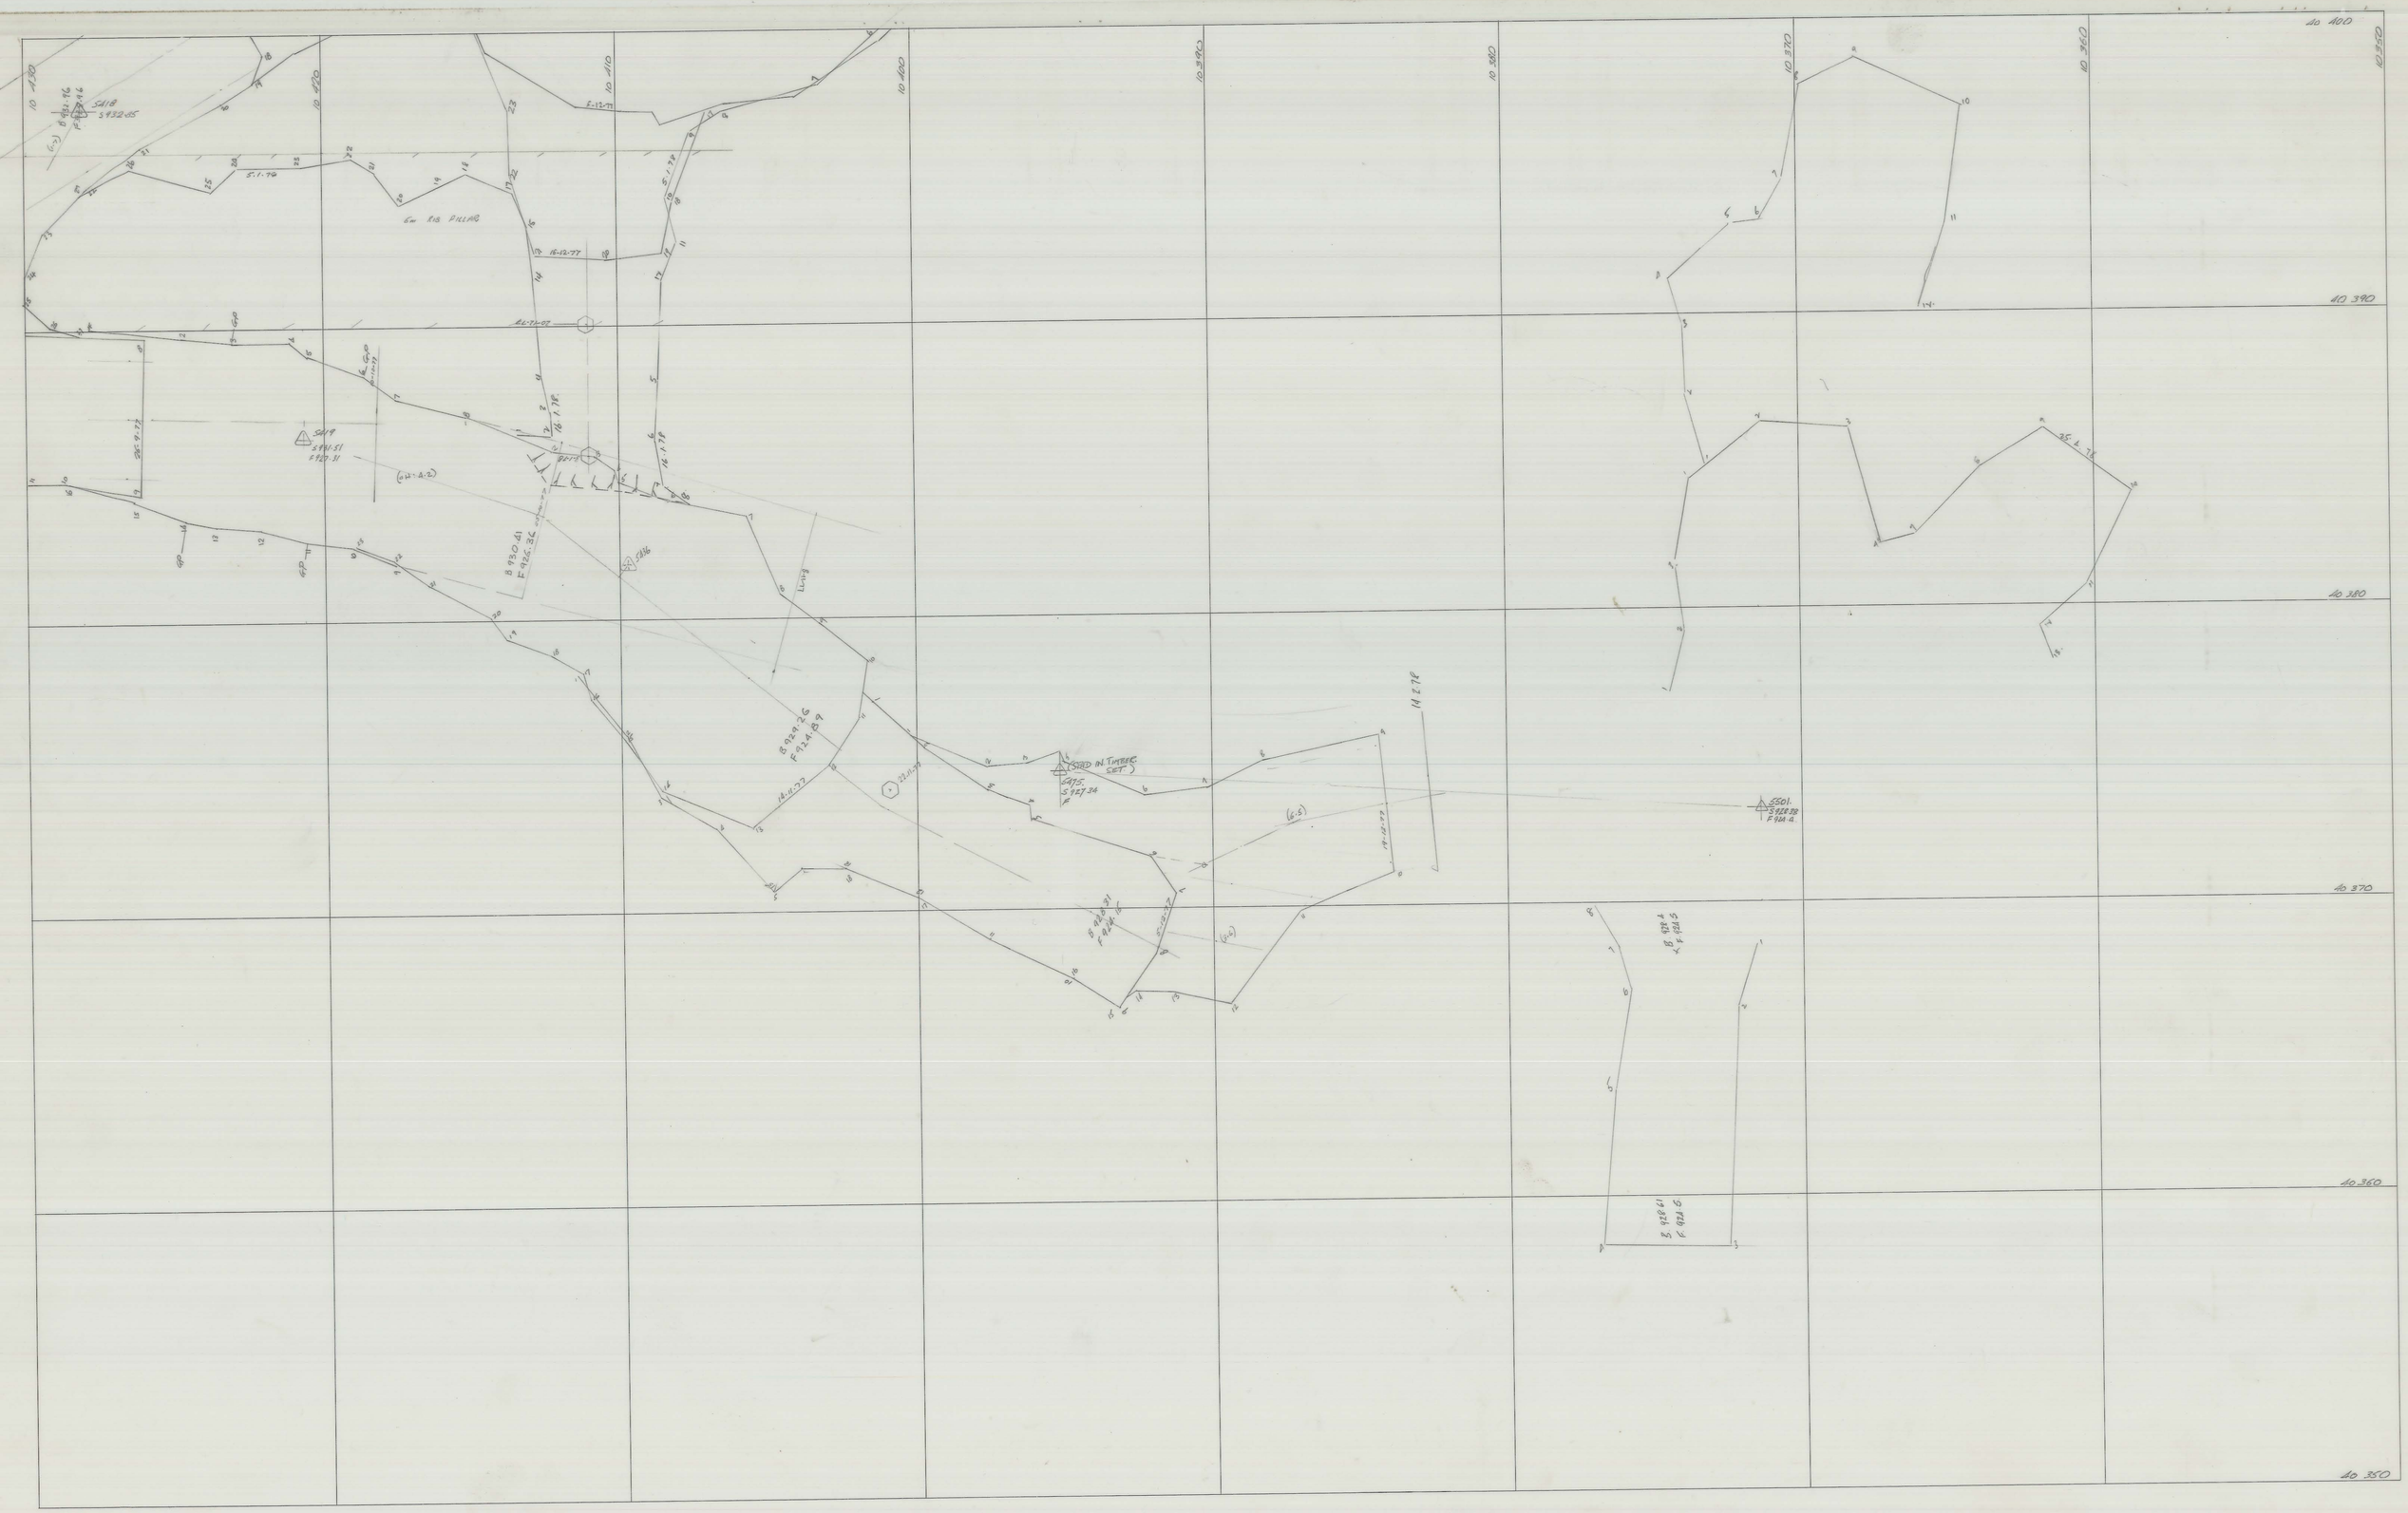

	SCALE 1	north	LOCATION
			SUBJECT
			KING ISLAND SCHEELITE — A DIVISION OF WARMAN INTERNATIONAL
			GRASSY KING ISLAND
			PLAN NUMBER