04 BH 11 - 1025
0374_4199

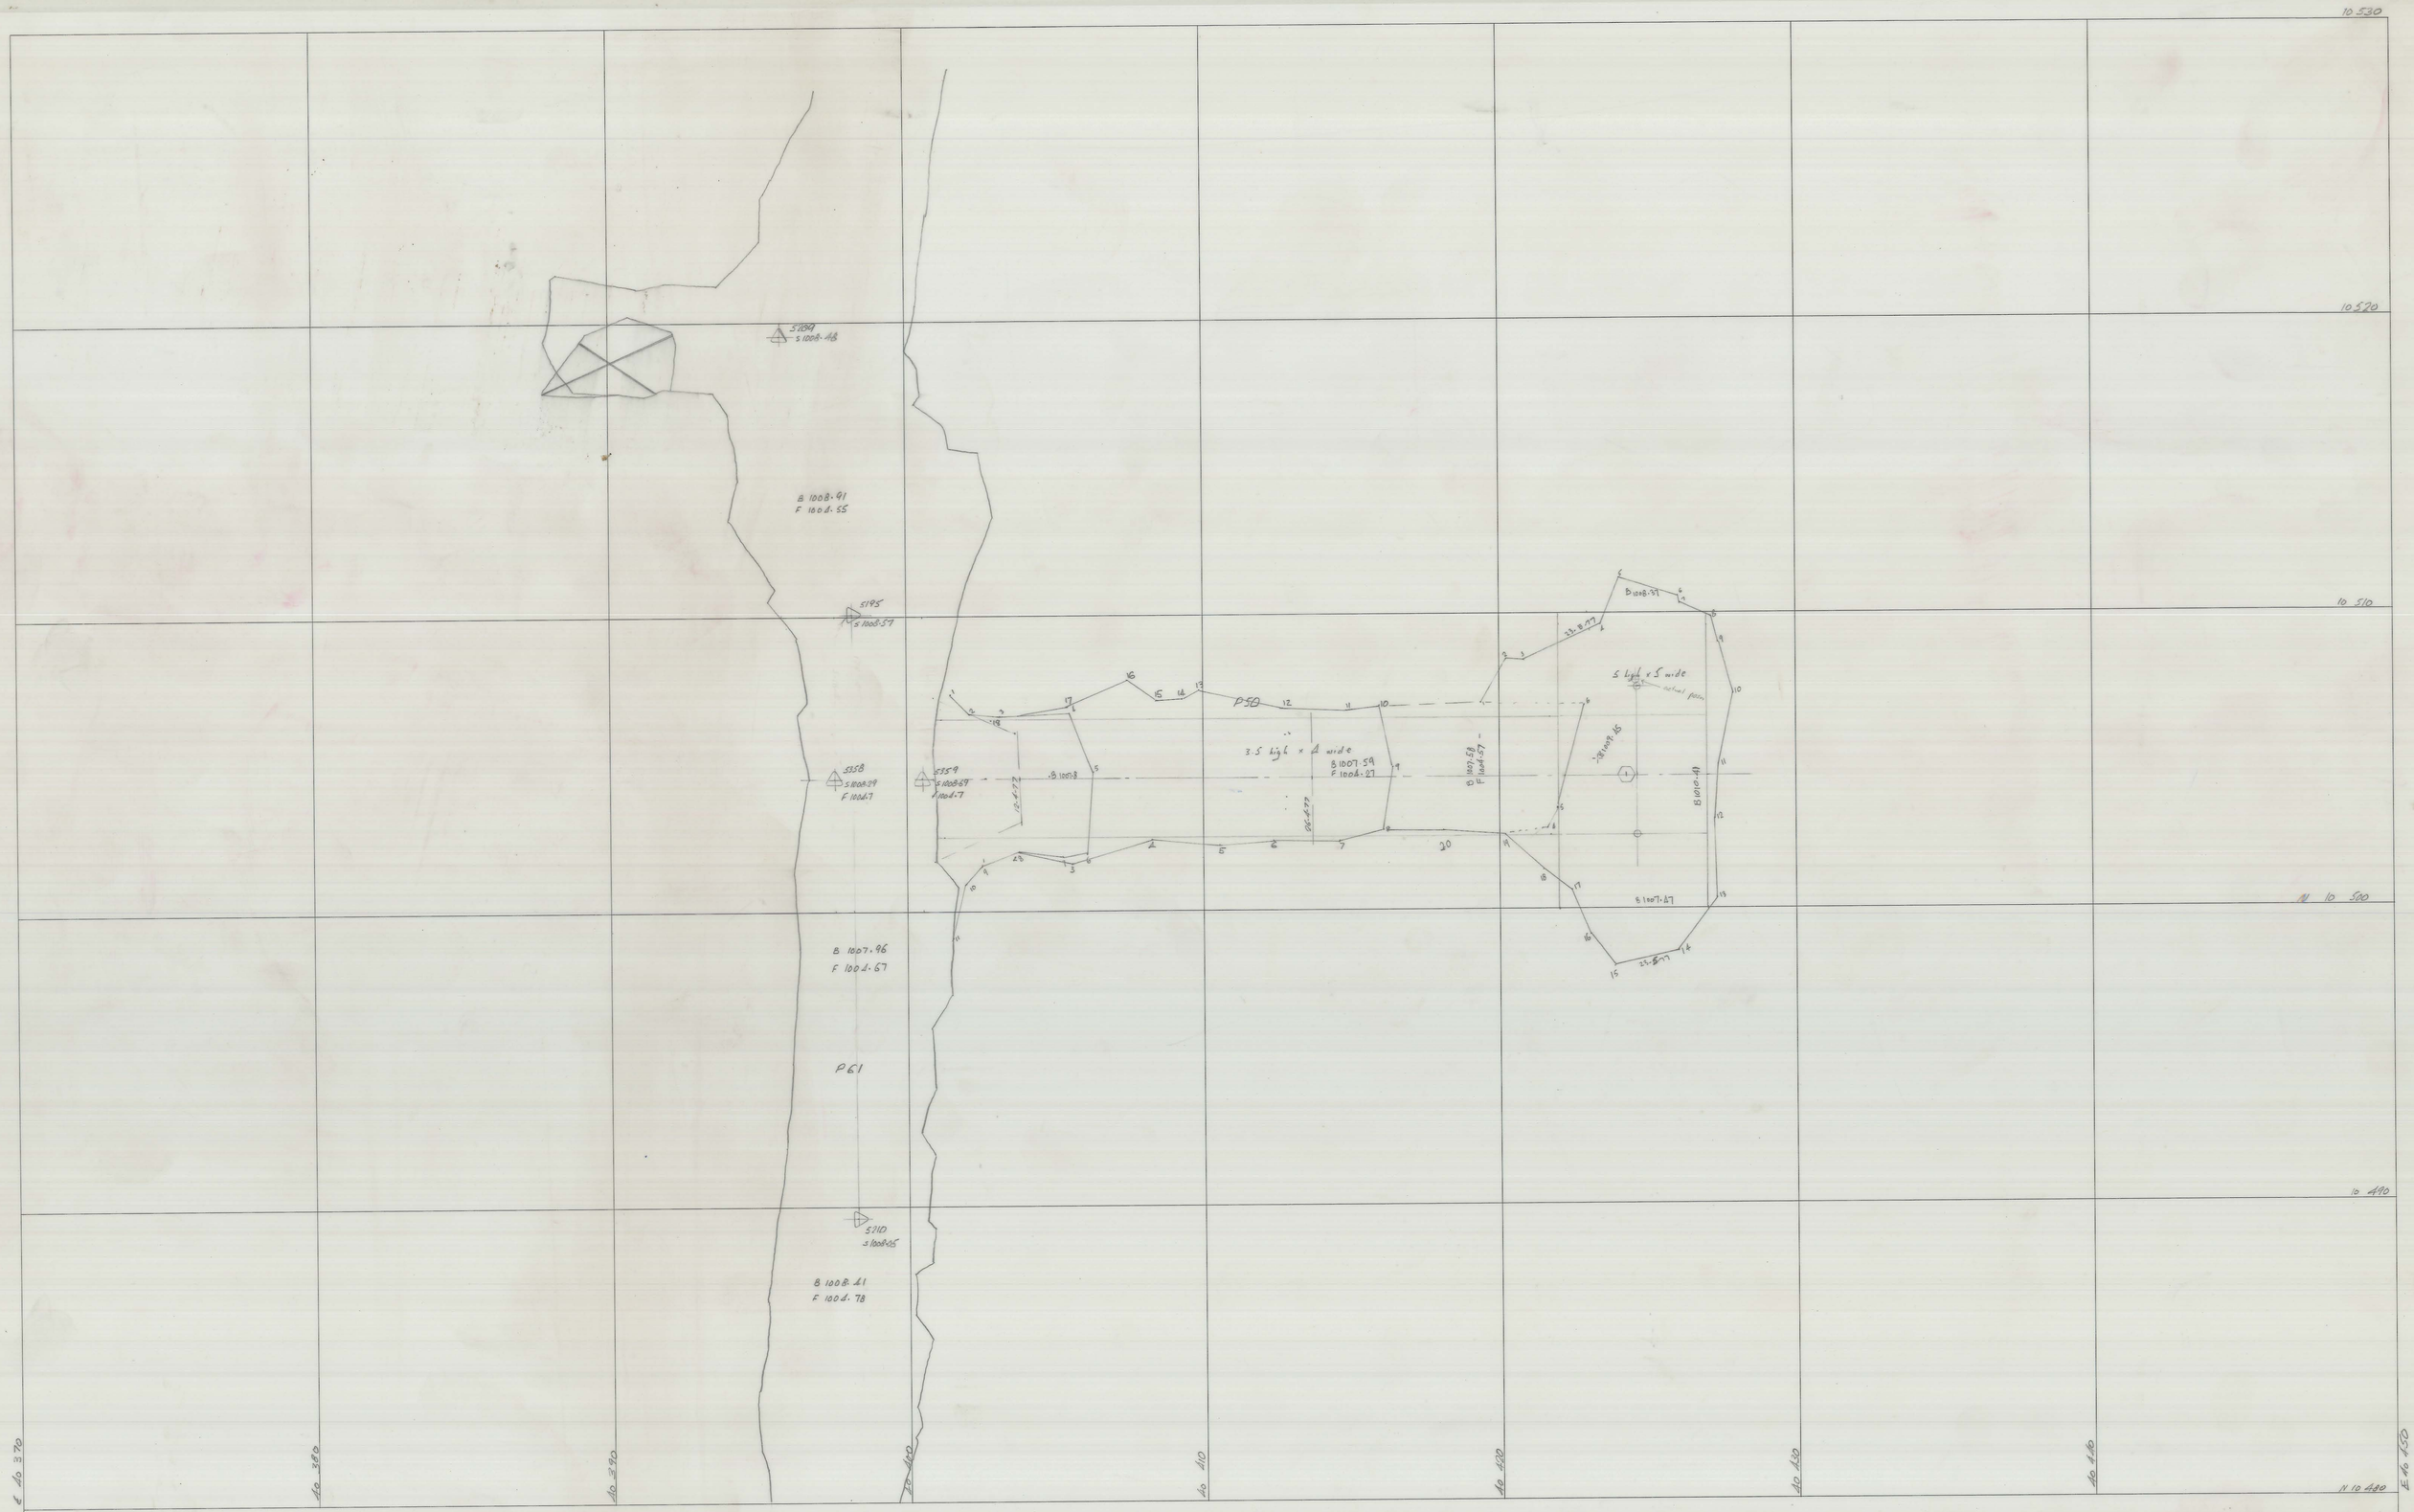

x. cut to Vent Raises

P50

M-23-3-77