5 cm

04 BH 11-1031

0374_4205

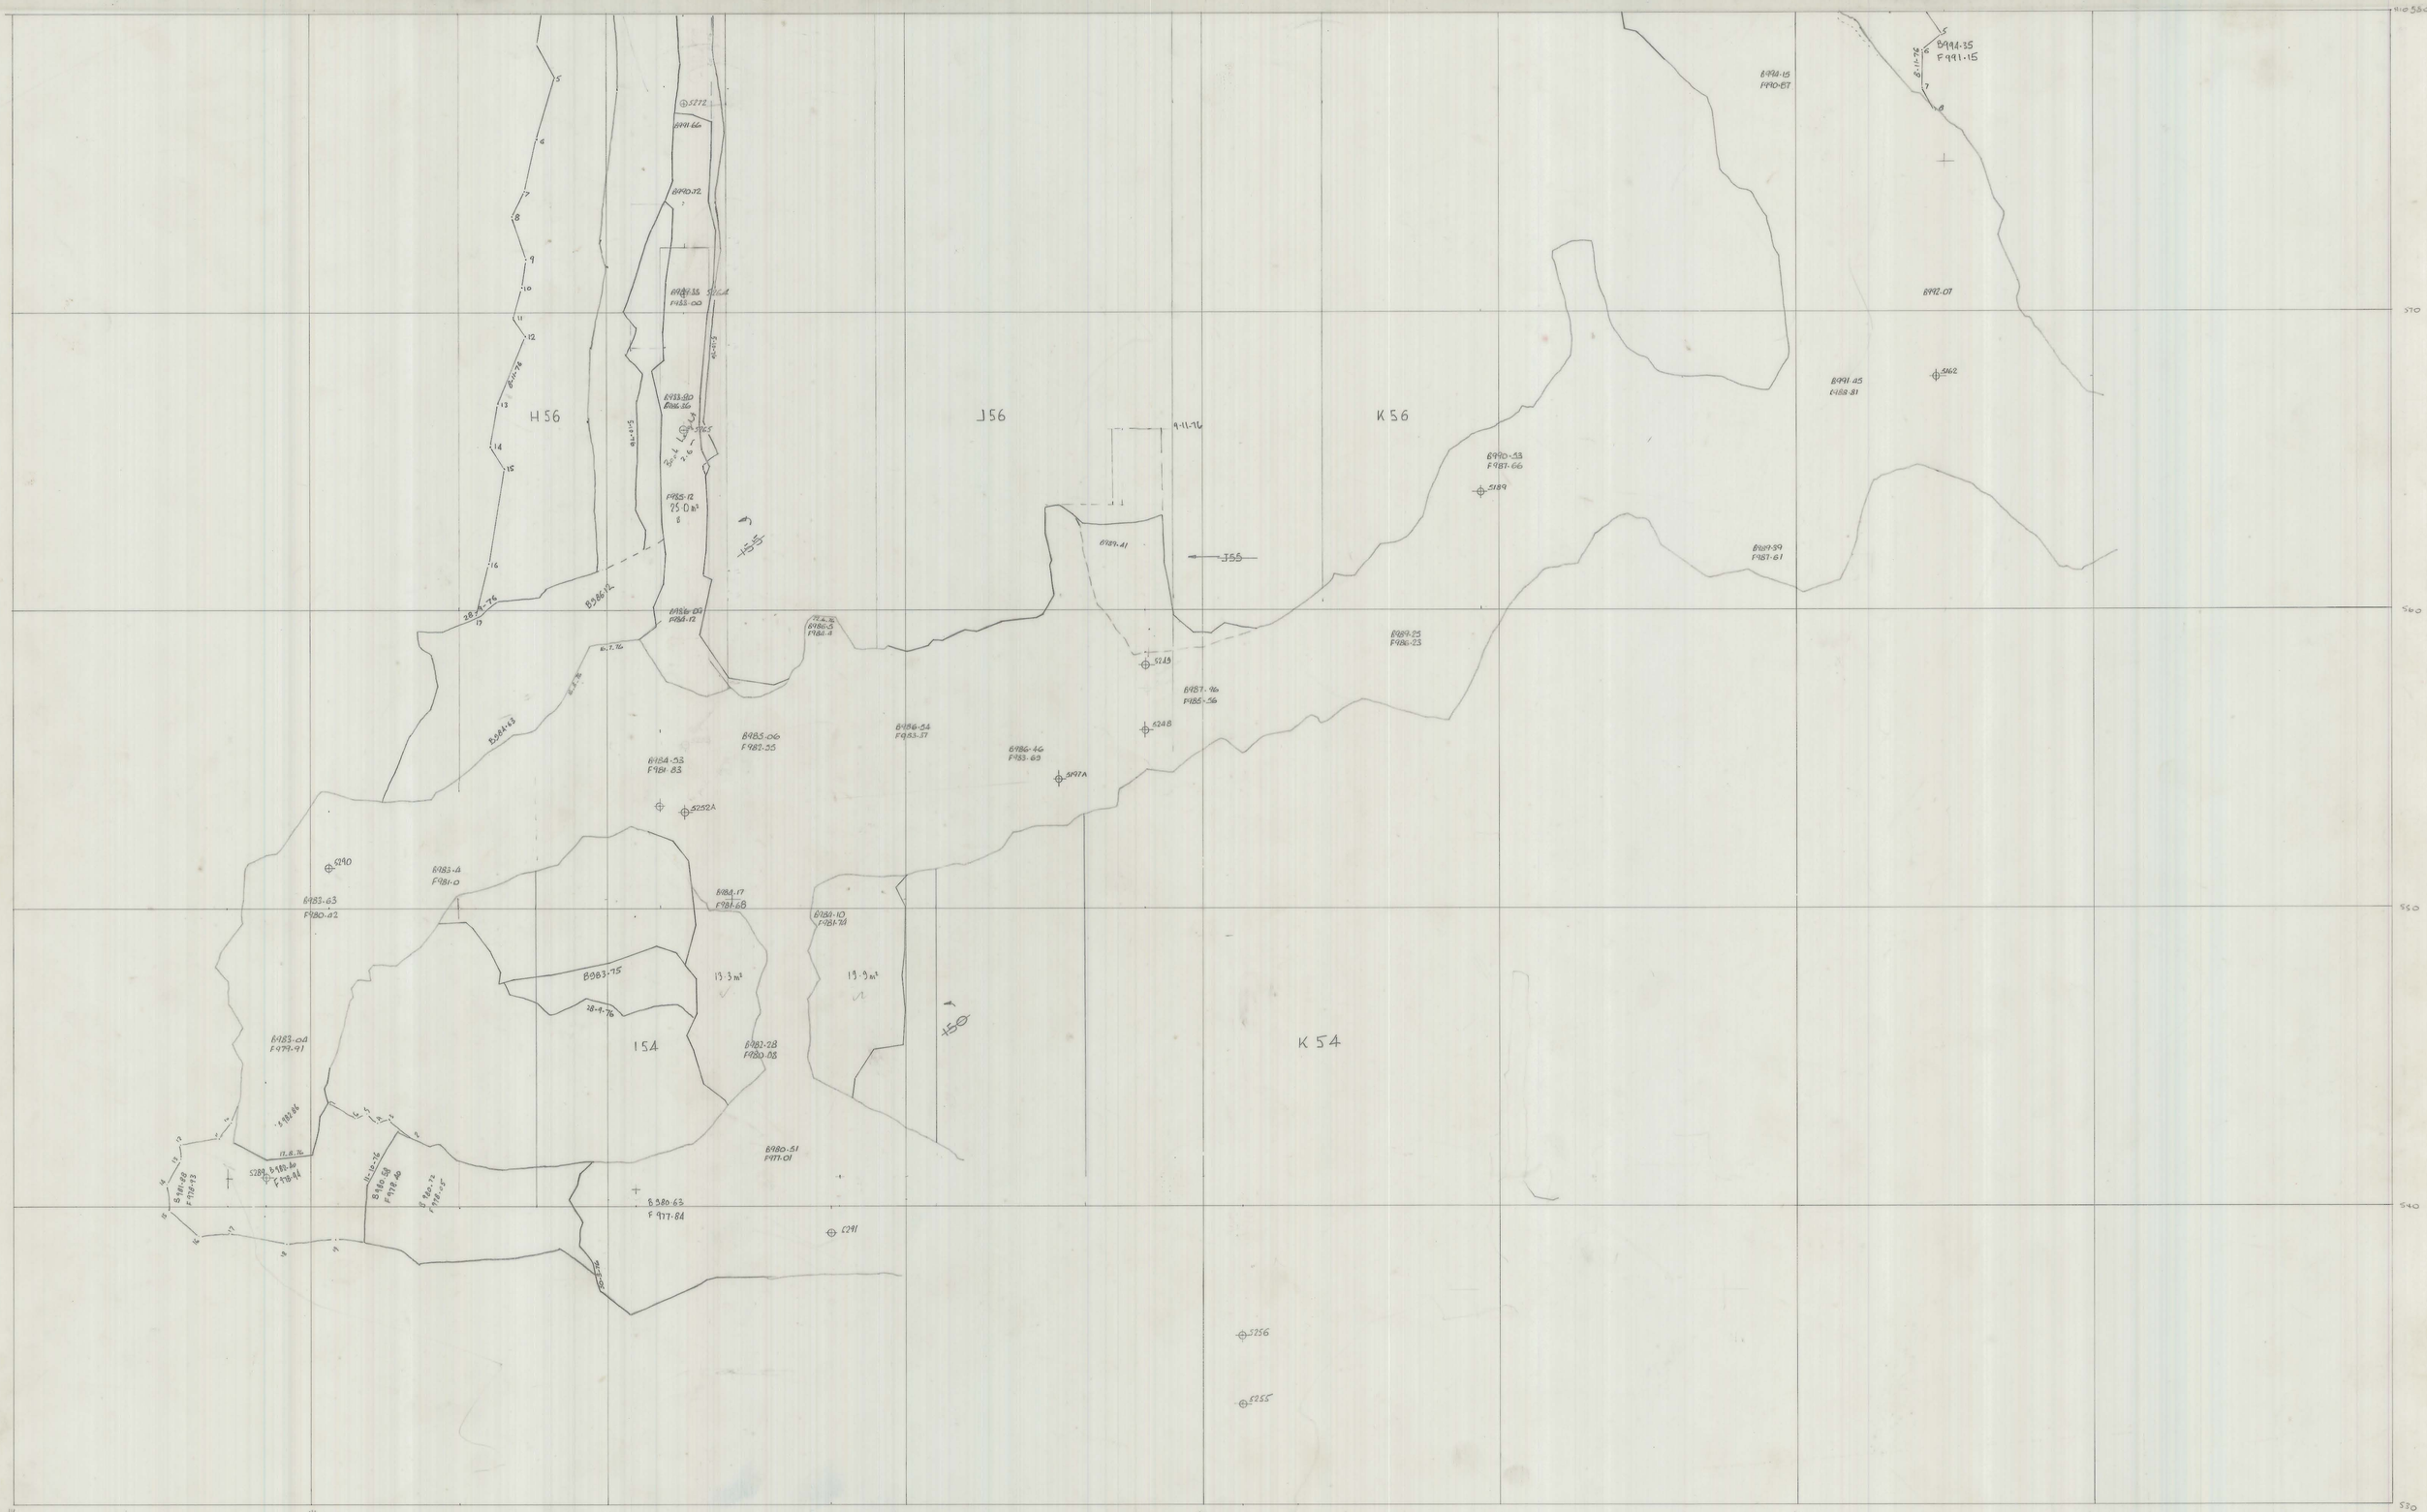

M-23-3-77