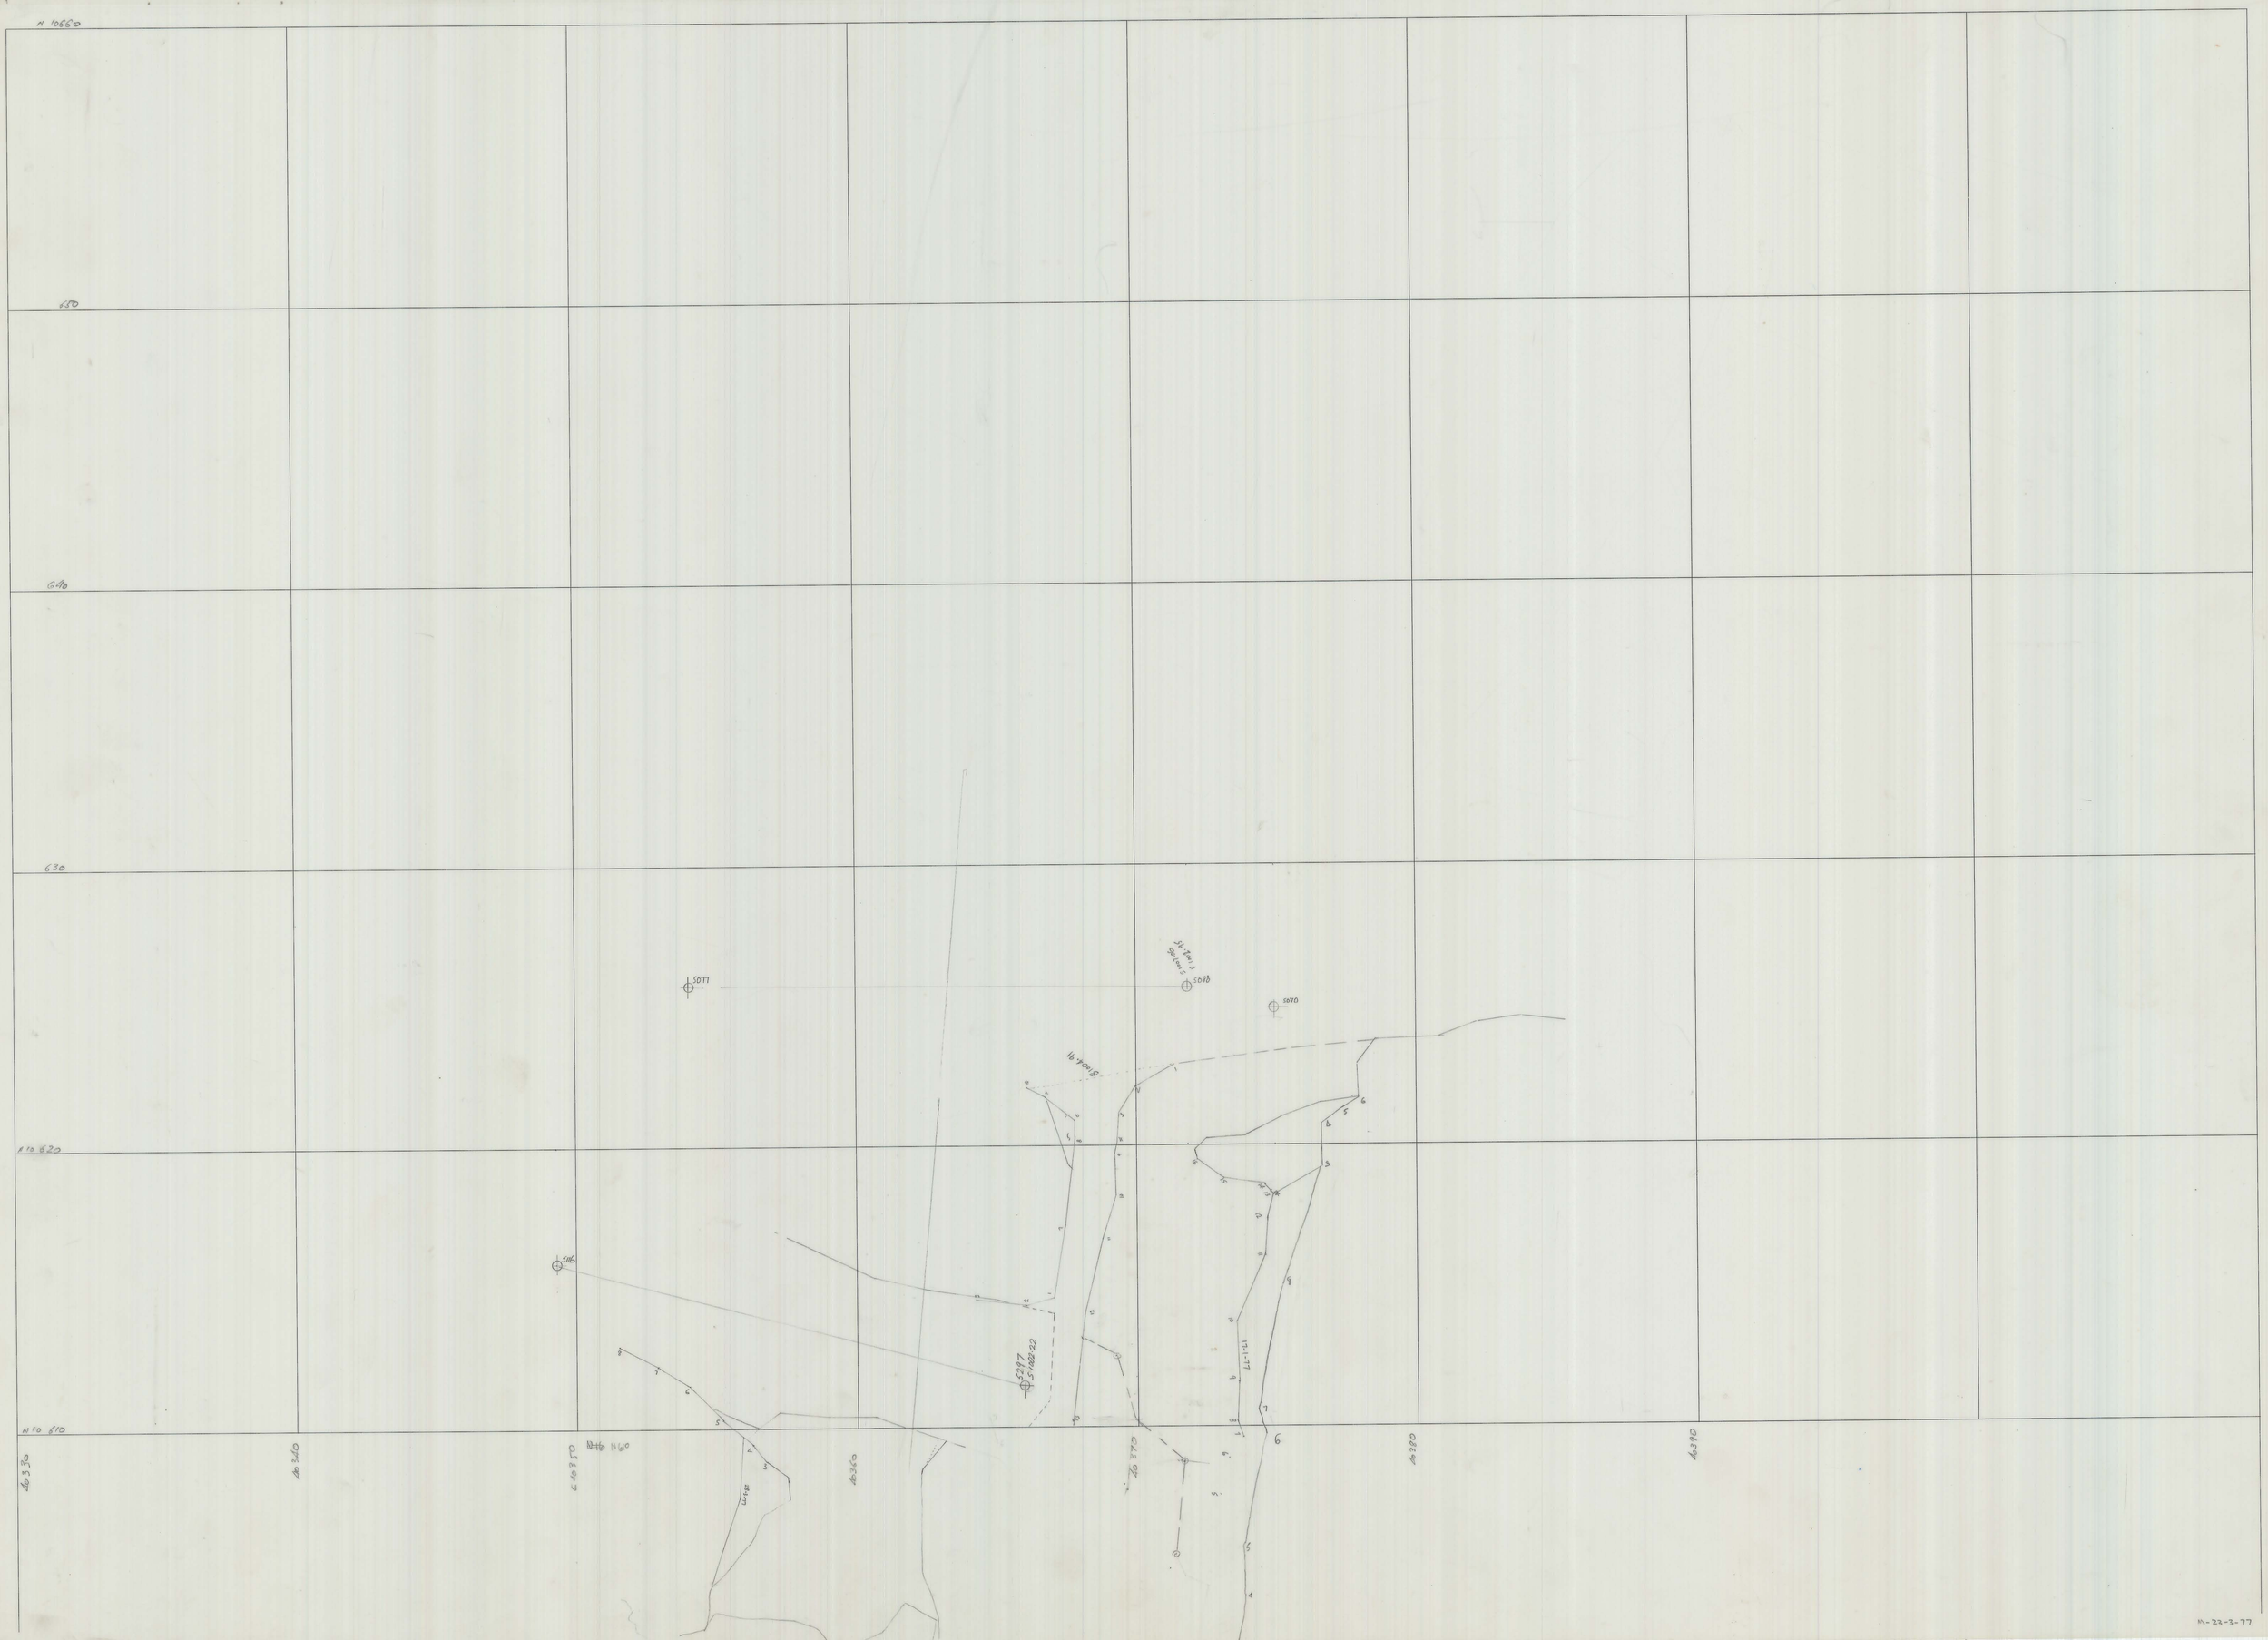5 cm
04BH11-1035
0374_4209