5 cm

0374_4215

DdBHII. 1.66. 156

N 54 Stope
2nd lift

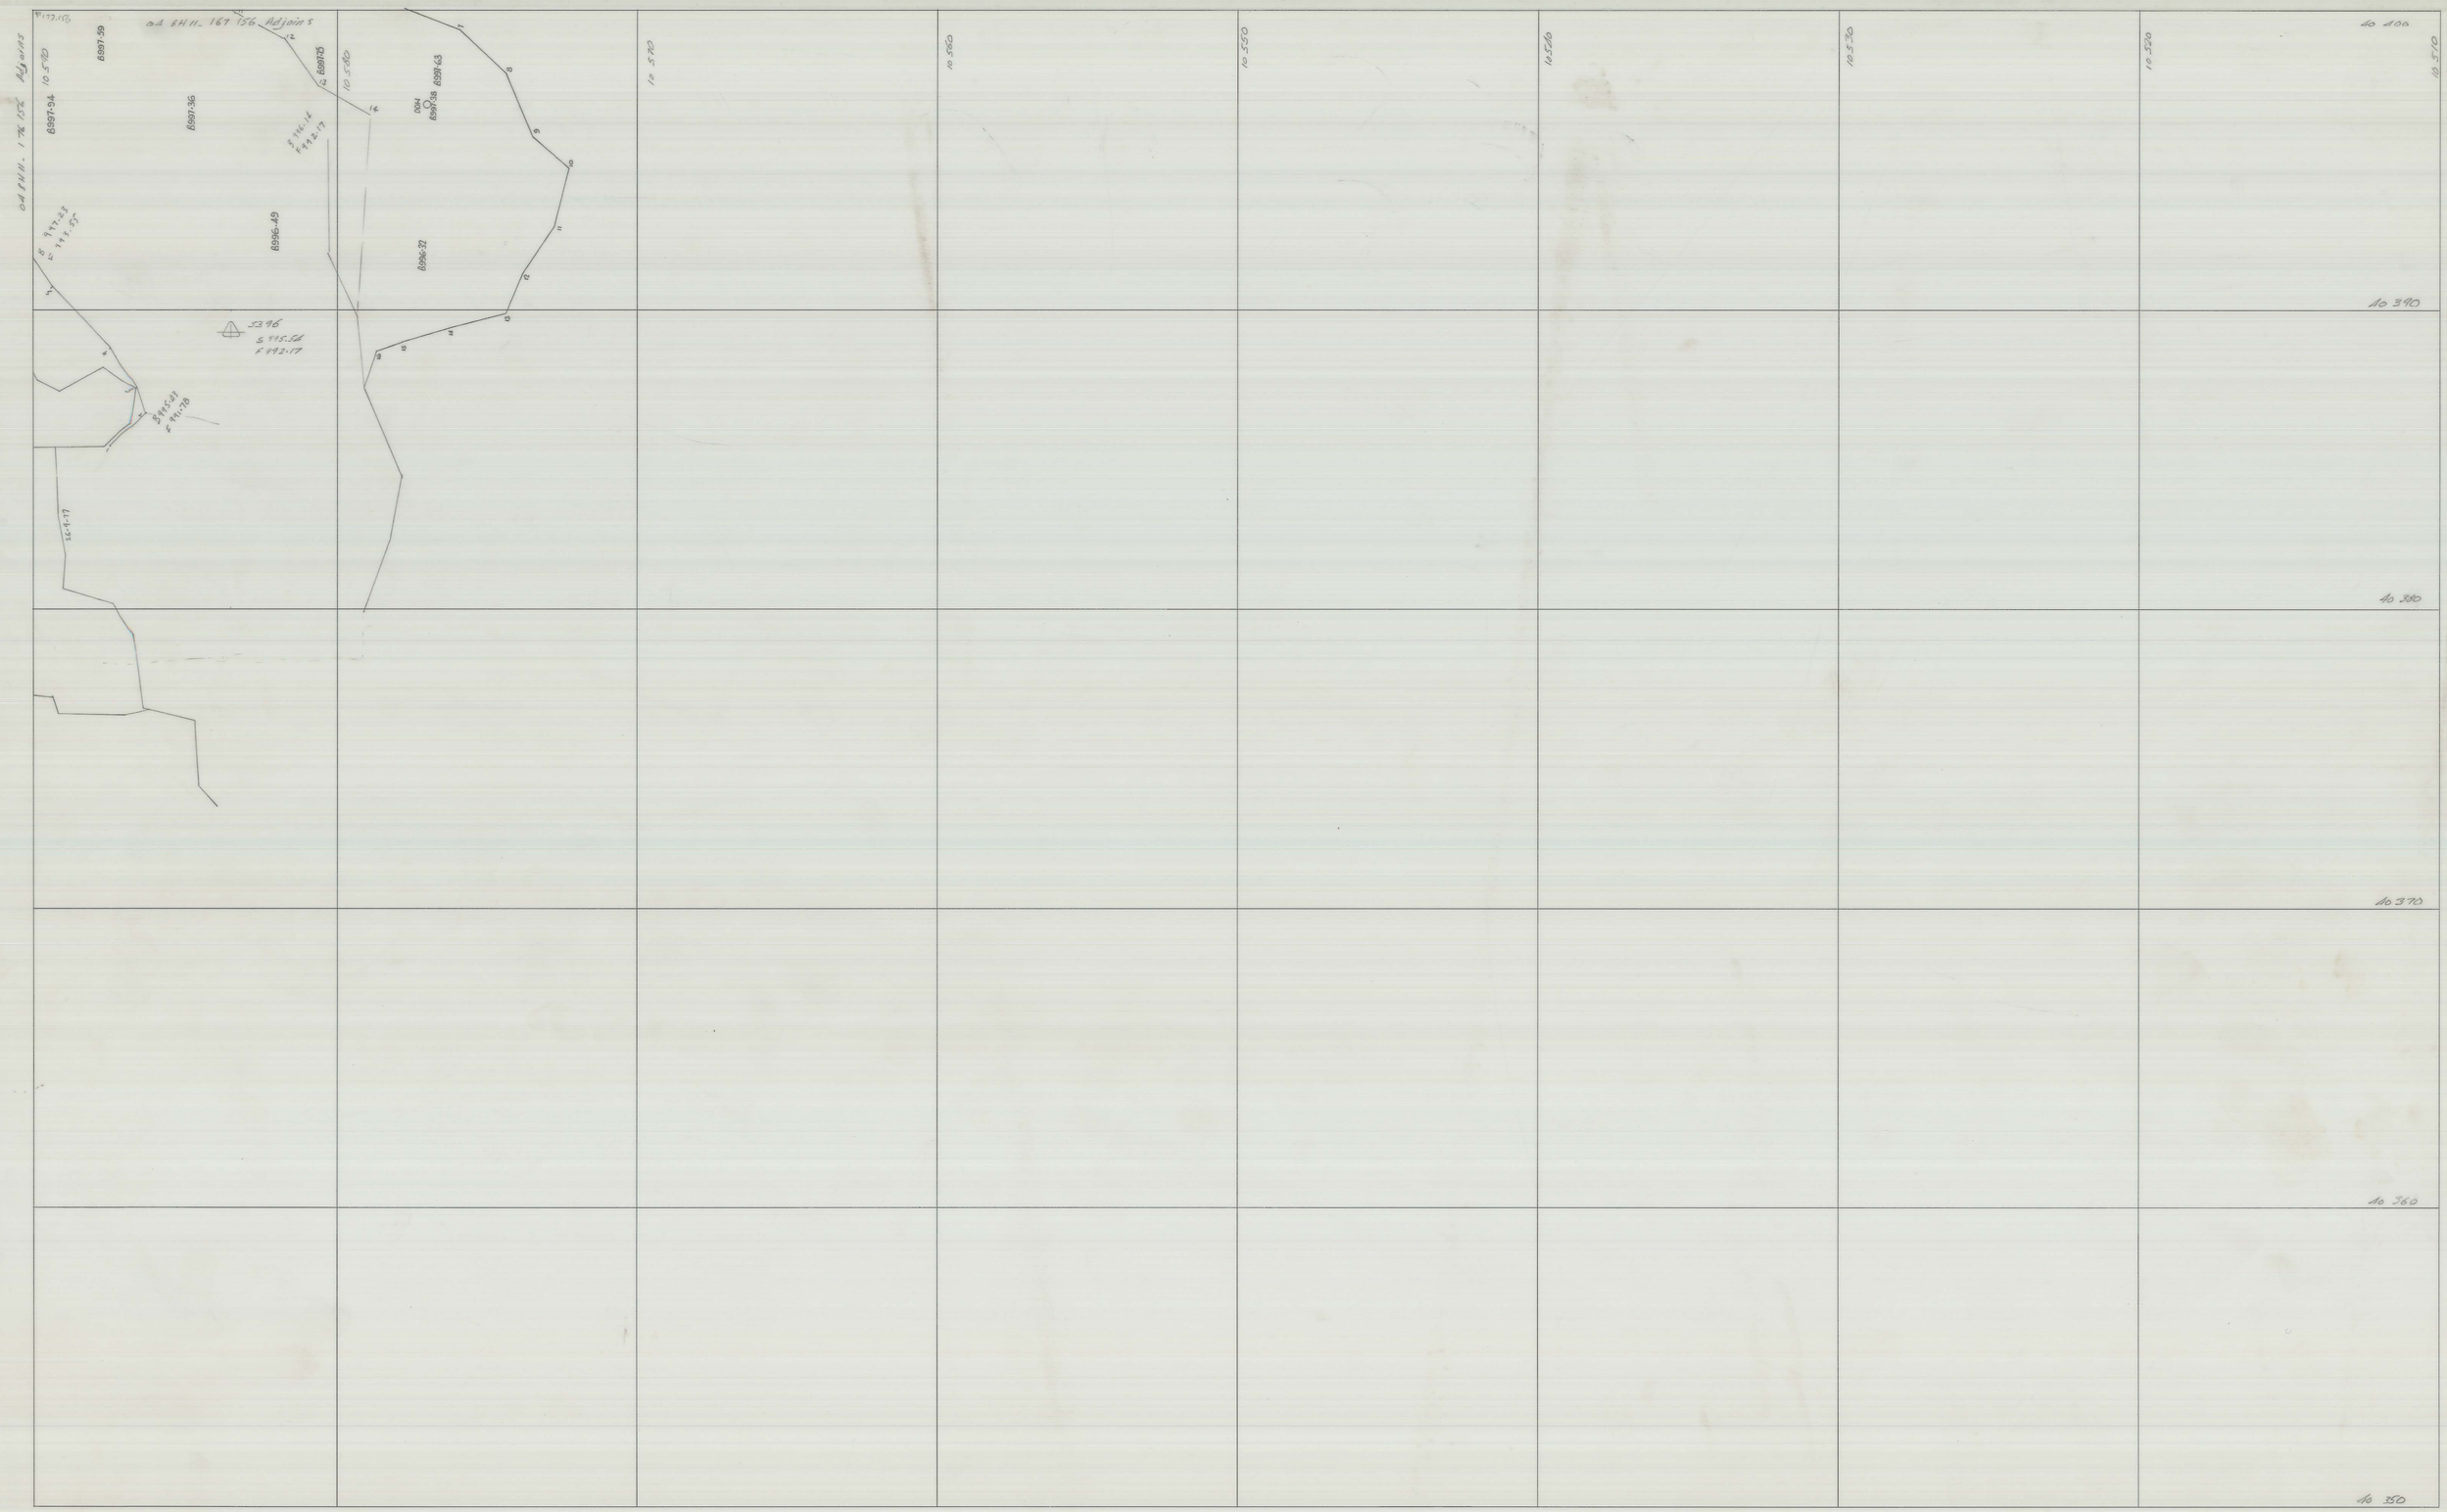

	SCALE 1	north	LOCATION
			SUBJECT
			KING ISLAND SCHEELITE — A DIVISION OF WARMAN INTERNATIONAL
			GRASSY — KING ISLAND
			PLAN NUMBER