5 cm

OA BH 11 _ 1051

0374_4221

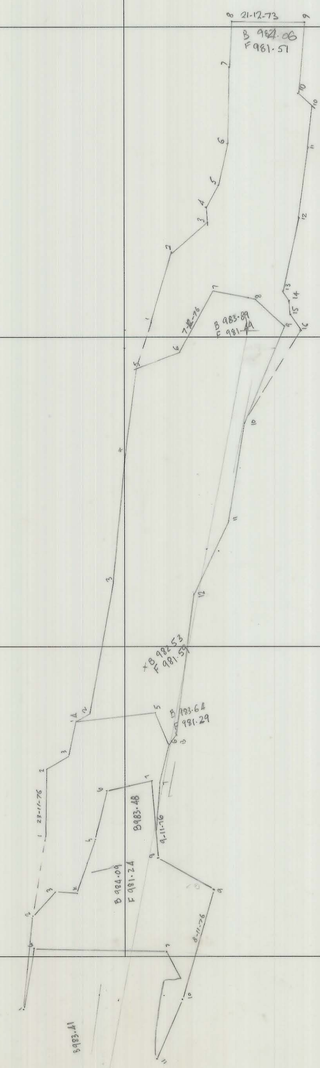

N5Δ STORE