27 JUN 1981

5 cm

04BH12 - 155 246

0374_4227

F47 u/cut
K44

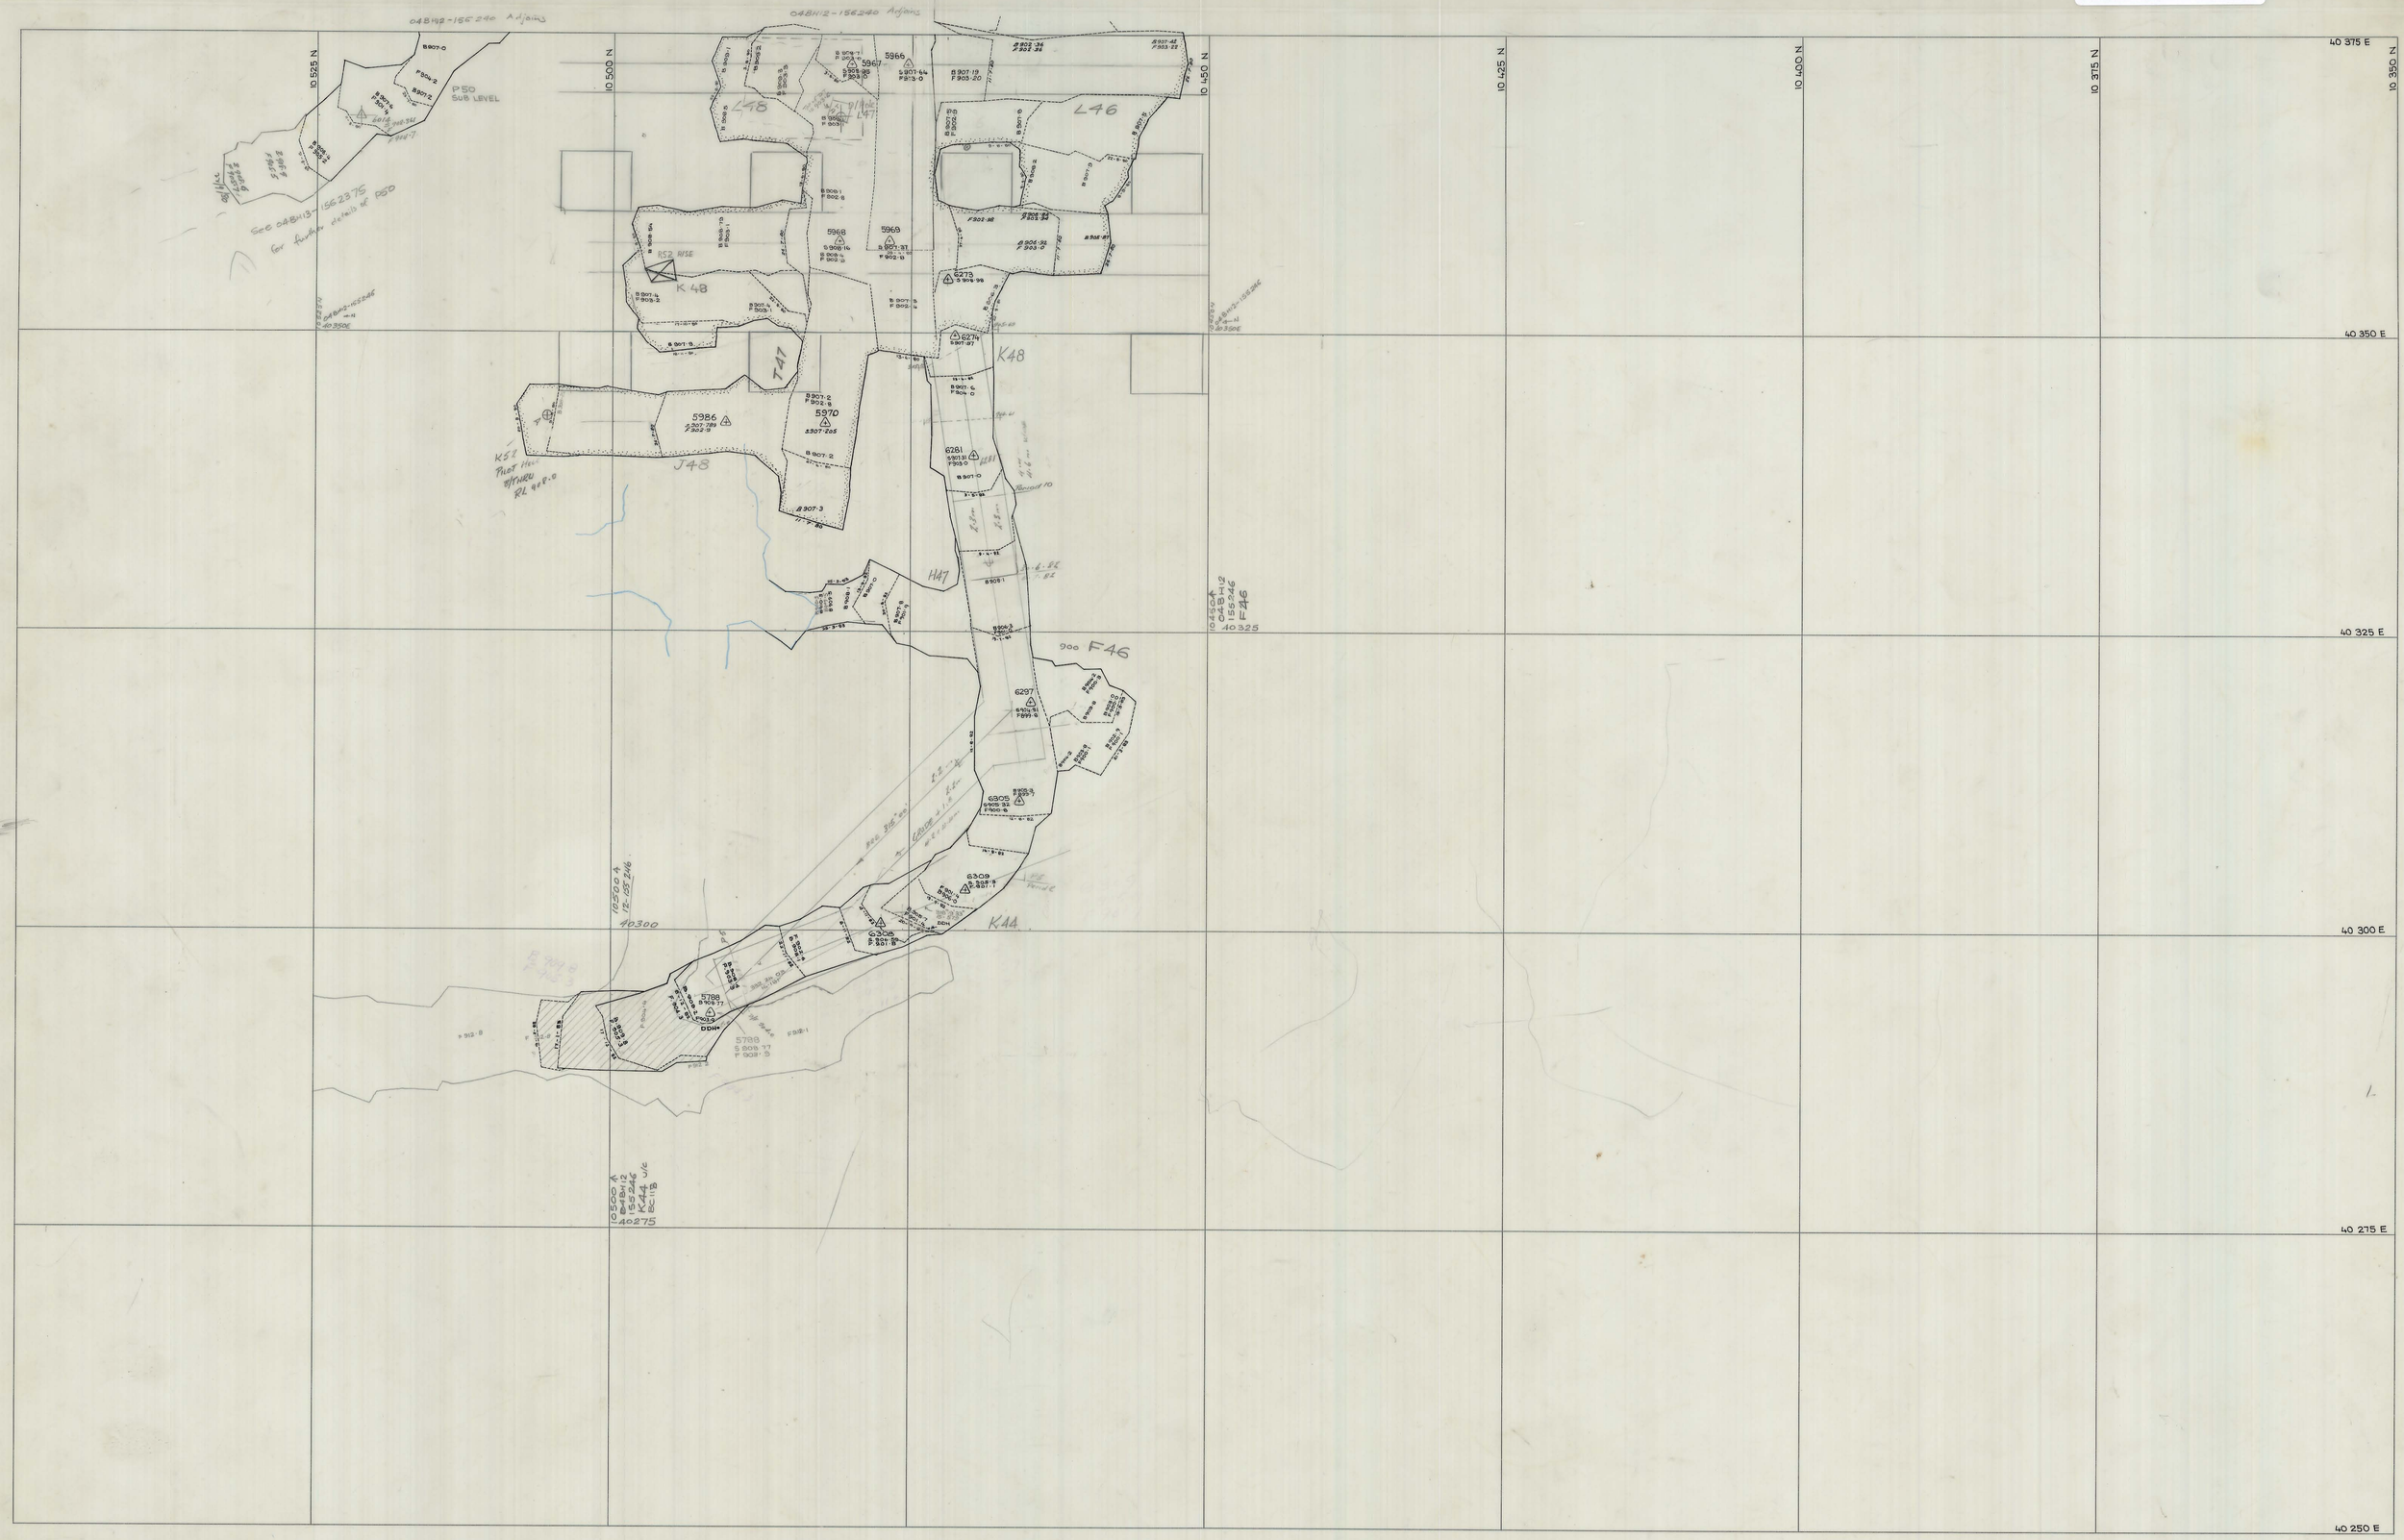

	SCALE 1:250	north	LOCATION: BOLD HEAD MINE
			SUBJECT: ACCESS TO C1 LENS OREBODY
			KING ISLAND SCHEELITE — A DIVISION OF WARMAN INTERNATIONAL — GRASSY KING ISLAND
			PLAN NUMBER: 04BH12 - 155 246