5 cm

04BH12-155235

0374_4229

F53 drive
Access to
C Lens West
(K44 stope)

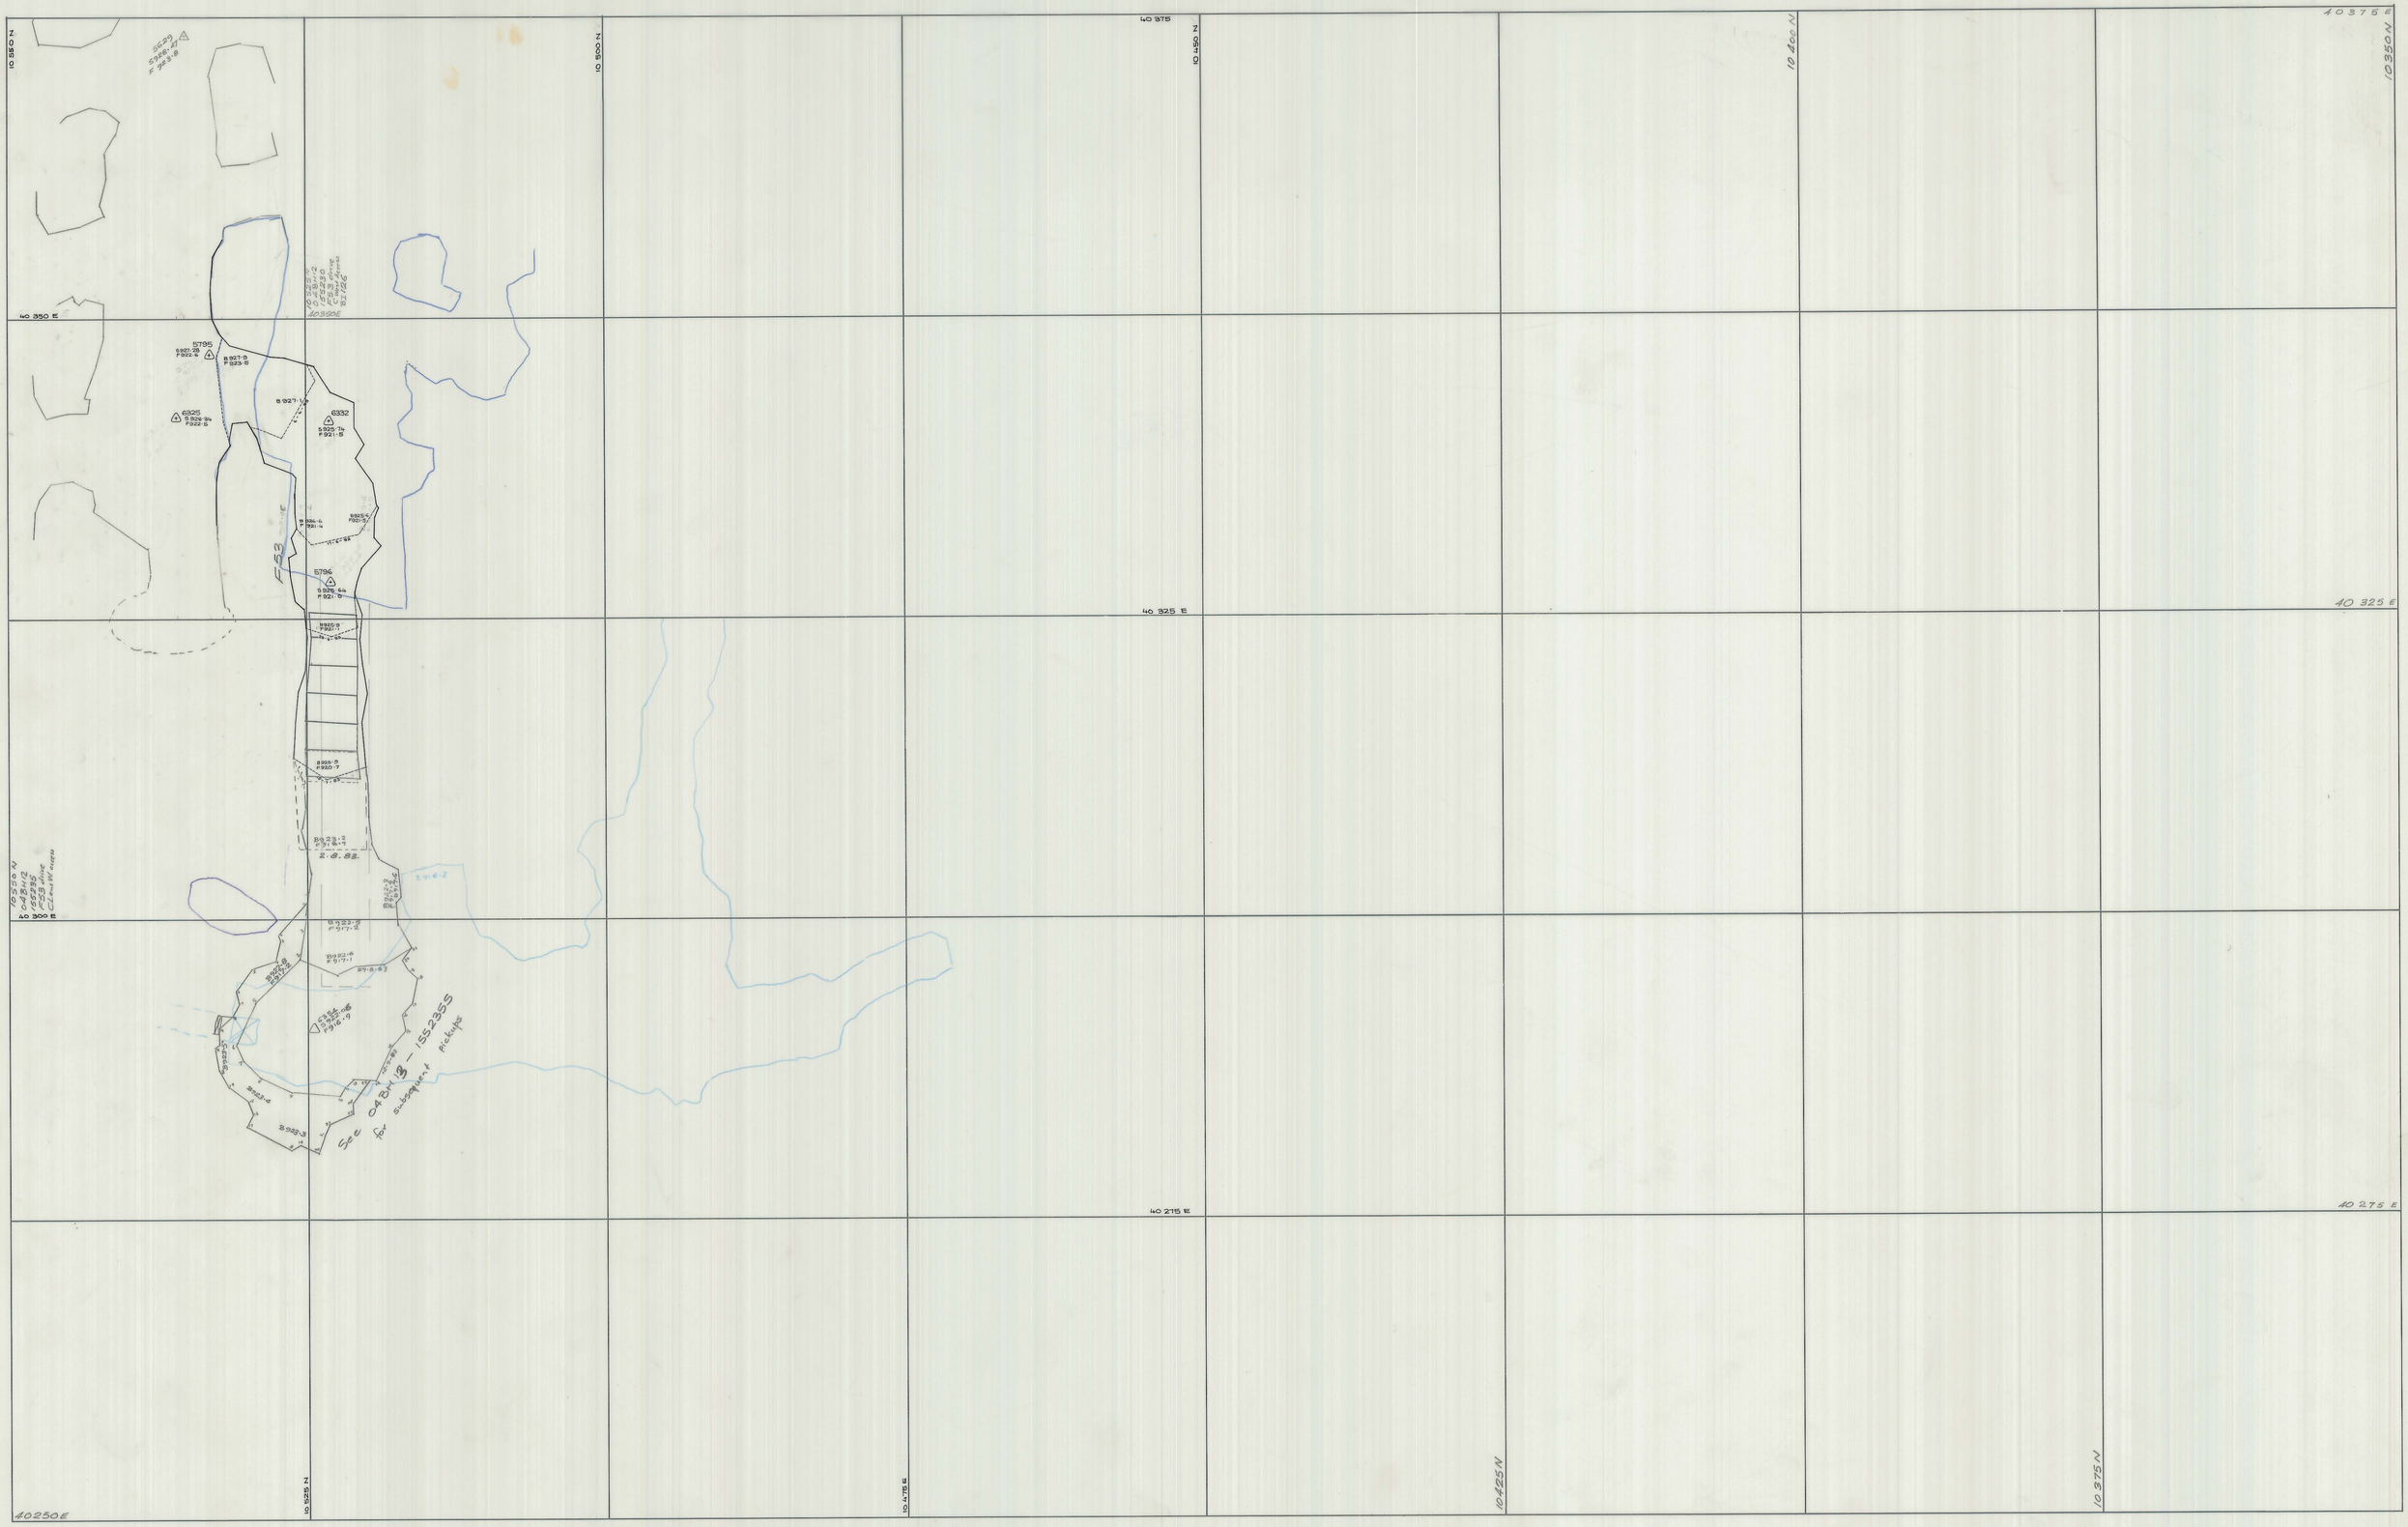

SCALE 1:250

north

LOCATION
BOLD HEAD MINE

SUBJECT
F53 DRIVE
C LENS WEST [K44 STOPE] ACCESS

KING ISLAND SCHEELITE
A DIVISION OF WARMAN INTERNATIONAL

GRASSY KING ISLAND

PLAN NUMBER
04BH12 - 155 235