5 cm

0374_4232

04 BH 11_166 182

L54
L55

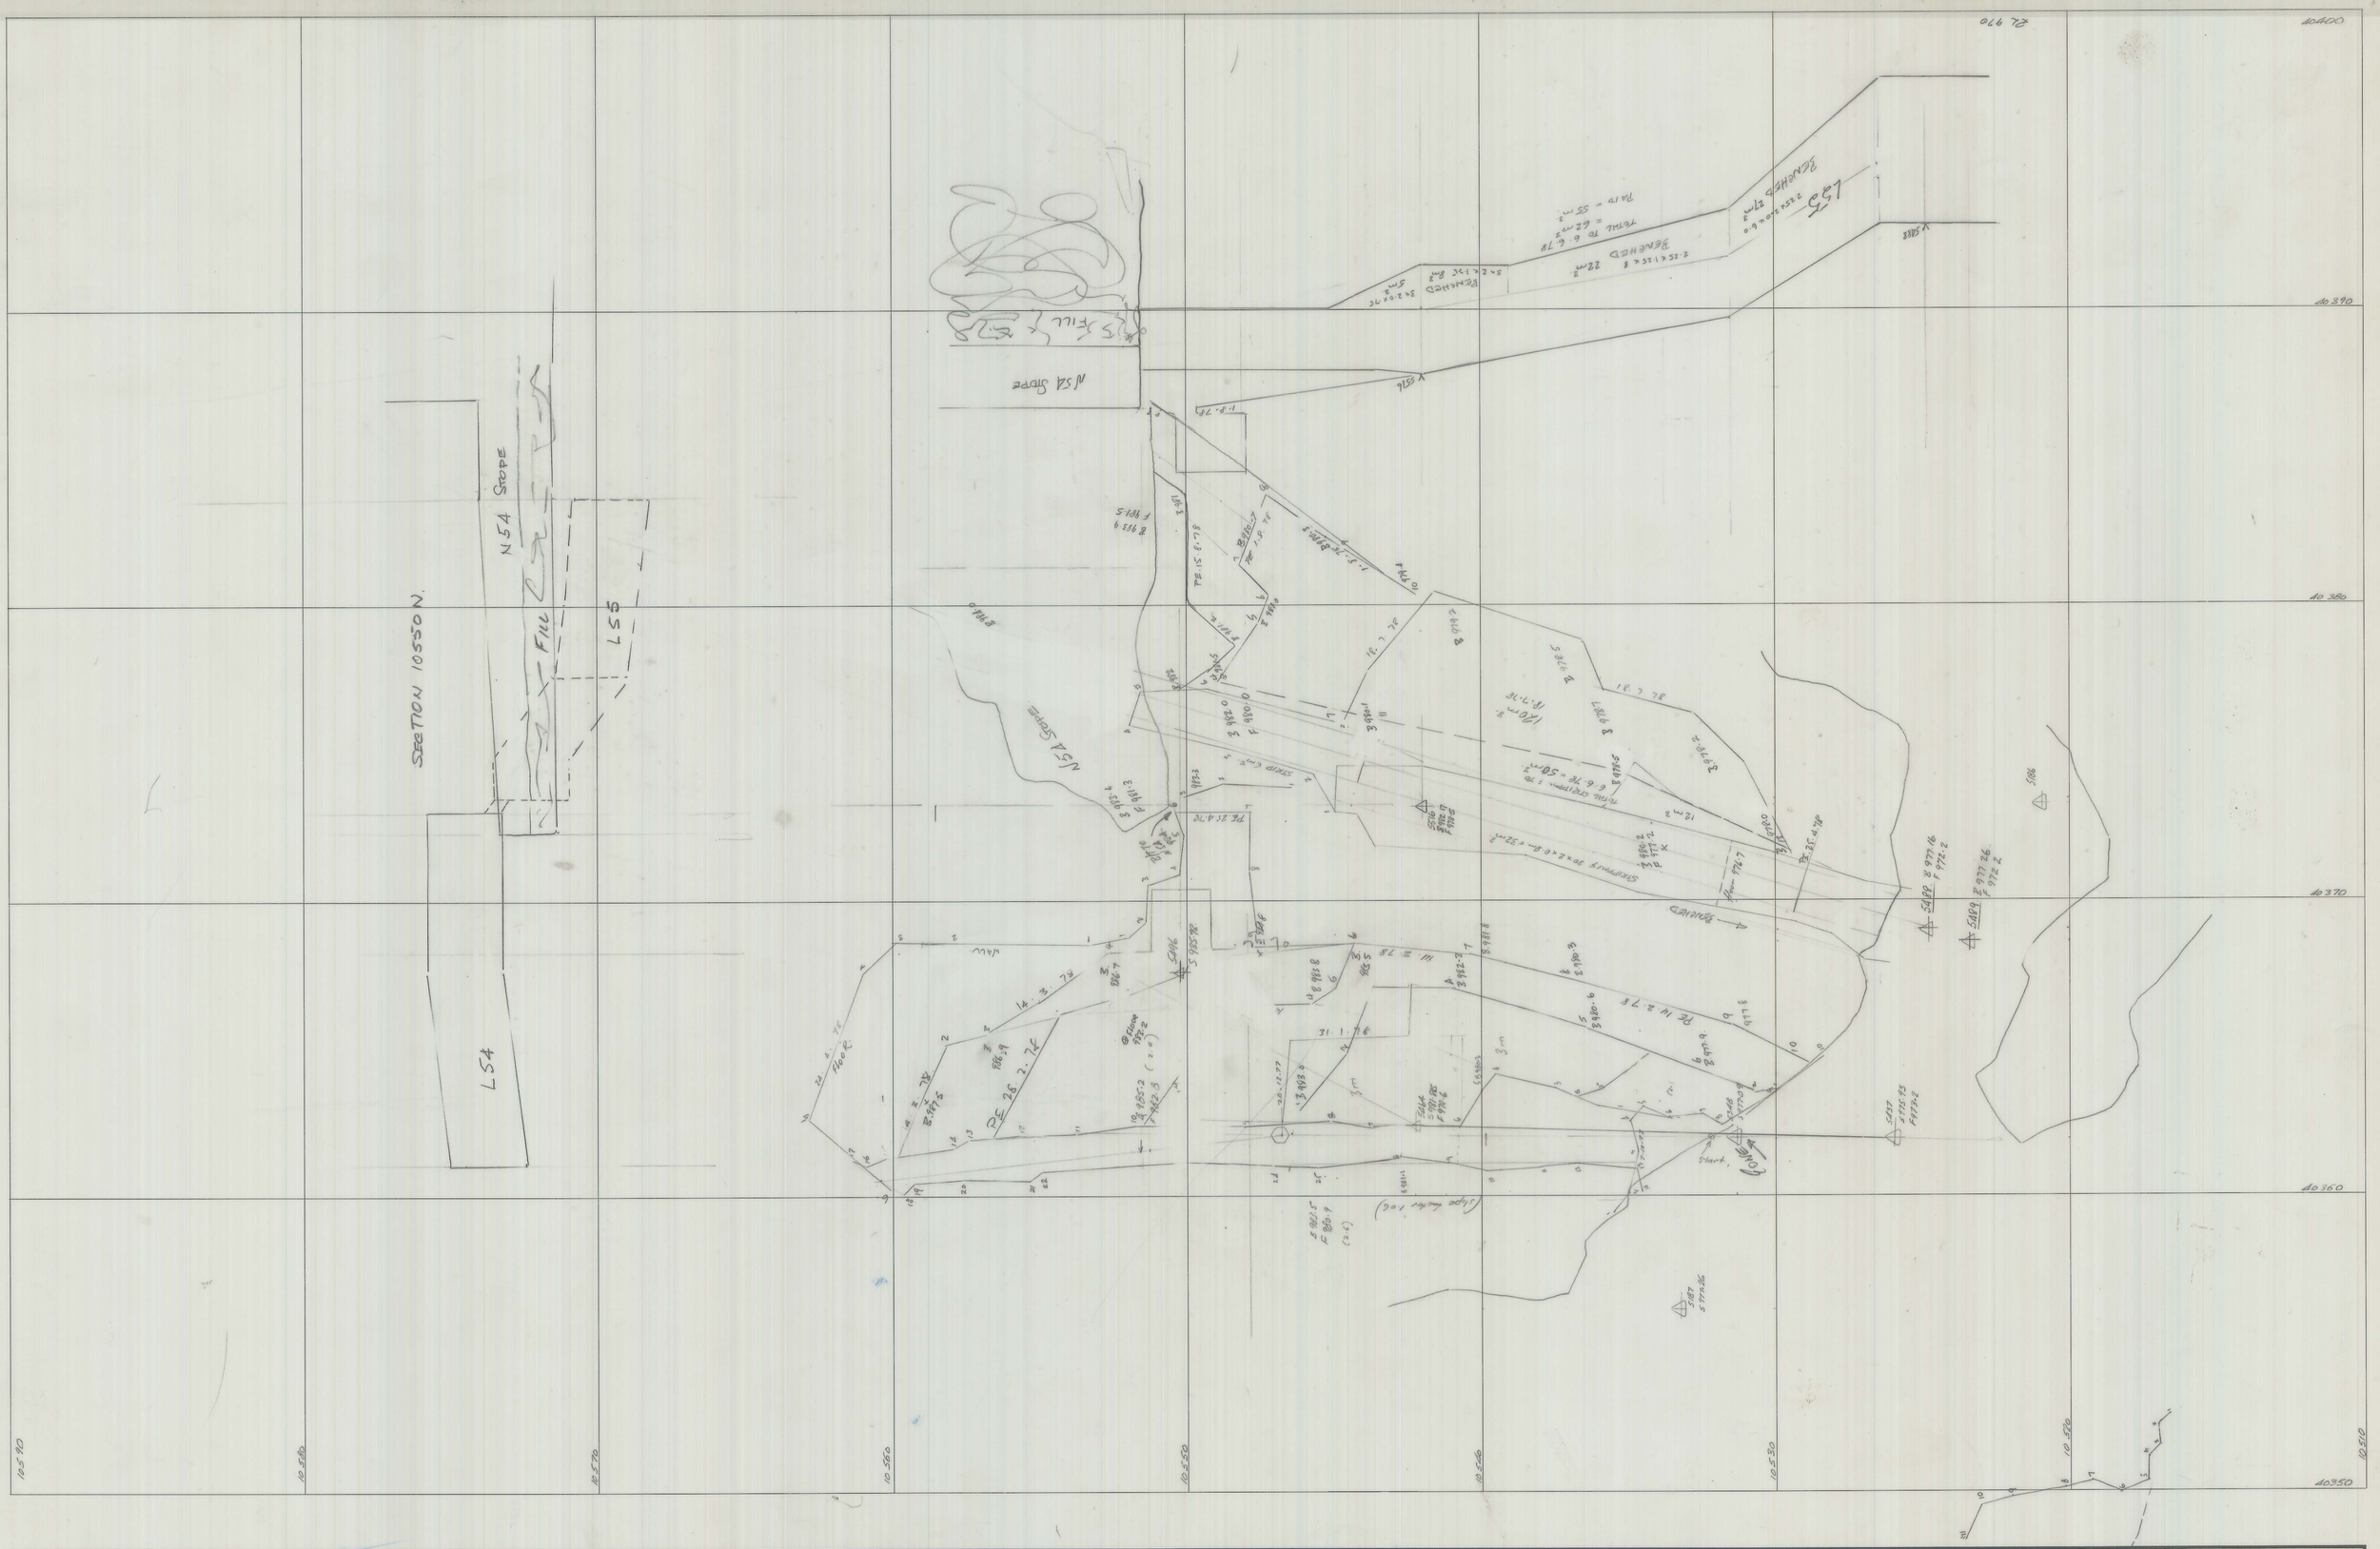

	SCALE 1:100	north	LOCATION SUBJECT

KIS KING ISLAND SCHEELITE
A DIVISION OF WARMAN INTERNATIONAL

GRASSY KING ISLAND

PLAN NUMBER
04 BH11_ 166 182