5 cm

0374_4234

04BH.11 176 120

P57 (HH)
FIRST LIFT

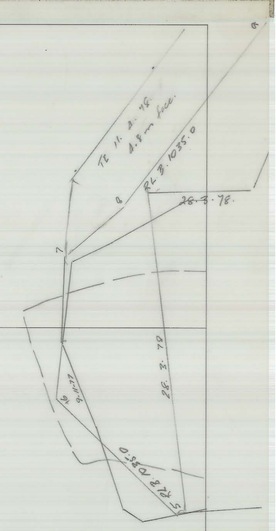

SCALE 1	north	LOCATION SUBJECT	KING ISLAND SCHEELITE A DIVISION OF WARMAN INTERNATIONAL GRASSY KING ISLAND PLAN NUMBER