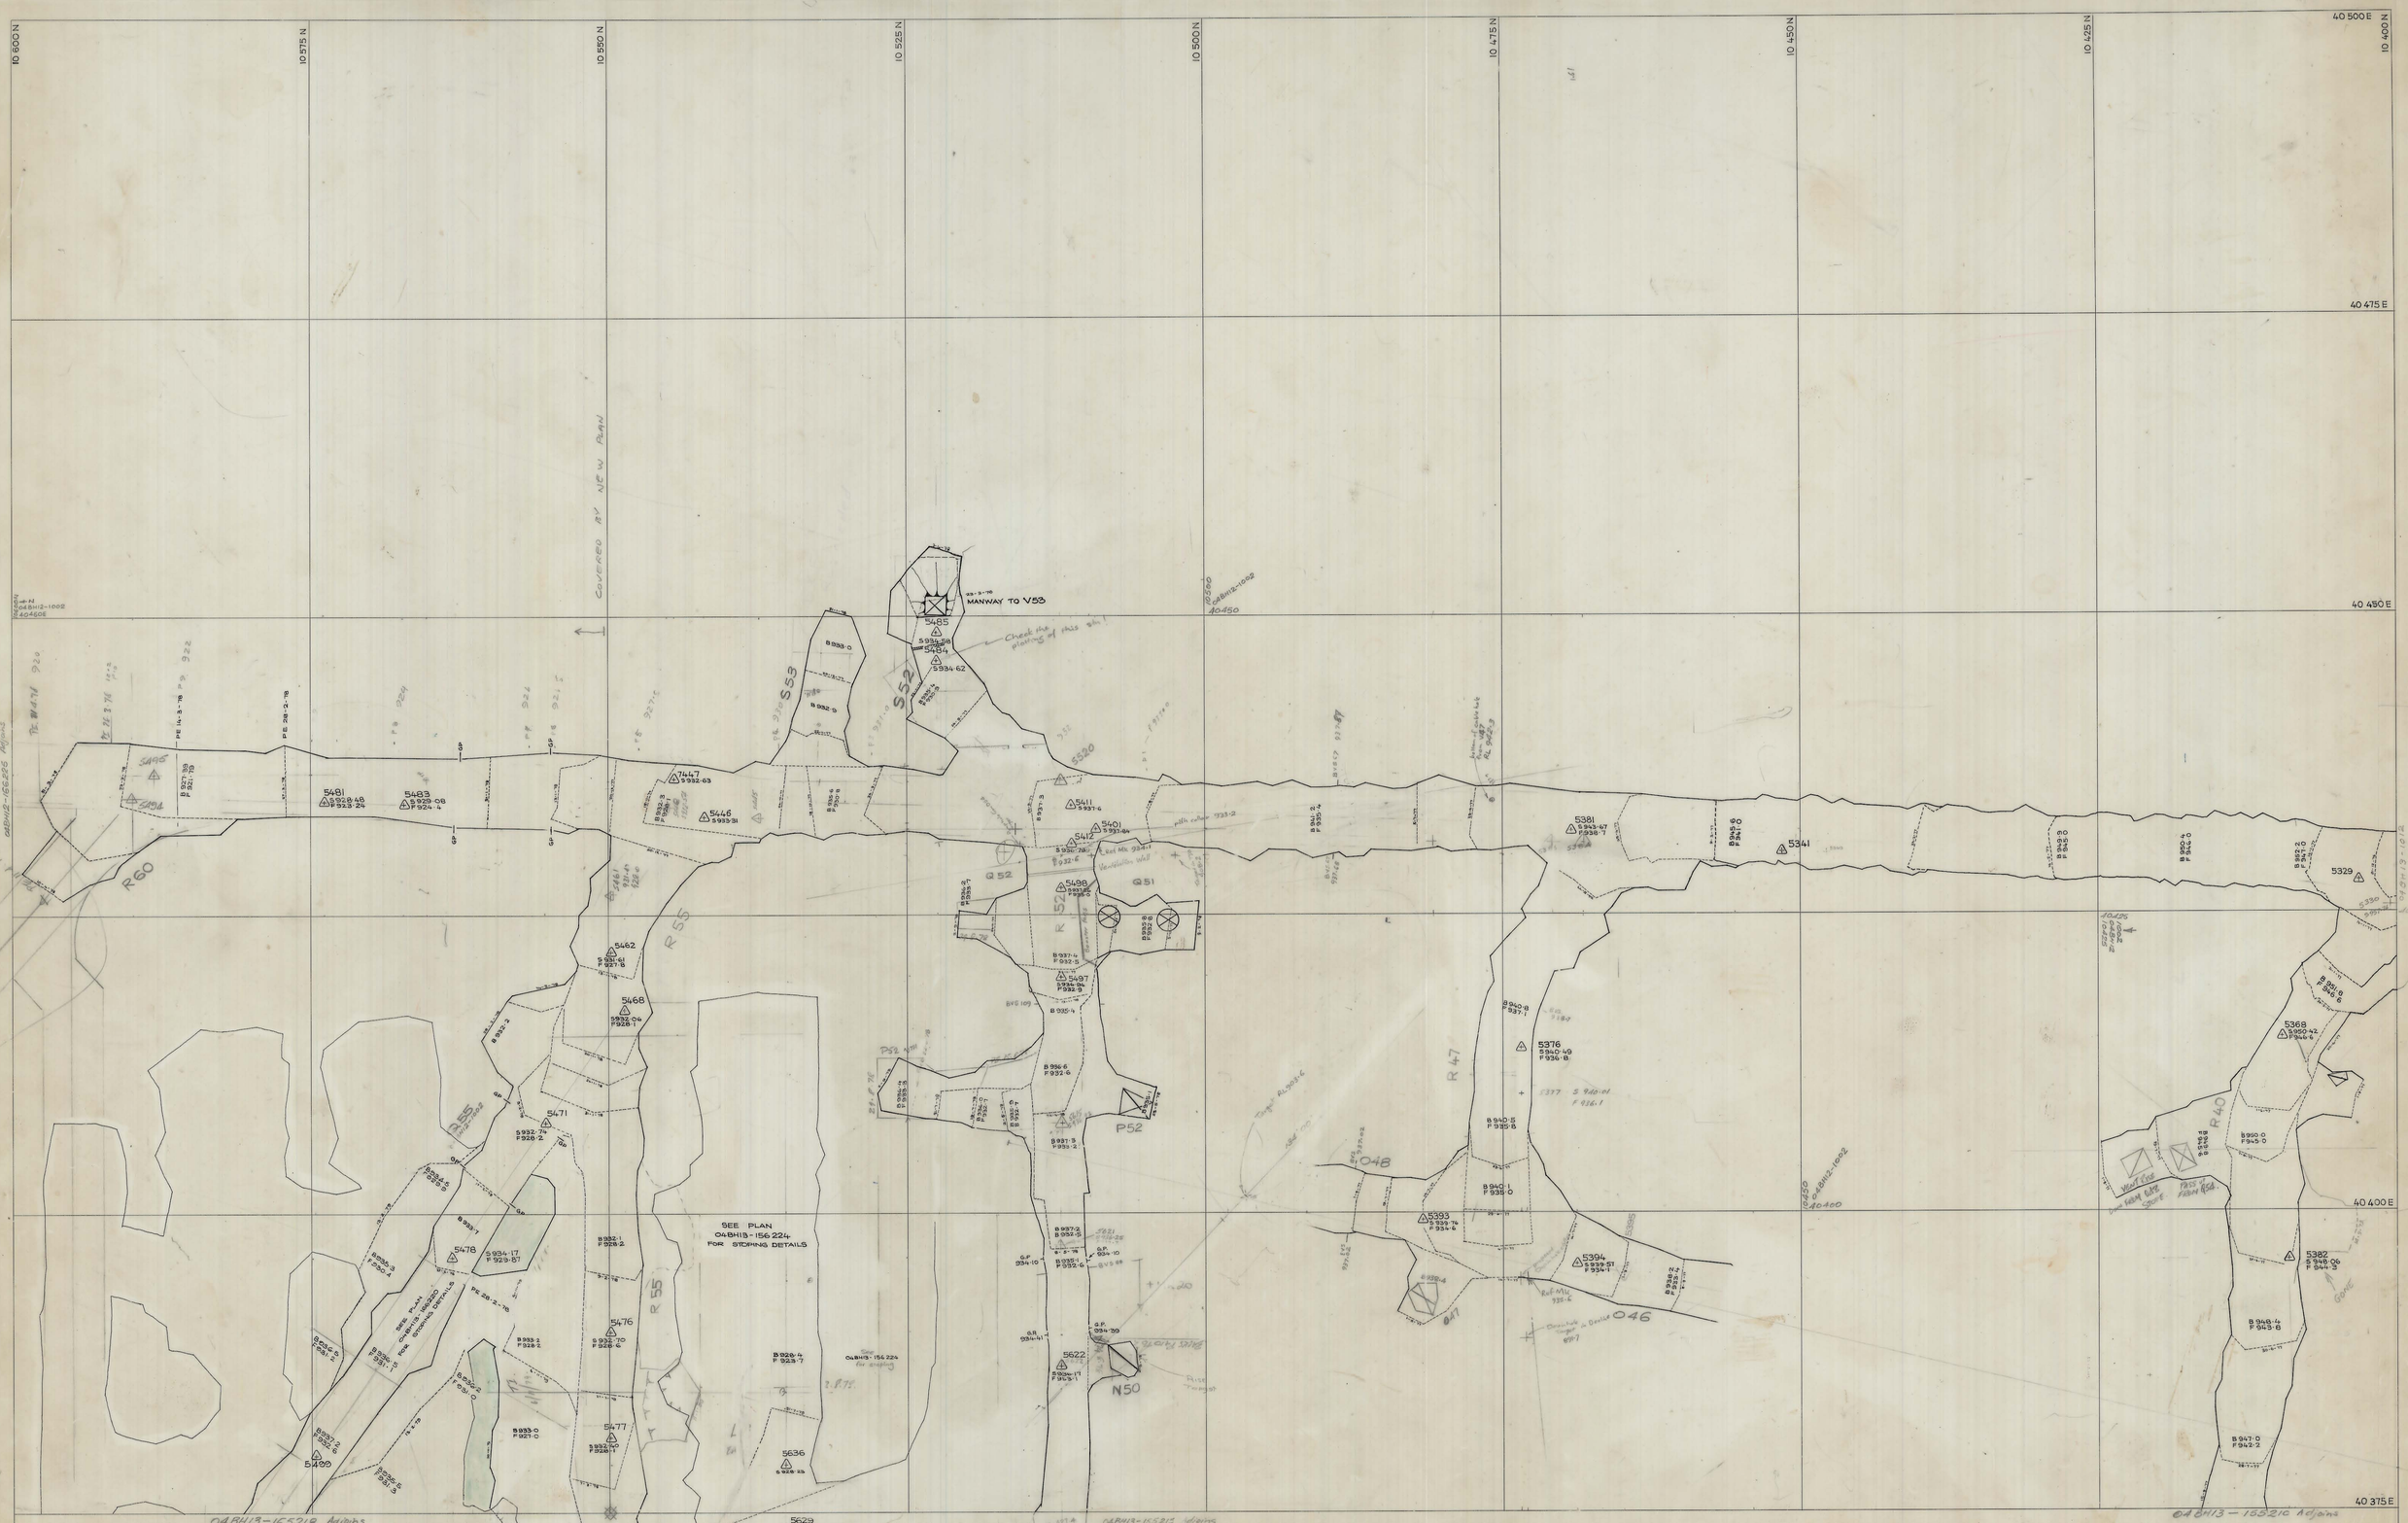27 JUN 1981
5 cm
04BH12 - 1002
0374_4246
DECLINE
R55 R52
R55
R40