

PEGARAH ESTATE SECTION E LOT 17

LAND DISTRICT OF KING ISLAND PARISH OF KITTAWA

AREA 547a. 3r. 10p.
SCALE : 1 inch equals 10 chains.

CHARTED BY J.G. PATERSON AUG. 1955.


HISTORY

CLEARED 1949, 184 acs. 1950, 52 acs. 1952, 10 acs.
PLOUGHED 1951, 236 acs. 1952, 10 acs. (pdk's A and B).
SEEDED 1952 172 acs. } with 1½ cwt. copper super per ac.
 1953 64 acs. }
 1954 10 acs. with 2½ cwt. copper super per ac. (pdk's A and B).
TOP DRESSED 1953 64 acs. } Whole area west of Grassy river (pdk's C to R) top dressed
 1954 236 acs. } with 1½ cwt. plain super per ac.
 1957 60 bags plain super supplied.
 1958 300 " " "
 1964 36 bags muriate potash and 365 bags Lindane super supplied.
 1965 264 bags plain super supplied.
 1966 110 bags plain super and 354 (1 cwt) bags Cu.Co. super supplied.
 1967 548 bags plain super supplied.
NOTE : These figures for super supplied apply to original lot 17 of 358 acs pasture area and includes 112 acs. now part of lots 7 & 8 F. Exact distribution of super over remaining 246 acs. not known but is assumed to average 8.7 cwt. per ac. since 1956.

RE-DEVELOPED 1962 35.2 acs. (pdk's D1 and D2) ploughed and cultivated Dec.
 1963 35.2 acs. seeded out. with 3 cwt. Cu.Co. super per ac. (pdk's D1 and D2).

SGRUB & OR NON ARABLE	PASTURE	TOTAL	
A	47.6	8.9	56.5
B	55.4	1.3	56.7
C	35.7	31.5	67.2
D1	8.8	12.7	21.5
D2	31.5	22.5	54.0
D3	46.8	46.8	93.6
E	0.2	10.7	10.9
F1	0.8	7.4	8.2
F2		0.4	0.4
G	0.4		0.4
H		3.7	3.7
J	2.9	1.9	4.8
K	12.8	14.1	26.9
L	20.9	15.7	36.6
M	7.1	13.6	20.7
N	0.1	7.0	7.1
P	0.6	6.4	7.0
Q	0.6	7.0	7.6
R	29.3	34.7	64.0
TOTAL	301.5	246.3	547.8

HOUSE PADDOCK

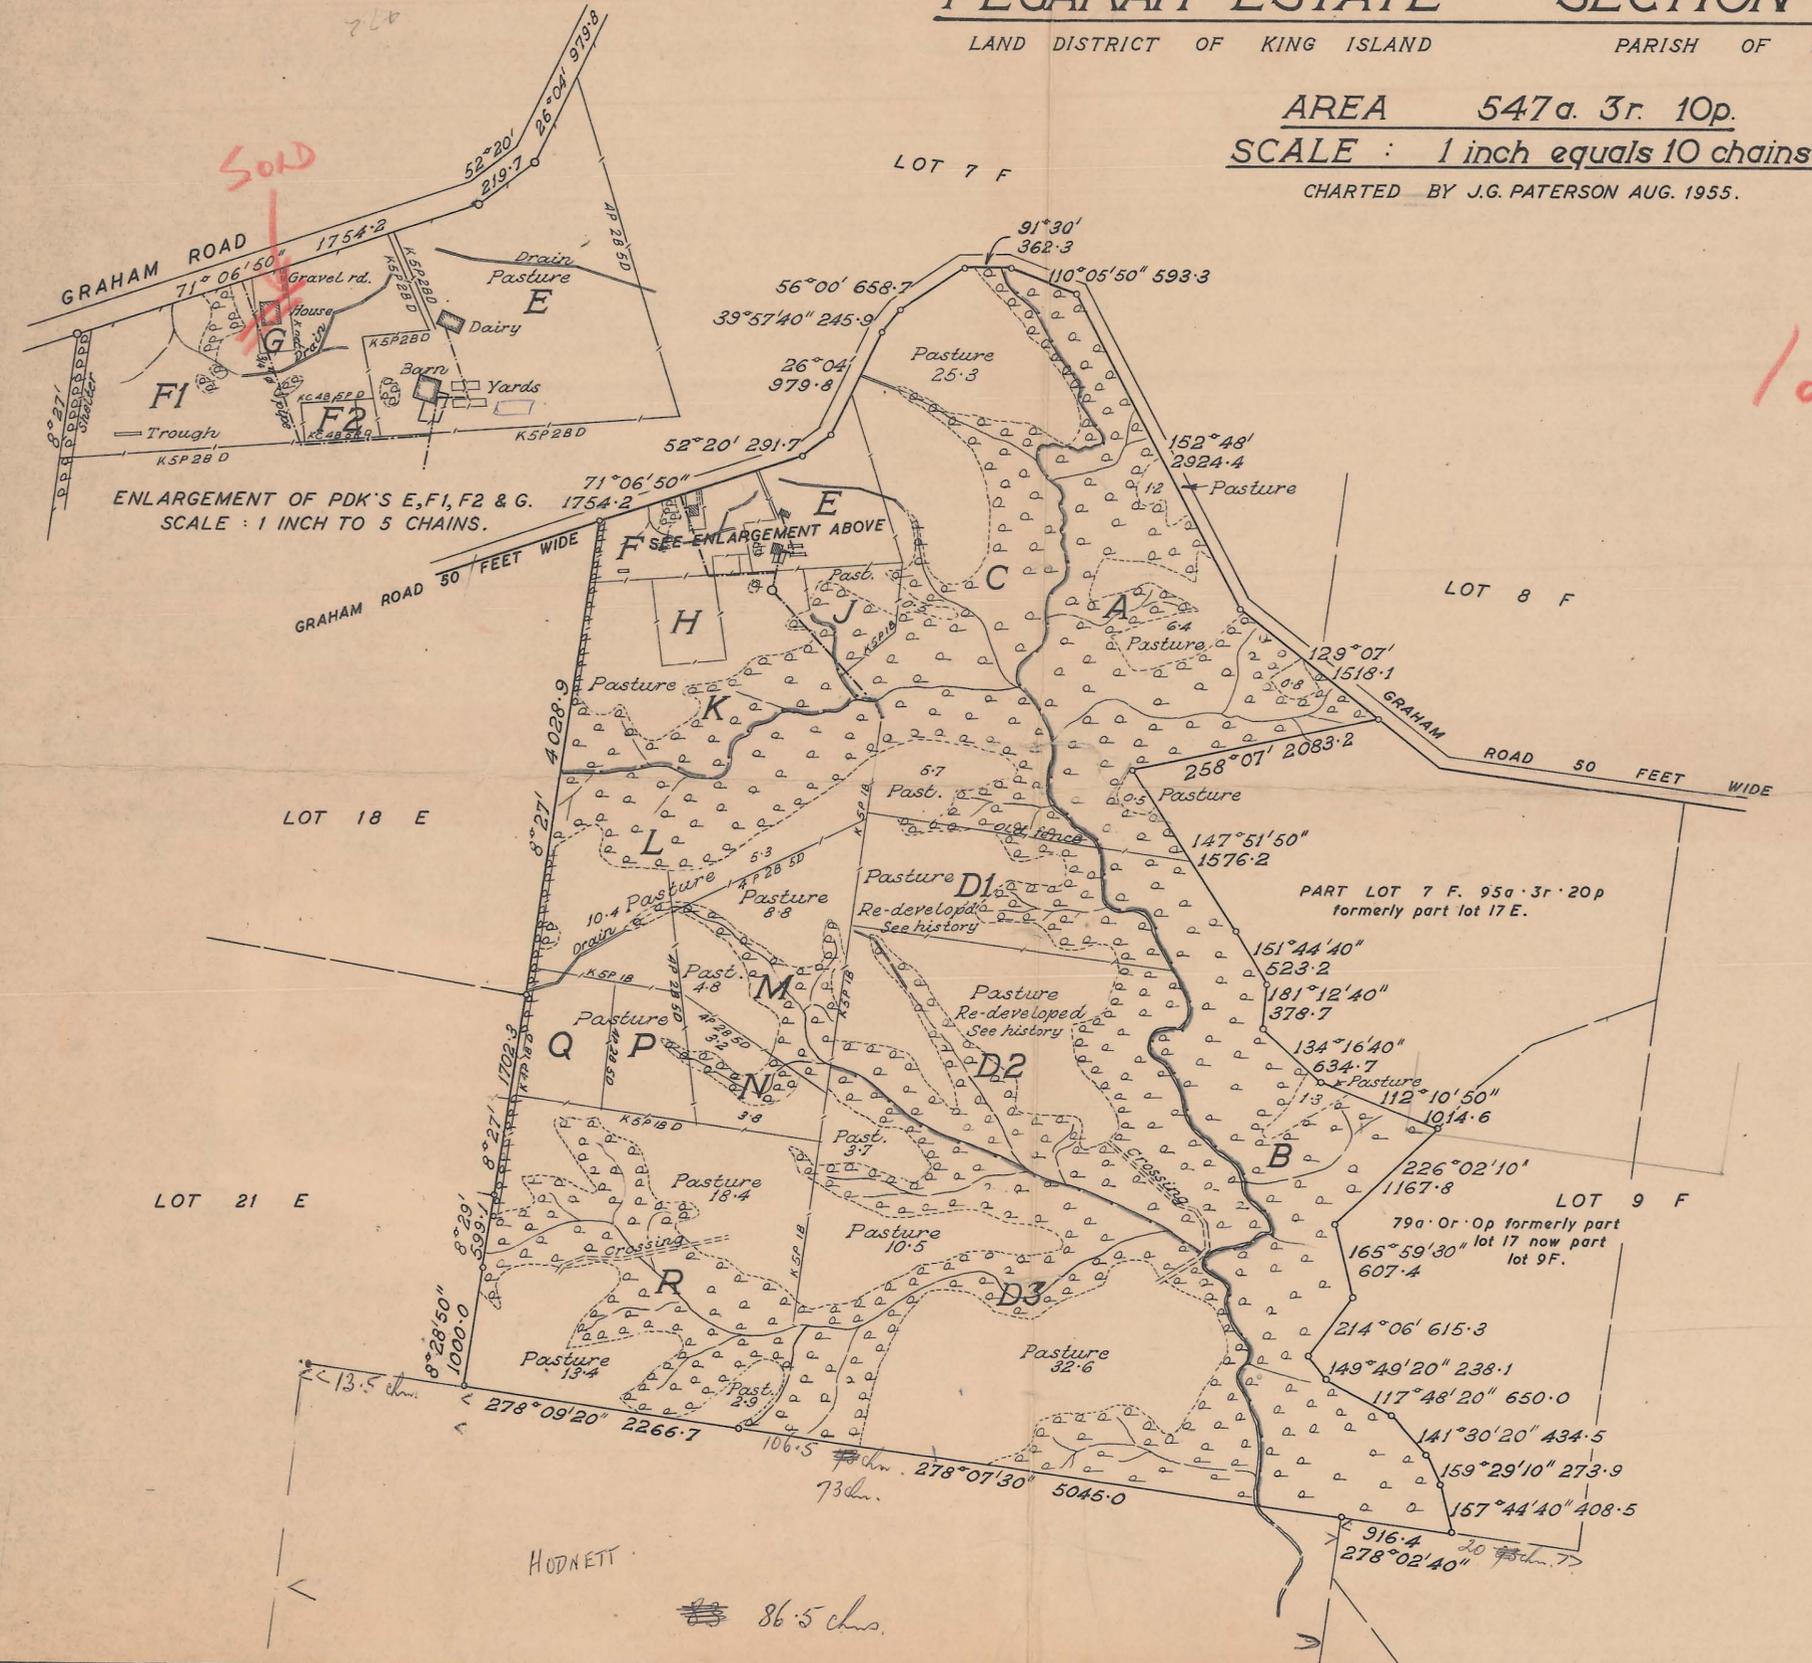

11GDO1 - X003
0374_4262

5 cm

SECTION E LOT 17
CHART REVISED SEPT. 1969. C.W.G.