


PEGARAH ESTATE SECTION E LOT 19

LAND DISTRICT OF KING ISLAND PARISH OF KITTAWA

AREA 196 a. Or. 7 p.

SCALE : 1 inch equals 5 chains.

CHARTED BY J.G. PATERSON SEPT. 1955
RE-CHARTED BY J.G. PATERSON AUG. 1956

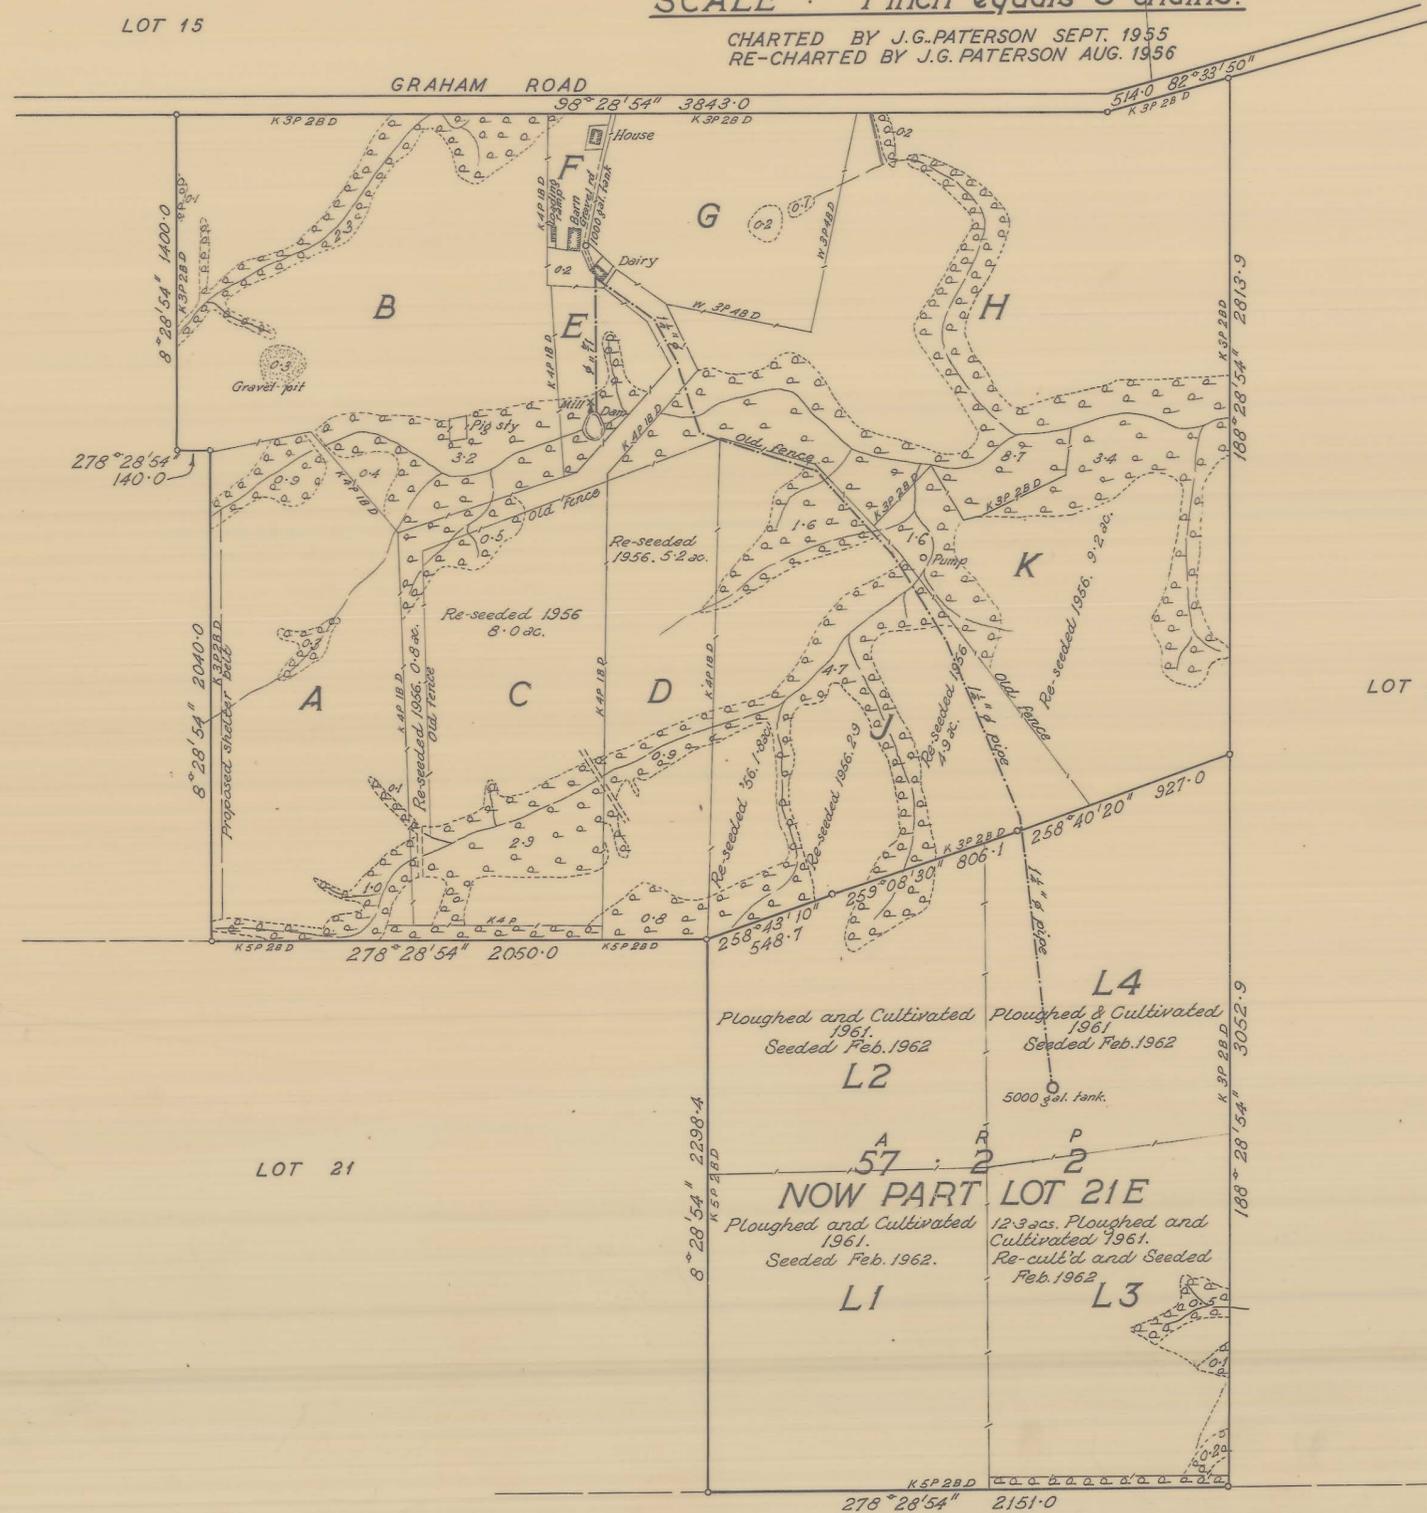

HISTORY

Contained 30 acs. old pasture (part pdks. A, Lane, C, D & J).

- CLEARED. 84 acs. 1949, 40 acs. 1950.
- PLOUGHED. 106 acs. 1951, 18 acs. 1952.
- SEEDED. 70 acs. 1952, 84 acs. 1953 including all old pasture area with $1\frac{1}{2}$ cwt. copper super per ac.
- RE-SEEDED. 1956. 77 acs. limed and re-seeded out with $2\frac{1}{2}$ cwt. Cu.Co super per ac. (0.8 acs. Lane, 8.0 acs. C, 5.2 acs. D, 6.2 acs. G, 9.2 acs. K, 9.6 acs. J and 38 acs. of L group paddocks).
- TOP DRESSED. 1953. 70 acs. with $1\frac{1}{2}$ cwt. plain super per ac.
1954. 154 acs. with $1\frac{1}{2}$ cwt. plain super per ac., 36 bags plain super supplied.
1955. 120 bags plain super supplied.
1956. 210 bags plain super & 126 bags cobalt super supplied.
- RE-DEVELOPED. 1961. 3 acs. cleared, 55.1 acs. ploughed and cultivated (pdks. L1, L2, L4 and 12.3 acs. L3).
1962. Pdk. L3 & L4 re-cultivated and 55.1 acs. (pdks. L1, 2, 3 & 4) seeded out with 3 cwt. Cu.Co. super per ac.

	SCRUB &/OR NON ARABLE	PASTURE	TOTAL
A	2.3	13.1	15.4
B	5.9	17.7	17.7
C	3.4	9.4	12.8
D	1.7	7.3	9.0
E	0.9	1.6	2.5
Lane	0.7	2.2	2.9
F	0.4	0.9	1.3
House	0.2		0.2
G	0.3	7.1	7.4
H	8.9	19.4	28.3
J	6.3	12.7	19.0
K	5.0	10.1	15.1
Shelters	1.0		1.0
	37.0	101.5	138.5

138 a. 2 r. 5 p
Sold to King Island Scheelite Co.

ALLOTTED TO LOT 21E

	SCRUB &/OR NON ARABLE	PASTURE	TOTAL
L1		15.4	15.4
L2	0.7	12.6	13.3
L3	0.8	12.6	13.4
L4		15.0	15.0
Shelters	0.4		0.4
	1.9	55.6	57.5
	38.9	157.1	196.0

57 a. 2 r. 2 p

SECTION E LOT 19

CHART REVISED JUNE 1963 & AUG. 1970. C.W.G.

115001 - X004

0374_4263

5 cm

SECTION E
LOT 19
1-12-11