

1" = 5 chains
SECTION E
LOT 19
1-12-12

116D02 - X005

0374_4264


5 cm

PEGARAH ESTATE SECTION E LOT 19

LAND DISTRICT OF KING ISLAND PARISH OF KITTAWA

AREA 196a Or. 7p.
SCALE: 1 inch equals 5 chains.

CHARTED BY J.G. PATERSON SEPT. 1955
RE-CHARTED BY J.G. PATERSON AUG. 1956

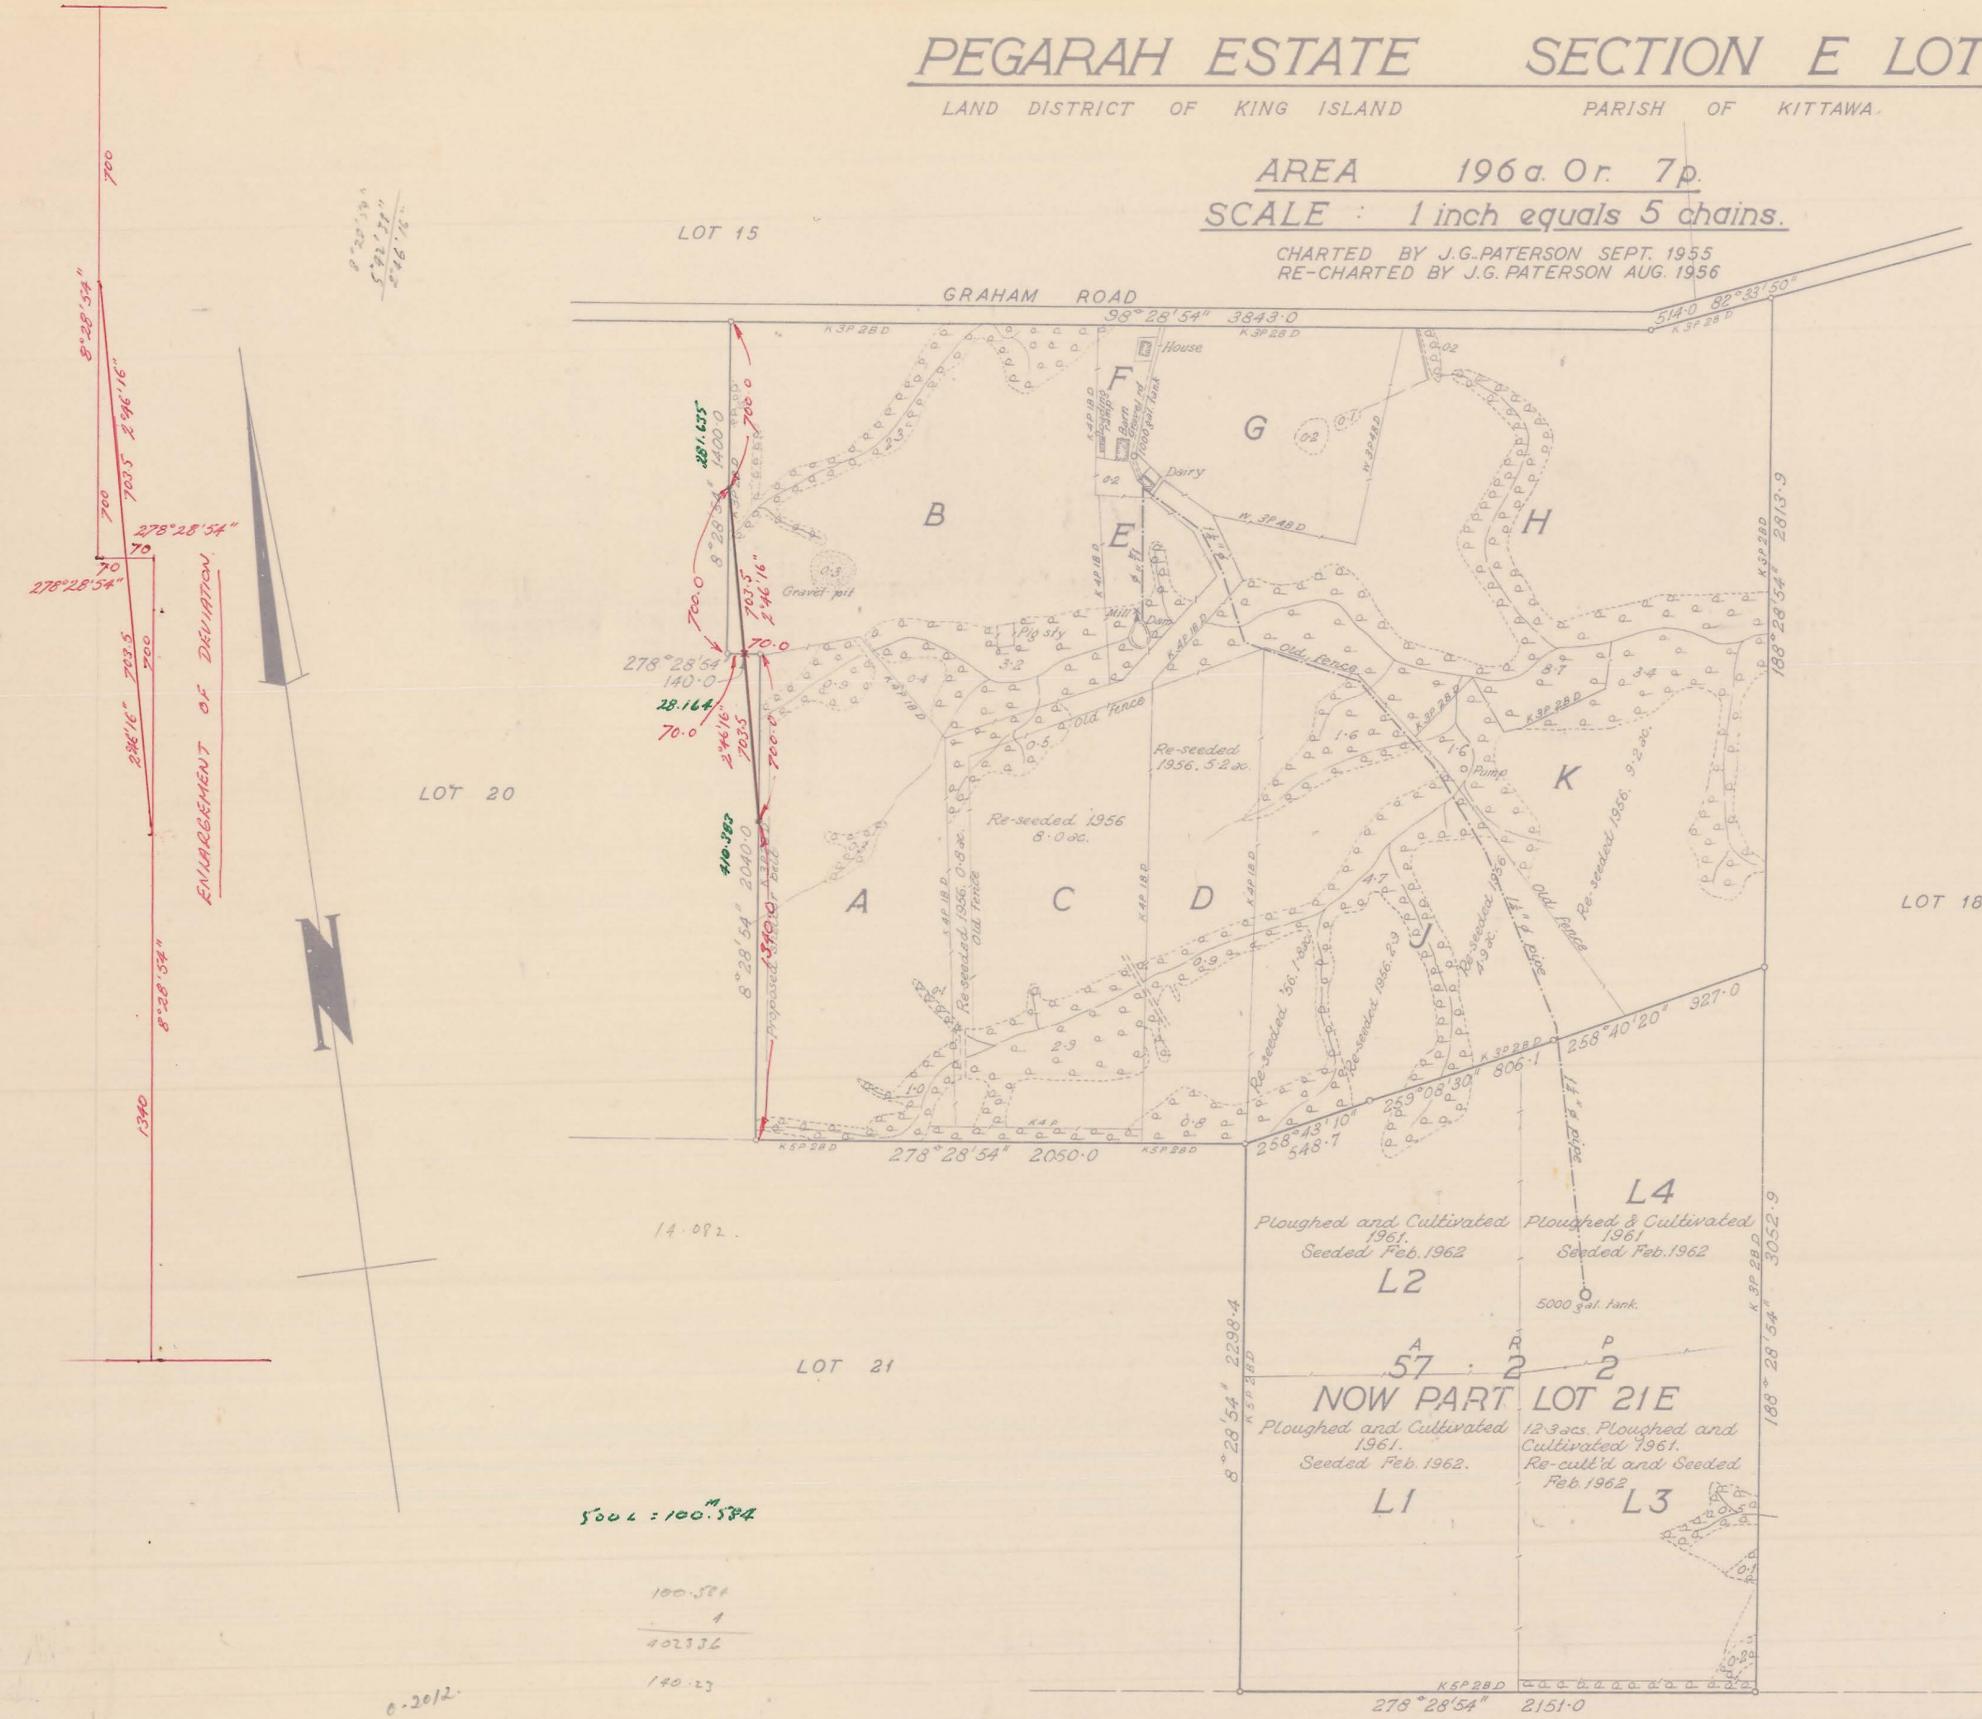

HISTORY
Contained 30 acs. old pasture (part pdks. A, Lane, C, D & J).

CLEARED. 84 acs. 1949, 40 acs. 1950.

PLOUGHED. 106 acs. 1951, 18 acs. 1952.

SEEDED. 70 acs. 1952, 84 acs. 1953 including all old pasture area with 1 1/2 cwt. copper super per ac.

RE-SEEDED. 1956. 77 acs. limed and re-seeded out. with 2 1/2 cwt. Cu.Co super per ac. (0.8 acs. Lane, 8.0 acs. C, 5.2 acs. D, 6.2 acs. G, 9.2 acs. K, 9.6 acs. J and 38 acs. of L group paddocks).

TOP DRESSED. 1953. 70 acs. with 1 1/2 cwt. plain super per ac.
1954. 154 acs. with 1 1/2 cwt. plain super per ac., 36 bags plain super supplied.
1955. 120 bags plain super supplied.
1956. 210 bags plain super & 126 bags cobalt super supplied.

RE-DEVELOPED. 1961. 3 acs. cleared, 55.1 acs. ploughed and cultivated (pdks. L1, L2, L4 and 12.3 acs. L3).
1962. Pdk. L3 & L4 re-cultivated and 55.1 acs. (pdks. L1, 2, 3 & 4) seeded out. with 3 cwt. Cu.Co. super per ac.

	SCRUB &/OR NON ARABLE	PASTURE	TOTAL
A	2.3	13.1	15.4
B	5.9	17.7	17.7
C	3.4	9.4	12.8
D	1.7	7.3	9.0
E	0.9	1.6	2.5
Lane	0.7	2.2	2.9
F	0.4	0.9	1.3
House	0.2		0.2
G	0.3	7.1	7.4
H	8.9	19.4	28.3
J	6.3	12.7	19.0
K	5.0	10.1	15.1
Shelters	1.0		1.0
	37.0	101.5	138.5

138a. 2r. 5p
Sold to King Island Scheelite Co.

ALLOTTED TO LOT 21E

	SCRUB &/OR NON ARABLE	PASTURE	TOTAL
L1		15.4	15.4
L2	0.7	12.6	13.3
L3	0.8	12.6	13.4
L4		15.0	15.0
Shelters	0.4		0.4
	1.9	55.6	57.5
	38.9	157.1	196.0

57a. 2r. 2p

SECTION E LOT 19
CHART REVISED JUNE 1963 & AUG. 1970. C.W.G.

1-12-12