

KING ISLAND — SECTION E LOT 19

AREA : 196a Or 7p.

SCALE : 1 inch equals 5 chains.

CHARTED BY J. G. PATERSON SEPT. 1955.
RE-CHARTED BY J. G. PATERSON AUG. 1956.


HISTORY
Contained 30 acs. old pasture (part pdks. A, Lane, C, D. & J).

- CLEARED. 84 acs. 1949, 40 acs. 1950.
- PLOUGHED. 106 acs. 1951, 18 acs. 1952.
- SEEDED. 70 acs. 1952, 84 acs. 1953 including all old pasture area with 1½ cwt. copper super per ac.
- RE-SEEDED. 1956. 77 acs. limed and re-seeded out. with 2½ cwt. Cu.Co. super per ac. (0.8 acs. Lane, 8.0 acs. C, 5.2 acs. D, 6.2 acs. G, 9.2 acs. K, 9.6 acs. J and 38 acs. of L group paddocks).
- TOP DRESSED. 1953. 70 acs. with 1½ cwt. plain super per ac.
1954. 154 acs. with 1½ cwt. plain super per ac., 36 bags plain super issued.
1955. 120 bags plain super supplied.
1956. 210 bags plain super & 126 bags cobalt super supplied.
- RE-DEVELOPED. 1961. 3 acs. cleared, 55.1 acs. ploughed and cultivated (pdks. L1, L2, L4 and 12.3 acs. L3).
1962. Pdks. L3 & L4 re-cultivated and 55.1 acs. (pdks L1, 2, 3 & 4) seeded out. with 3 cwt. Cu.Co. super per ac.

116D02 - X006
0374_4265

5 cm

1" = 5 chains
SECTION E
LOT 19
1-12-13

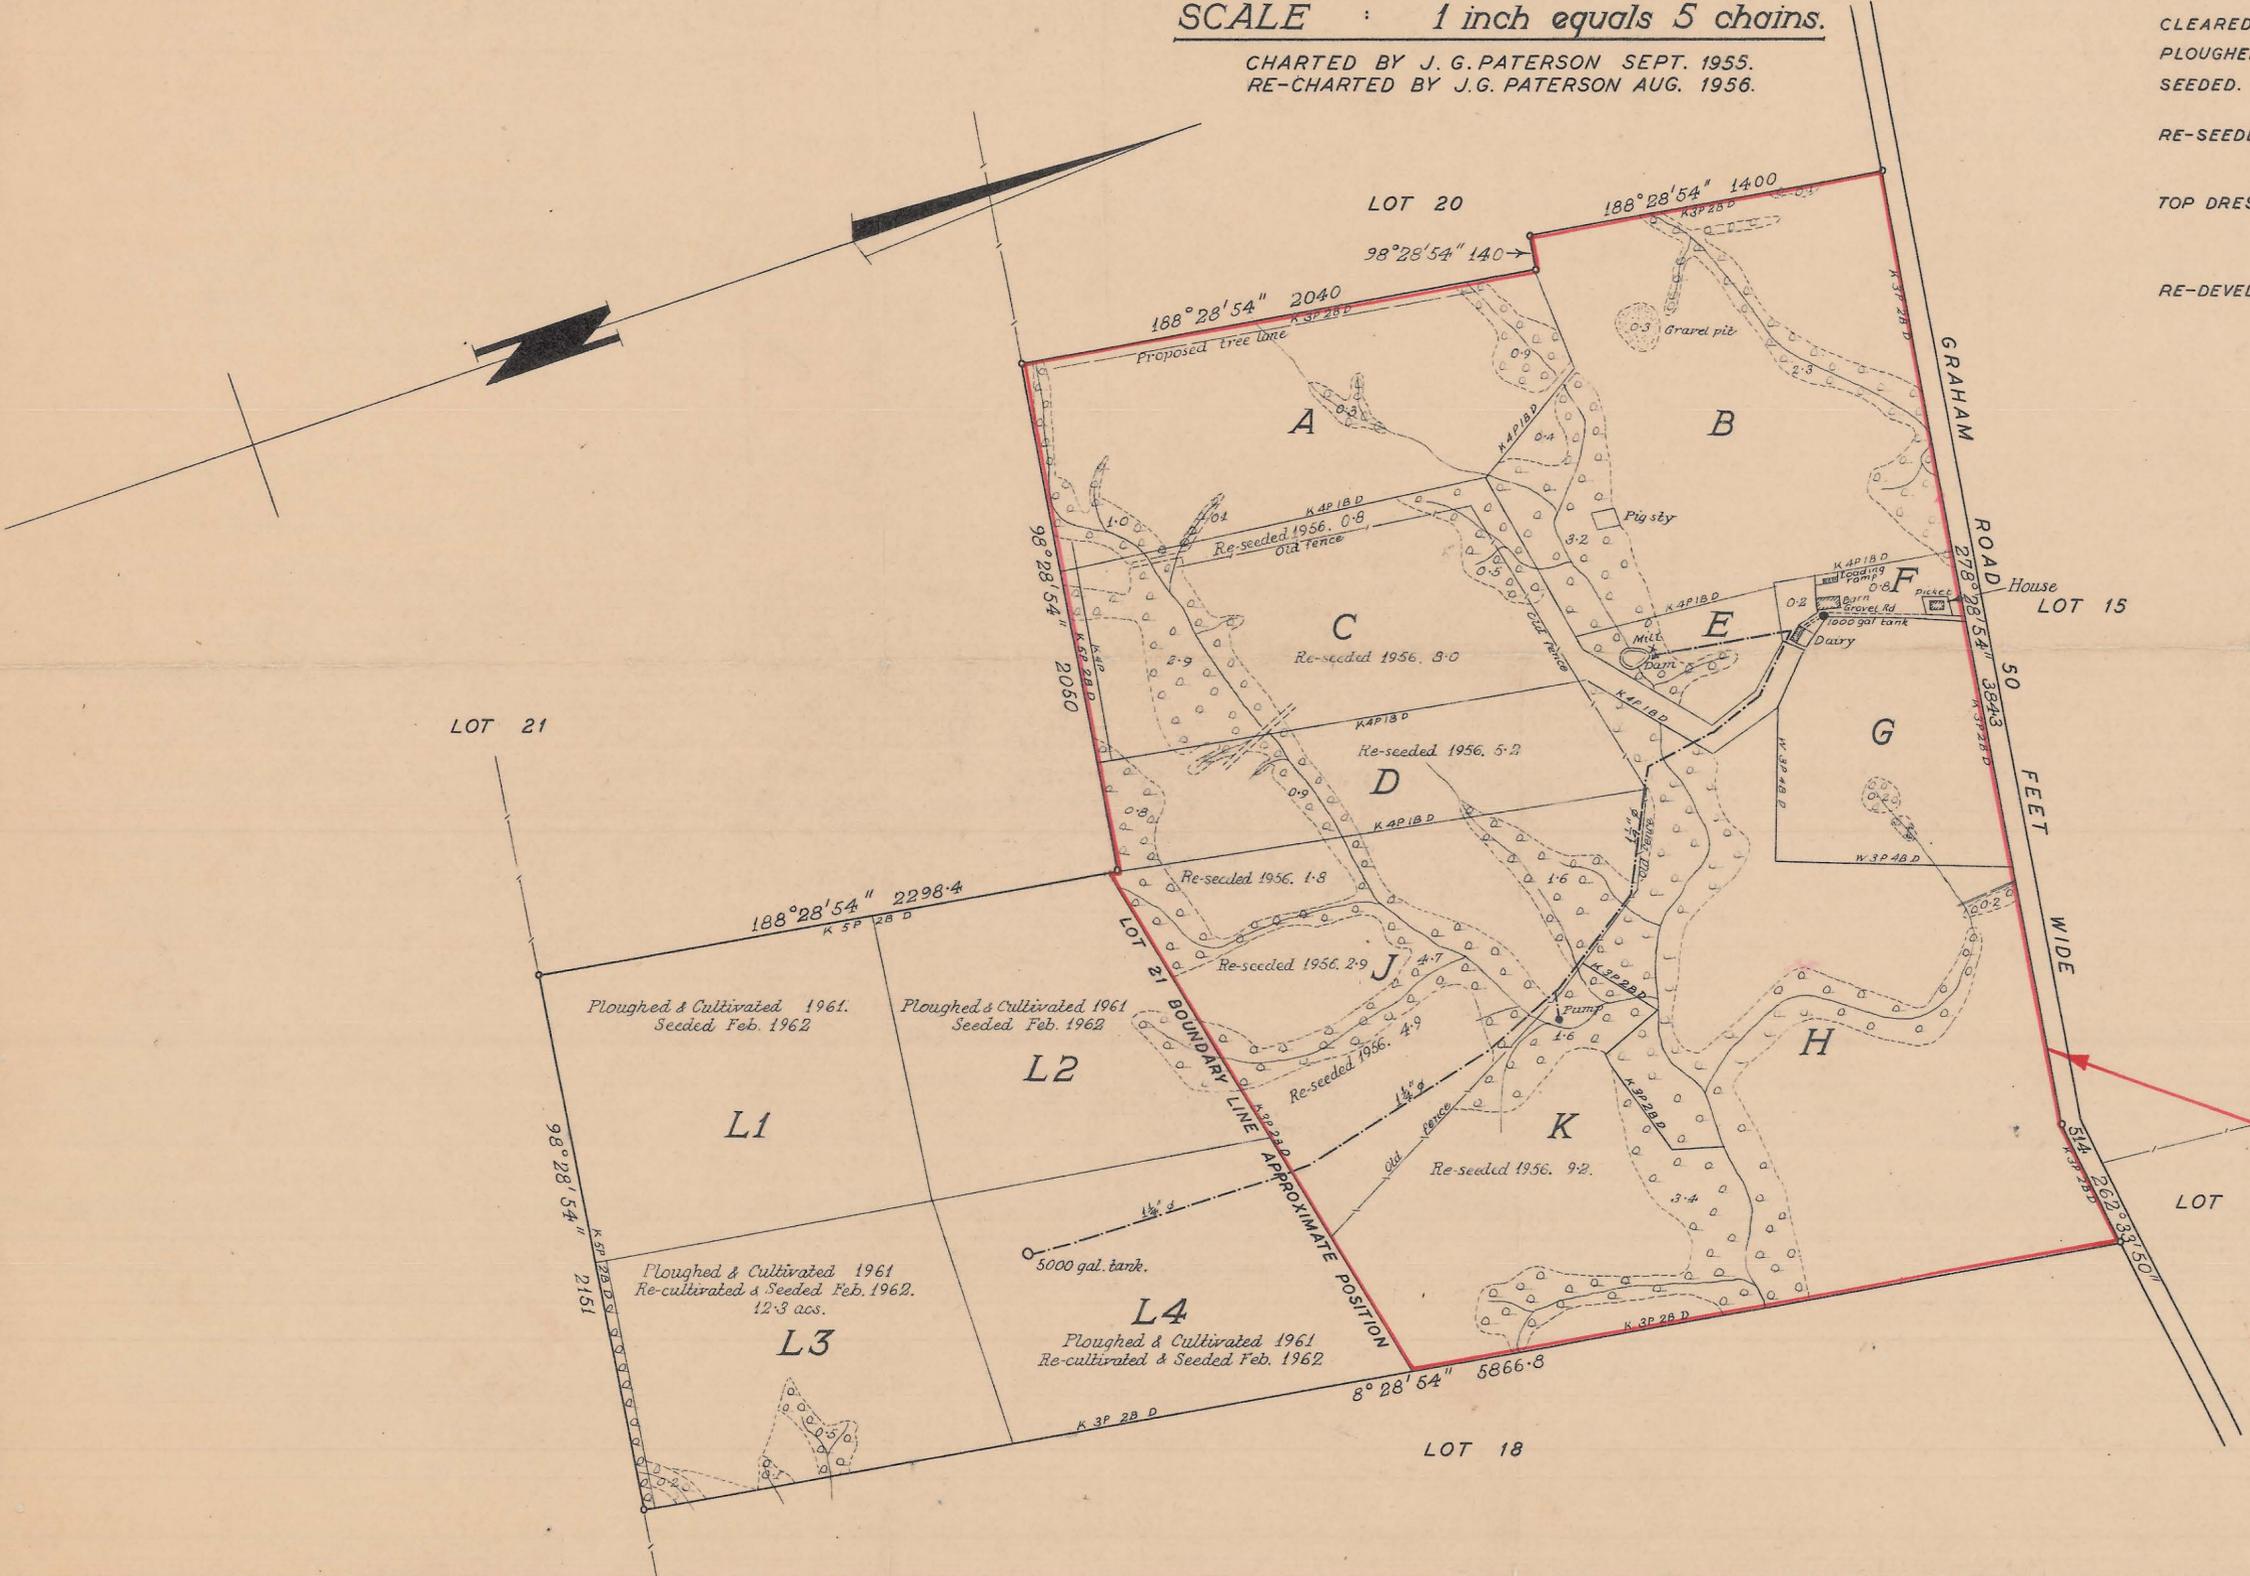

	SCRUB &/OR NON ARABLE	PASTURE	TOTAL
A	2.3	13.1	15.4
B	5.9	17.6	23.5
C	3.4	9.4	12.8
D	1.7	7.3	9.0
E	0.9	1.6	2.5
F	0.5	1.0	1.5
Lane	0.7	2.2	2.9
G	0.3	7.1	7.4
H	8.9	19.3	28.2
J	6.3	12.8	19.1
K	5.0	10.1	15.1
L1	15.4	15.4	15.4
L2	0.7	12.5	13.2
L3	0.8	12.6	13.4
L4		14.9	14.9
Shelters	1.8		1.8
1015	39.2	156.9	196.1

TO BE SOLD.

NOW PART LOT 21

AREA TO BE SOLD
A R P
138 . 2 . 5
101.5 acs. pasture approx.

SECTION E LOT 19

REVISED CHART DRAWN 21-6-63. C.W.G.

1-12-13