


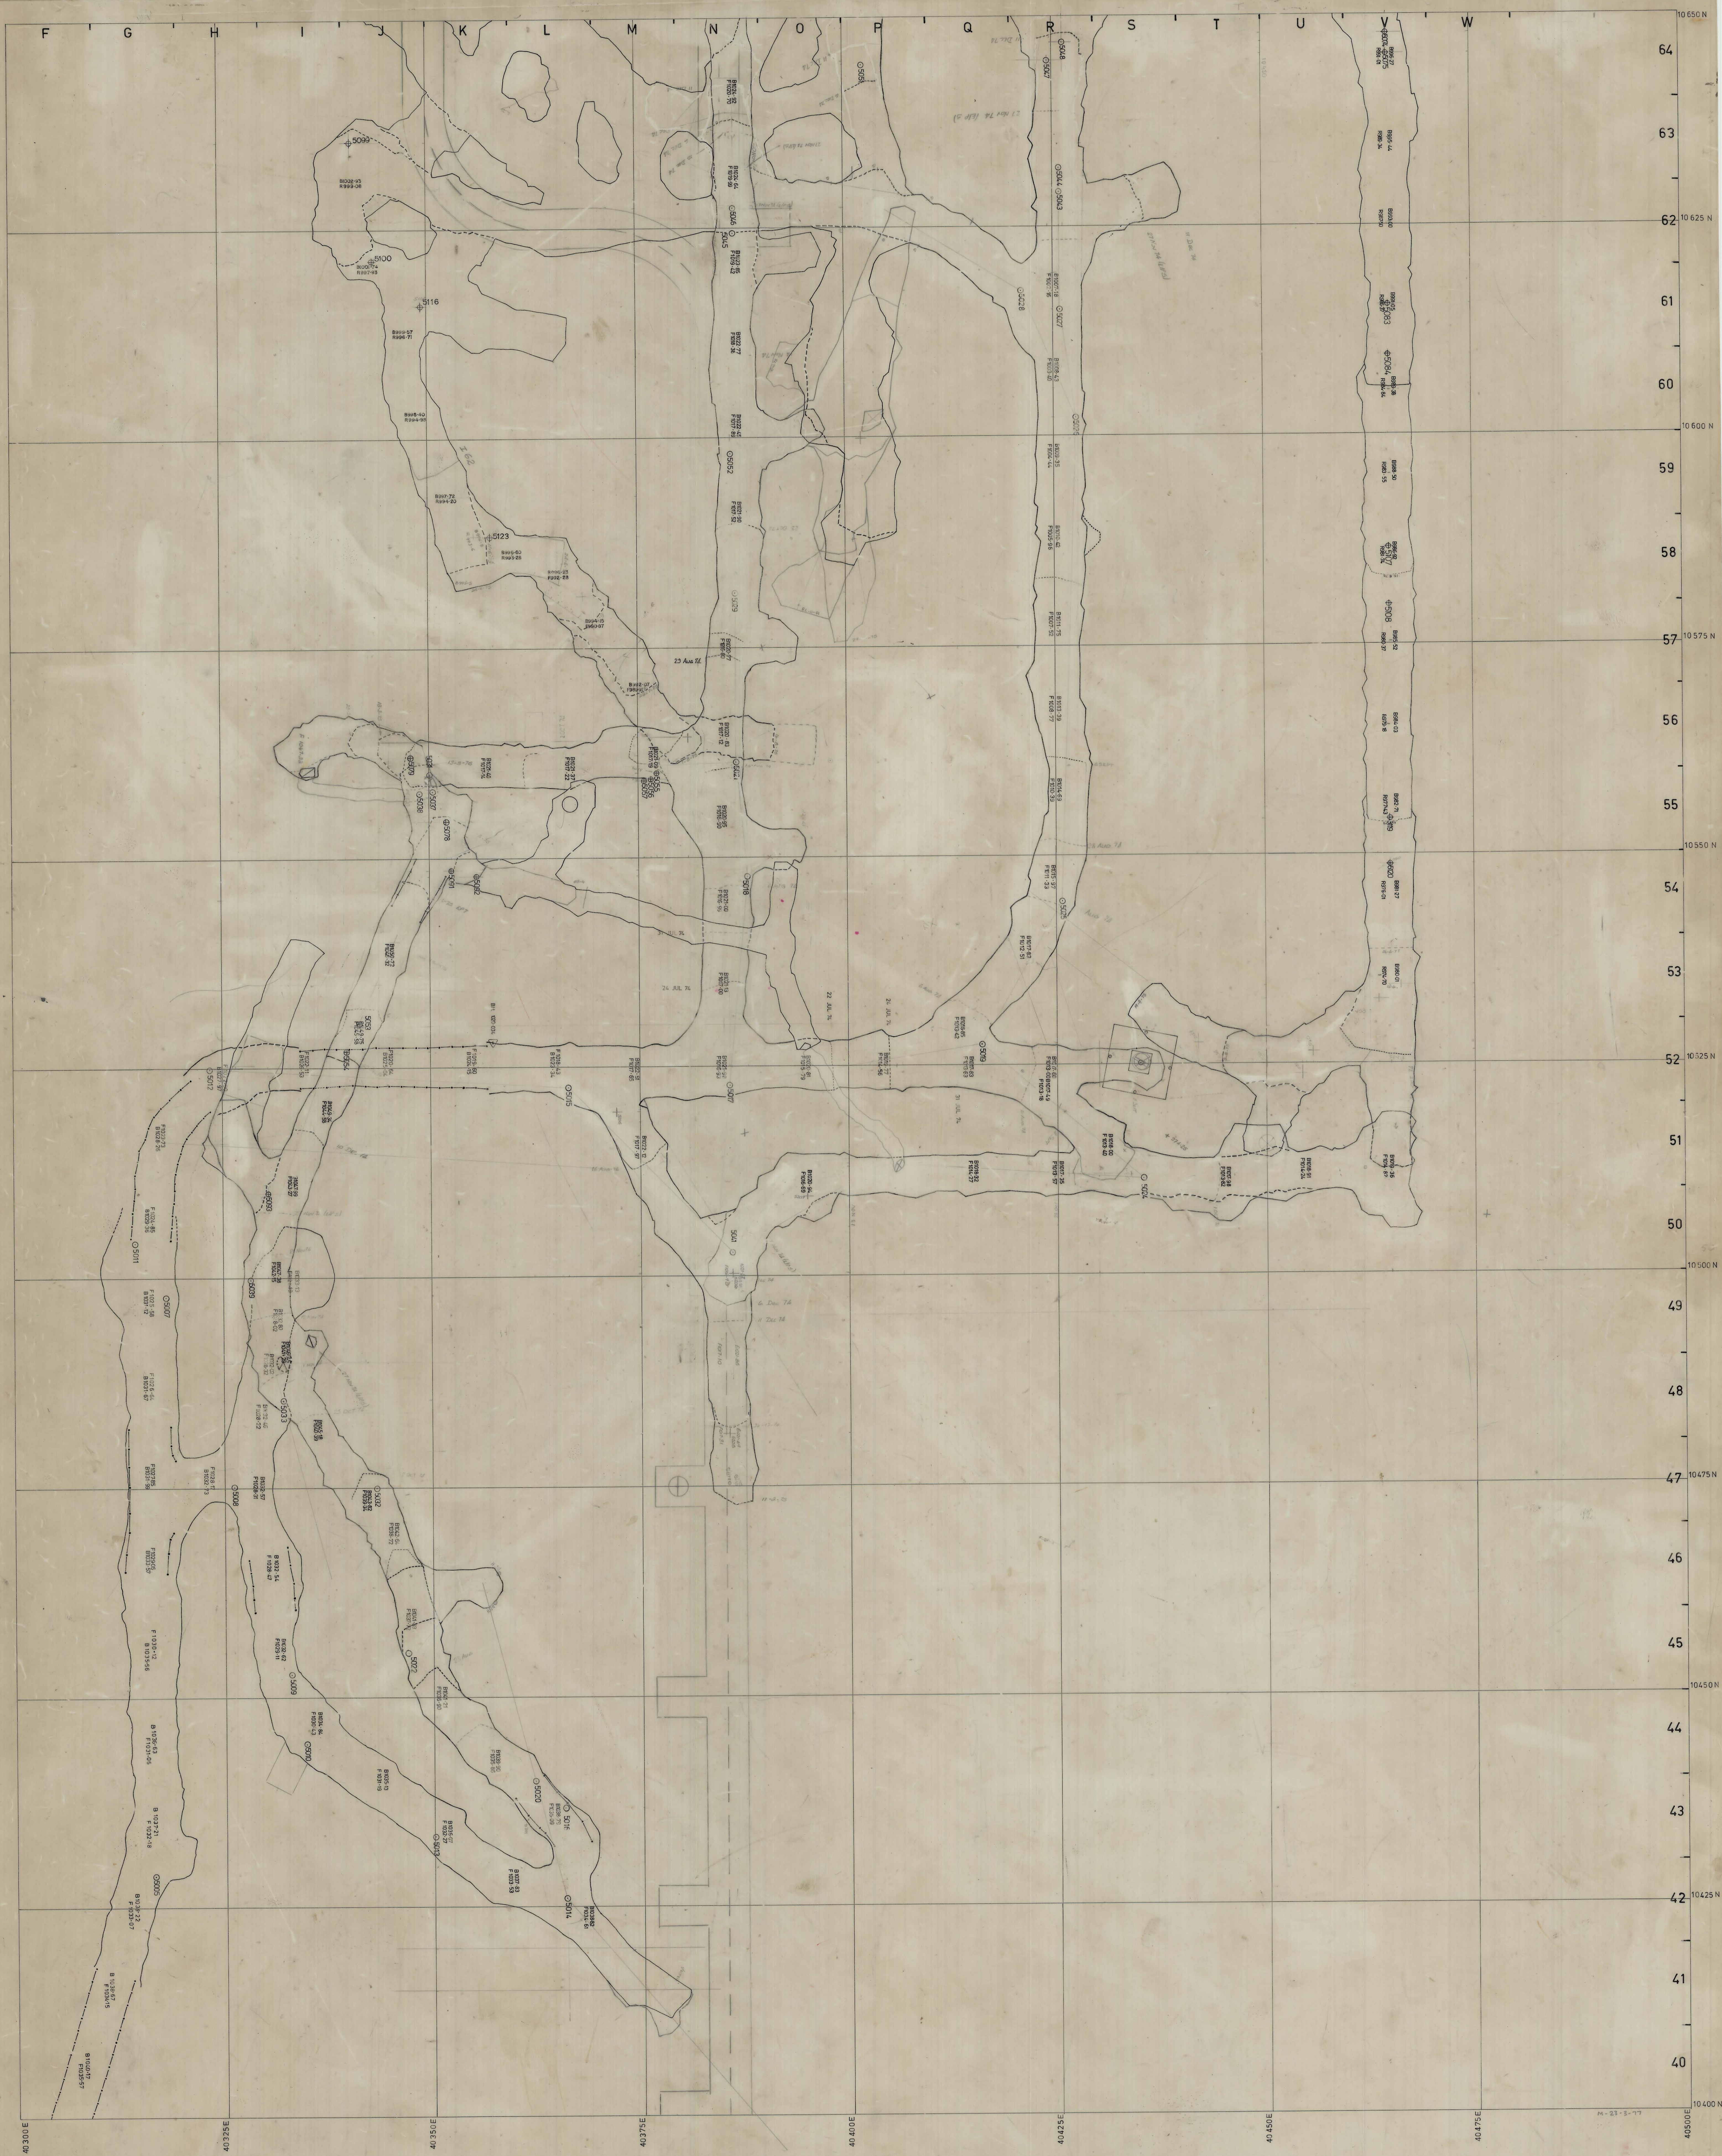

SCALE 1 : 250