27 JUN 1981

5 cm

04BH13-1029
P57 No 2 LIFT
0374_4293

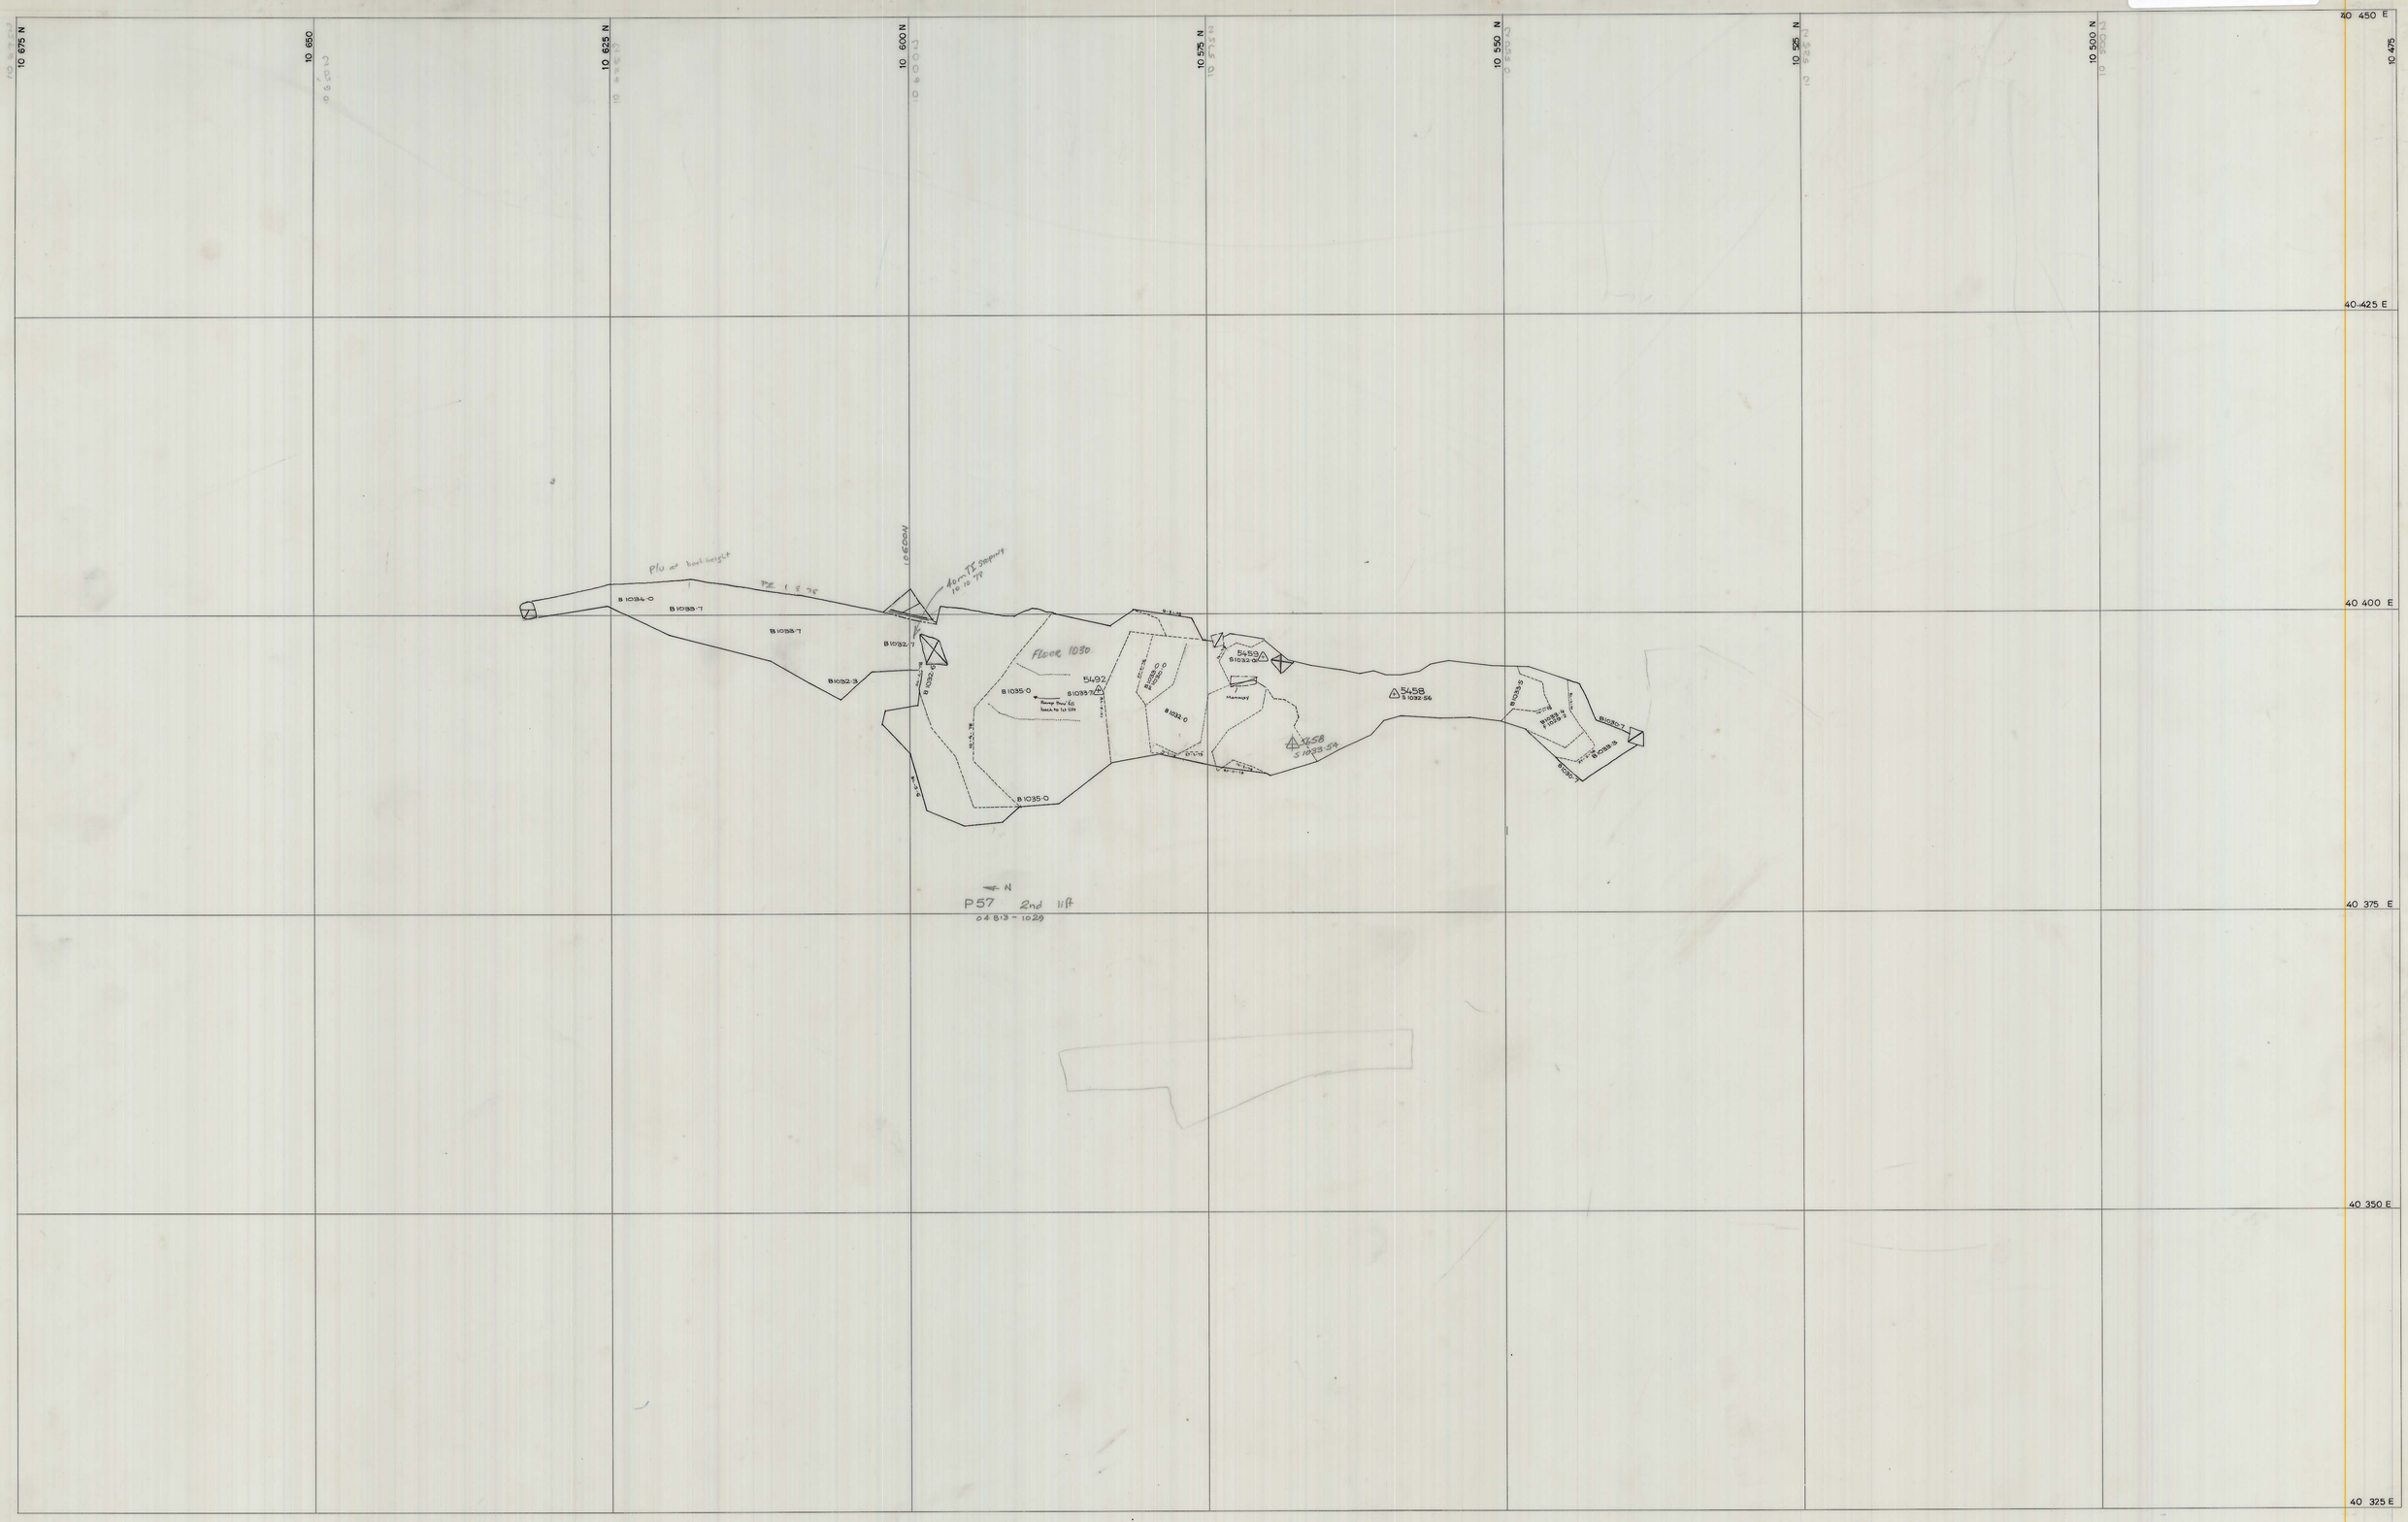

SCALE 1 : 250.

Note - Northern Part of Lift 2 - For this lift the floor was not filled - See Lift 1

north

LOCATION

SUBJECT

P 57 STOPE

[LIFT N° 2]

KING ISLAND SCHEELITE
A DIVISION OF WARMAN INTERNATIONAL

GRASSY KING ISLAND

PLAN NUMBER

04BH13-1029