27 JUN 1981

5 cm

04BH13-1028

0374_4295

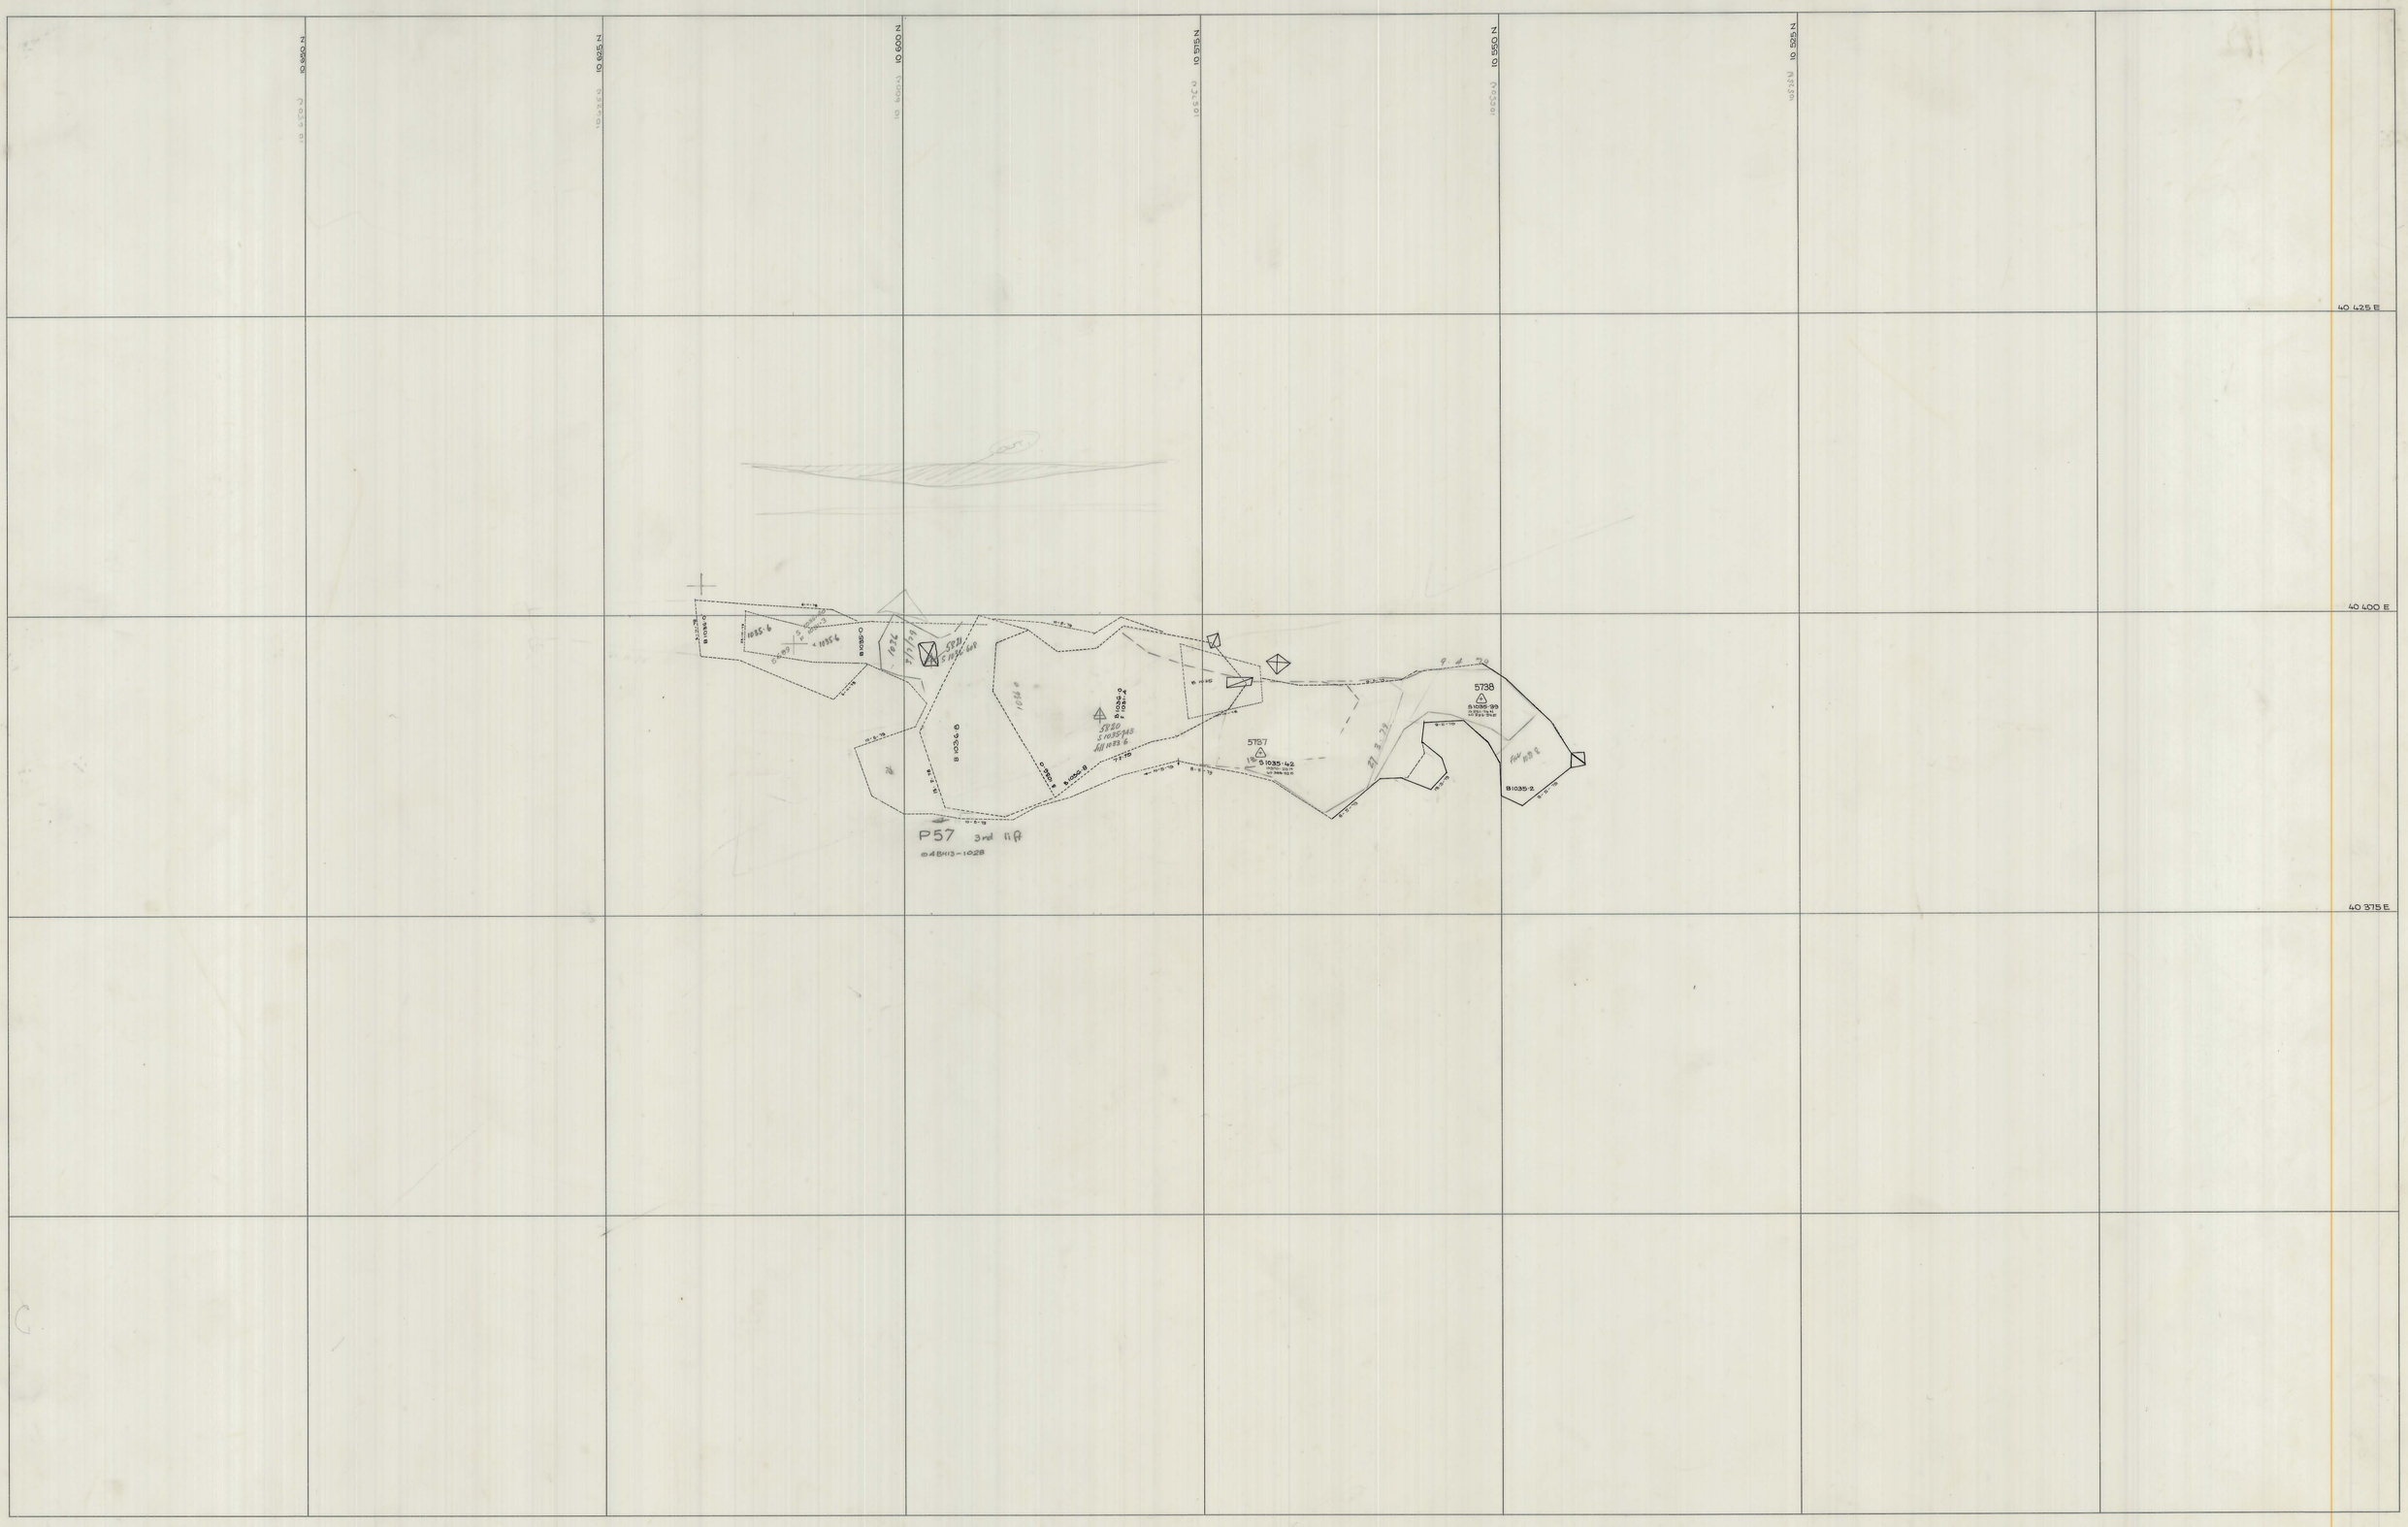


| | | | |
|---|---|---|---|
| SCALE 1: 250 | north | LOCATION BOLD HEAD MINE<br>SUBJECT P 57 3rd lift | KING ISLAND SCHEELITE<br>A DIVISION OF WARMAN INTERNATIONAL<br>GRASSY KING ISLAND<br>PLAN NUMBER 04BH13 - 1028 |