5 cm

04BH12 - 155 271S

0374_4296

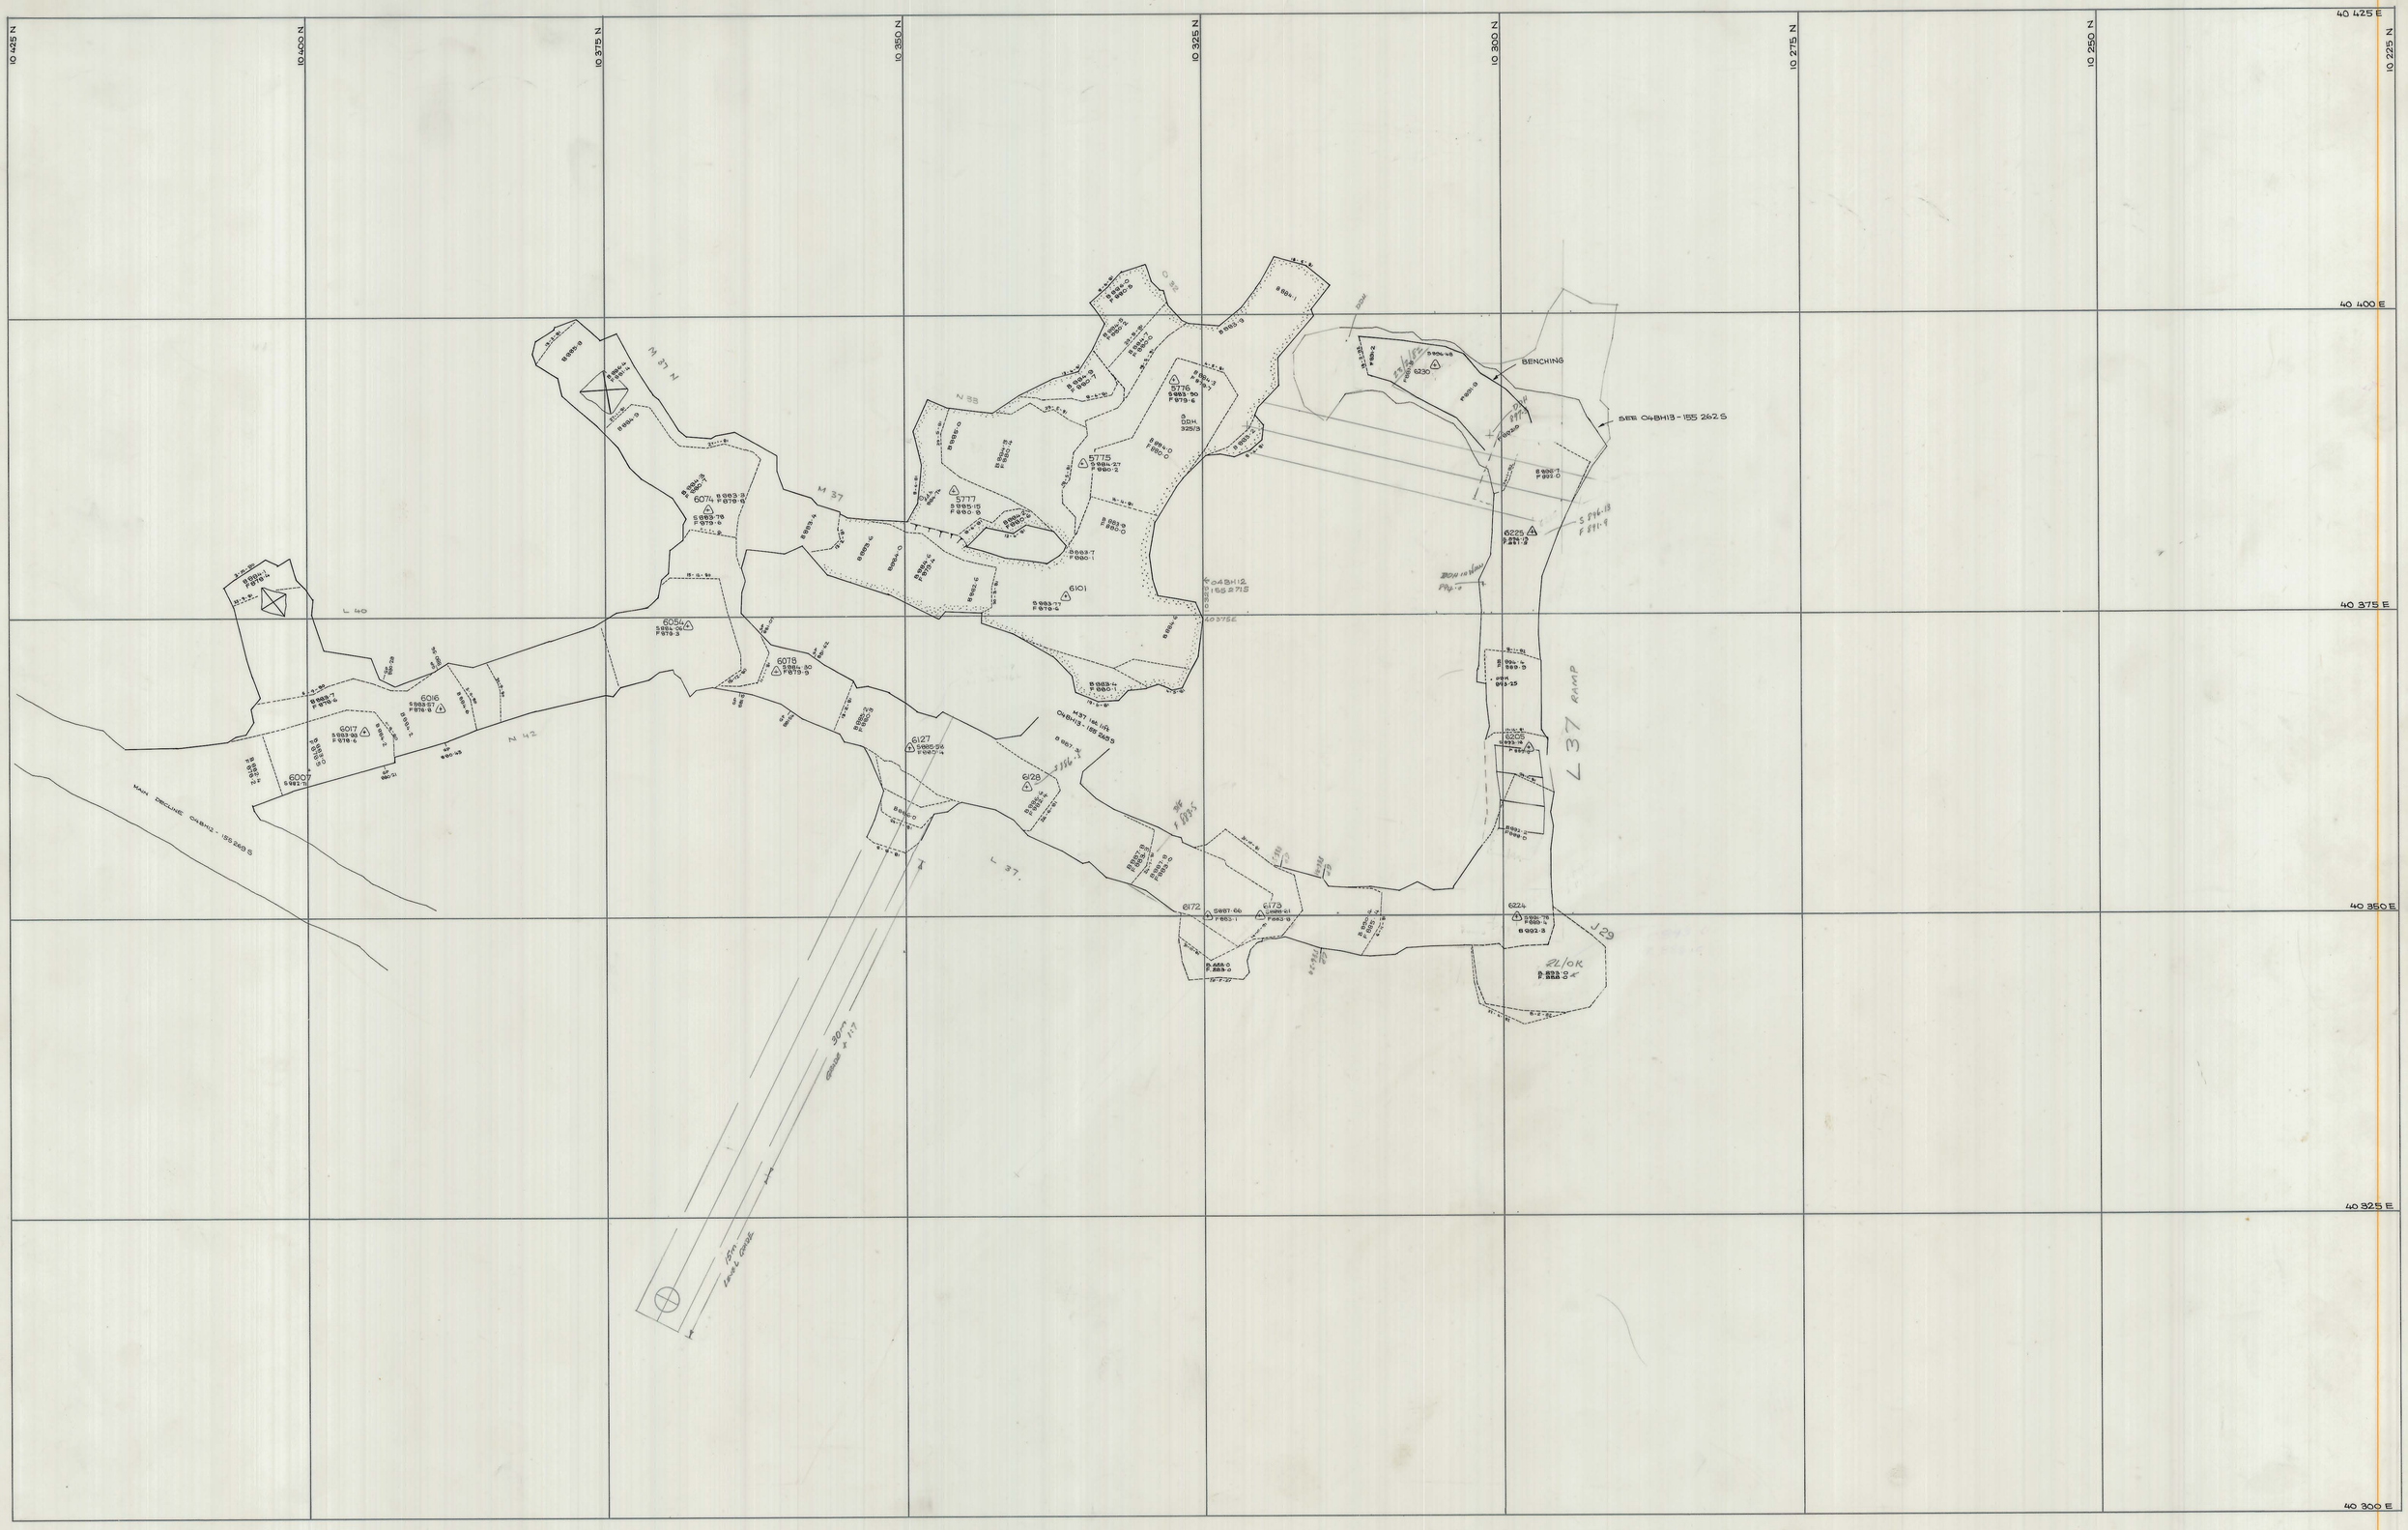

SCALE 1: 250	north	LOCATION: BOLD HEAD MINE SUBJECT: LOWER FAULT BLOCK ACCESS & M 37 STOPE UNDERCUT	KING ISLAND SCHEELITE A DIVISION OF WARMAN INTERNATIONAL GRASSY KING ISLAND PLAN NUMBER: 04BH12 - 155 271 S