27 JUN 1981

5 cm

04BH12-166225

DECLINE
R60
P64
059

0374_4304

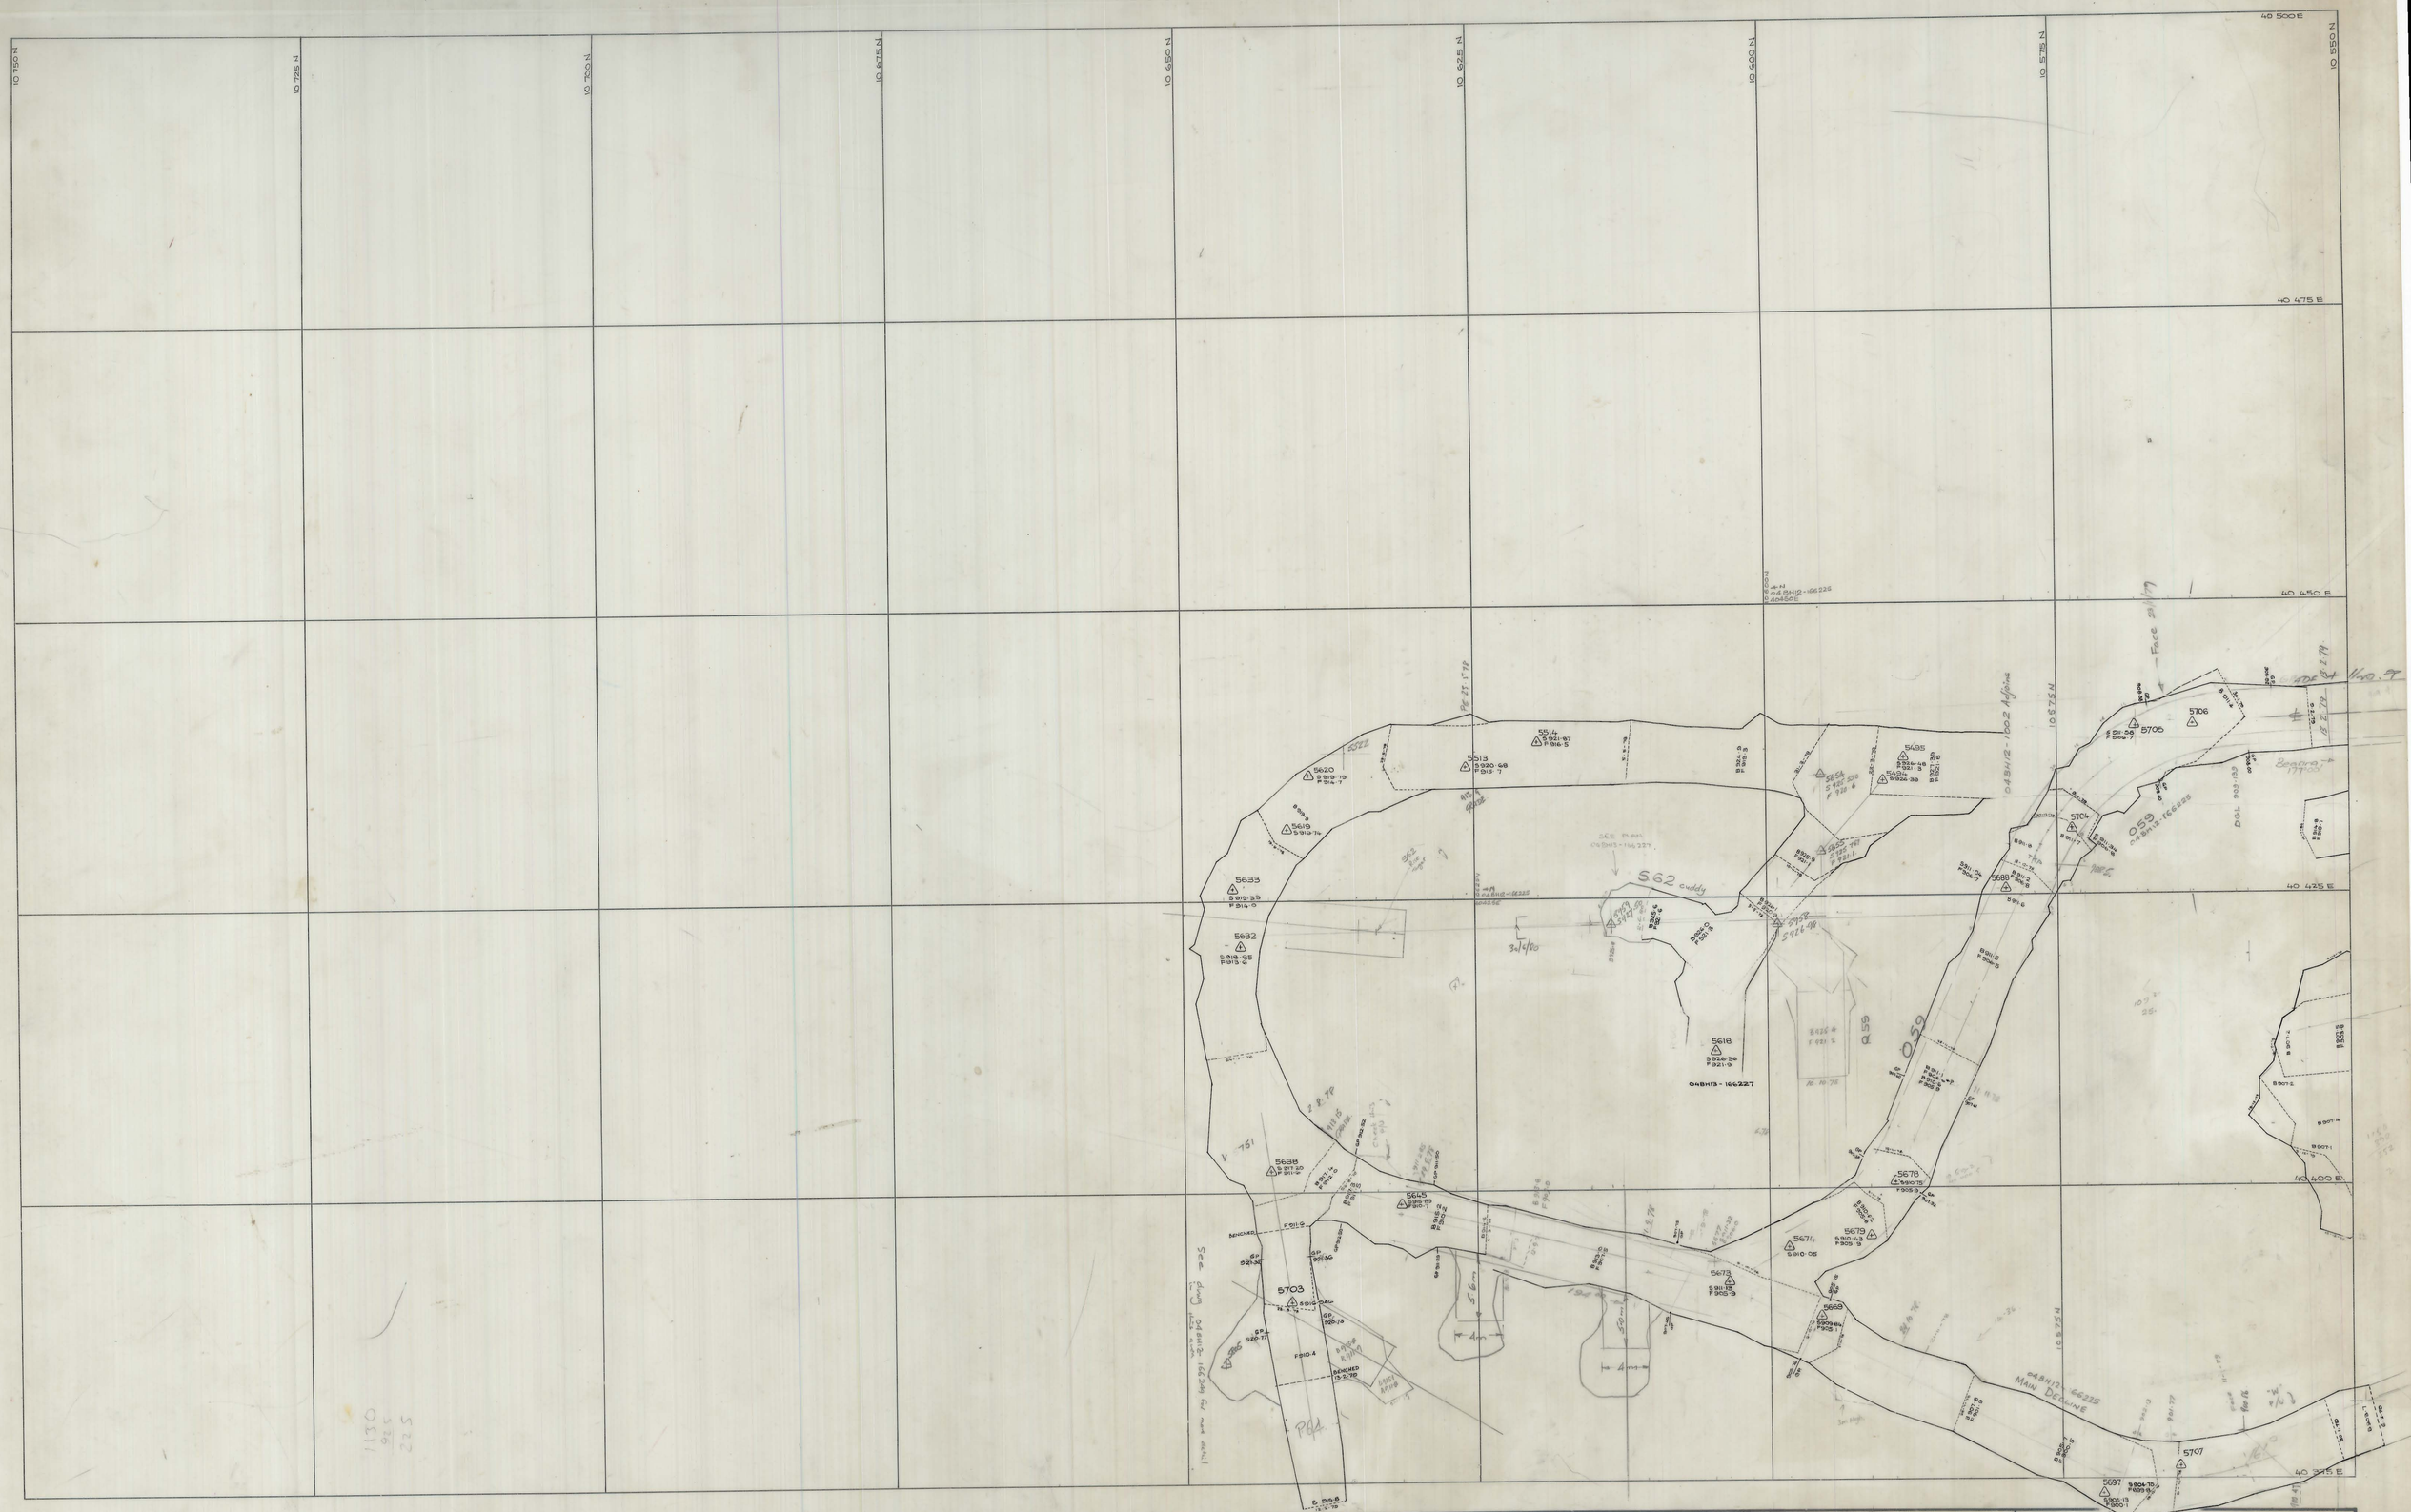

SCALE 1:250 See 03BH03-3002 for design for Decline & 059 See 03BH04-3001 for design for P64	north	LOCATION: BOLD HEAD MINE SUBJECT: MAIN DECLINE	KIS KING ISLAND SCHEELITE A DIVISION OF WARMAN INTERNATIONAL GRASSY KING ISLAND PLAN NUMBER 04BH12 - 166 225