27 JUN 1981

5 cm

04 BH13 - 1004

0374_4306

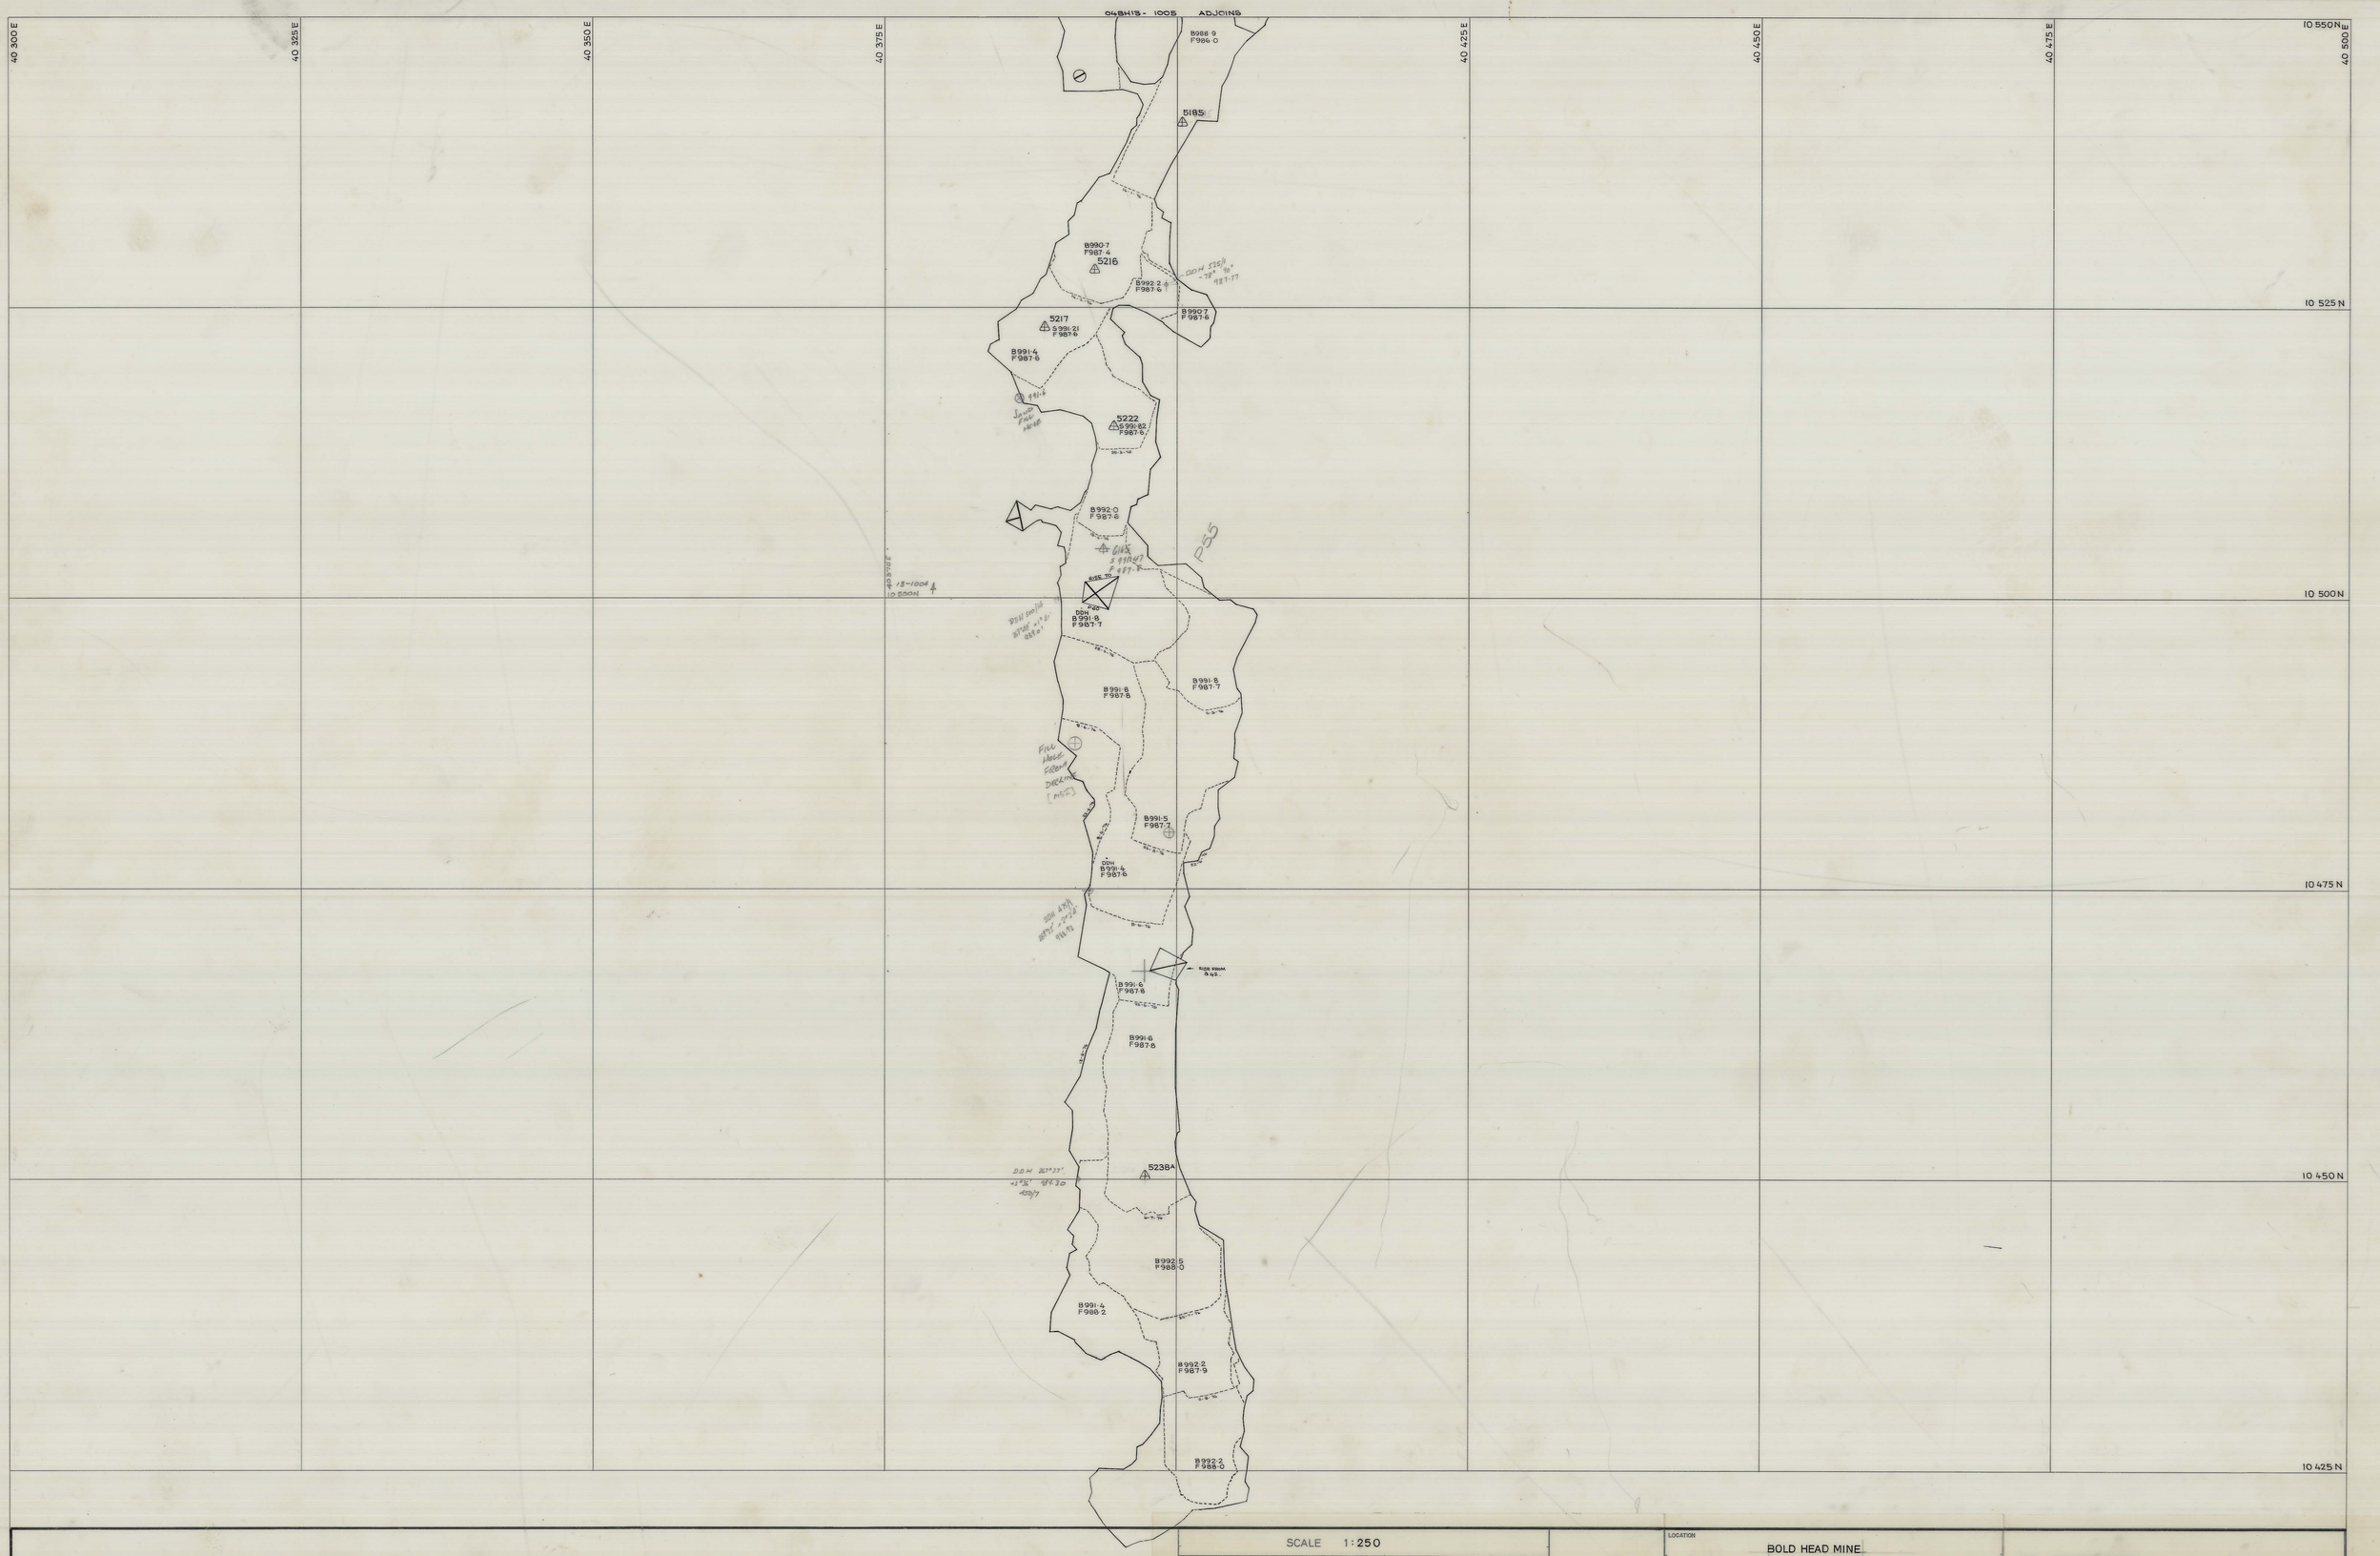

SCALE 1:250

north

LOCATION: BOLD HEAD MINE

SUBJECT: 980M TO 1000M BACK RL

KING ISLAND SCHEELITE
A DIVISION OF WARMAN INTERNATIONAL

GRASSY KING ISLAND

PLAN NUMBER: 04BH13 - 1004