27 JUN 1981

04BH12 - 166 192S

L60
Q63

0374_4317

5 cm

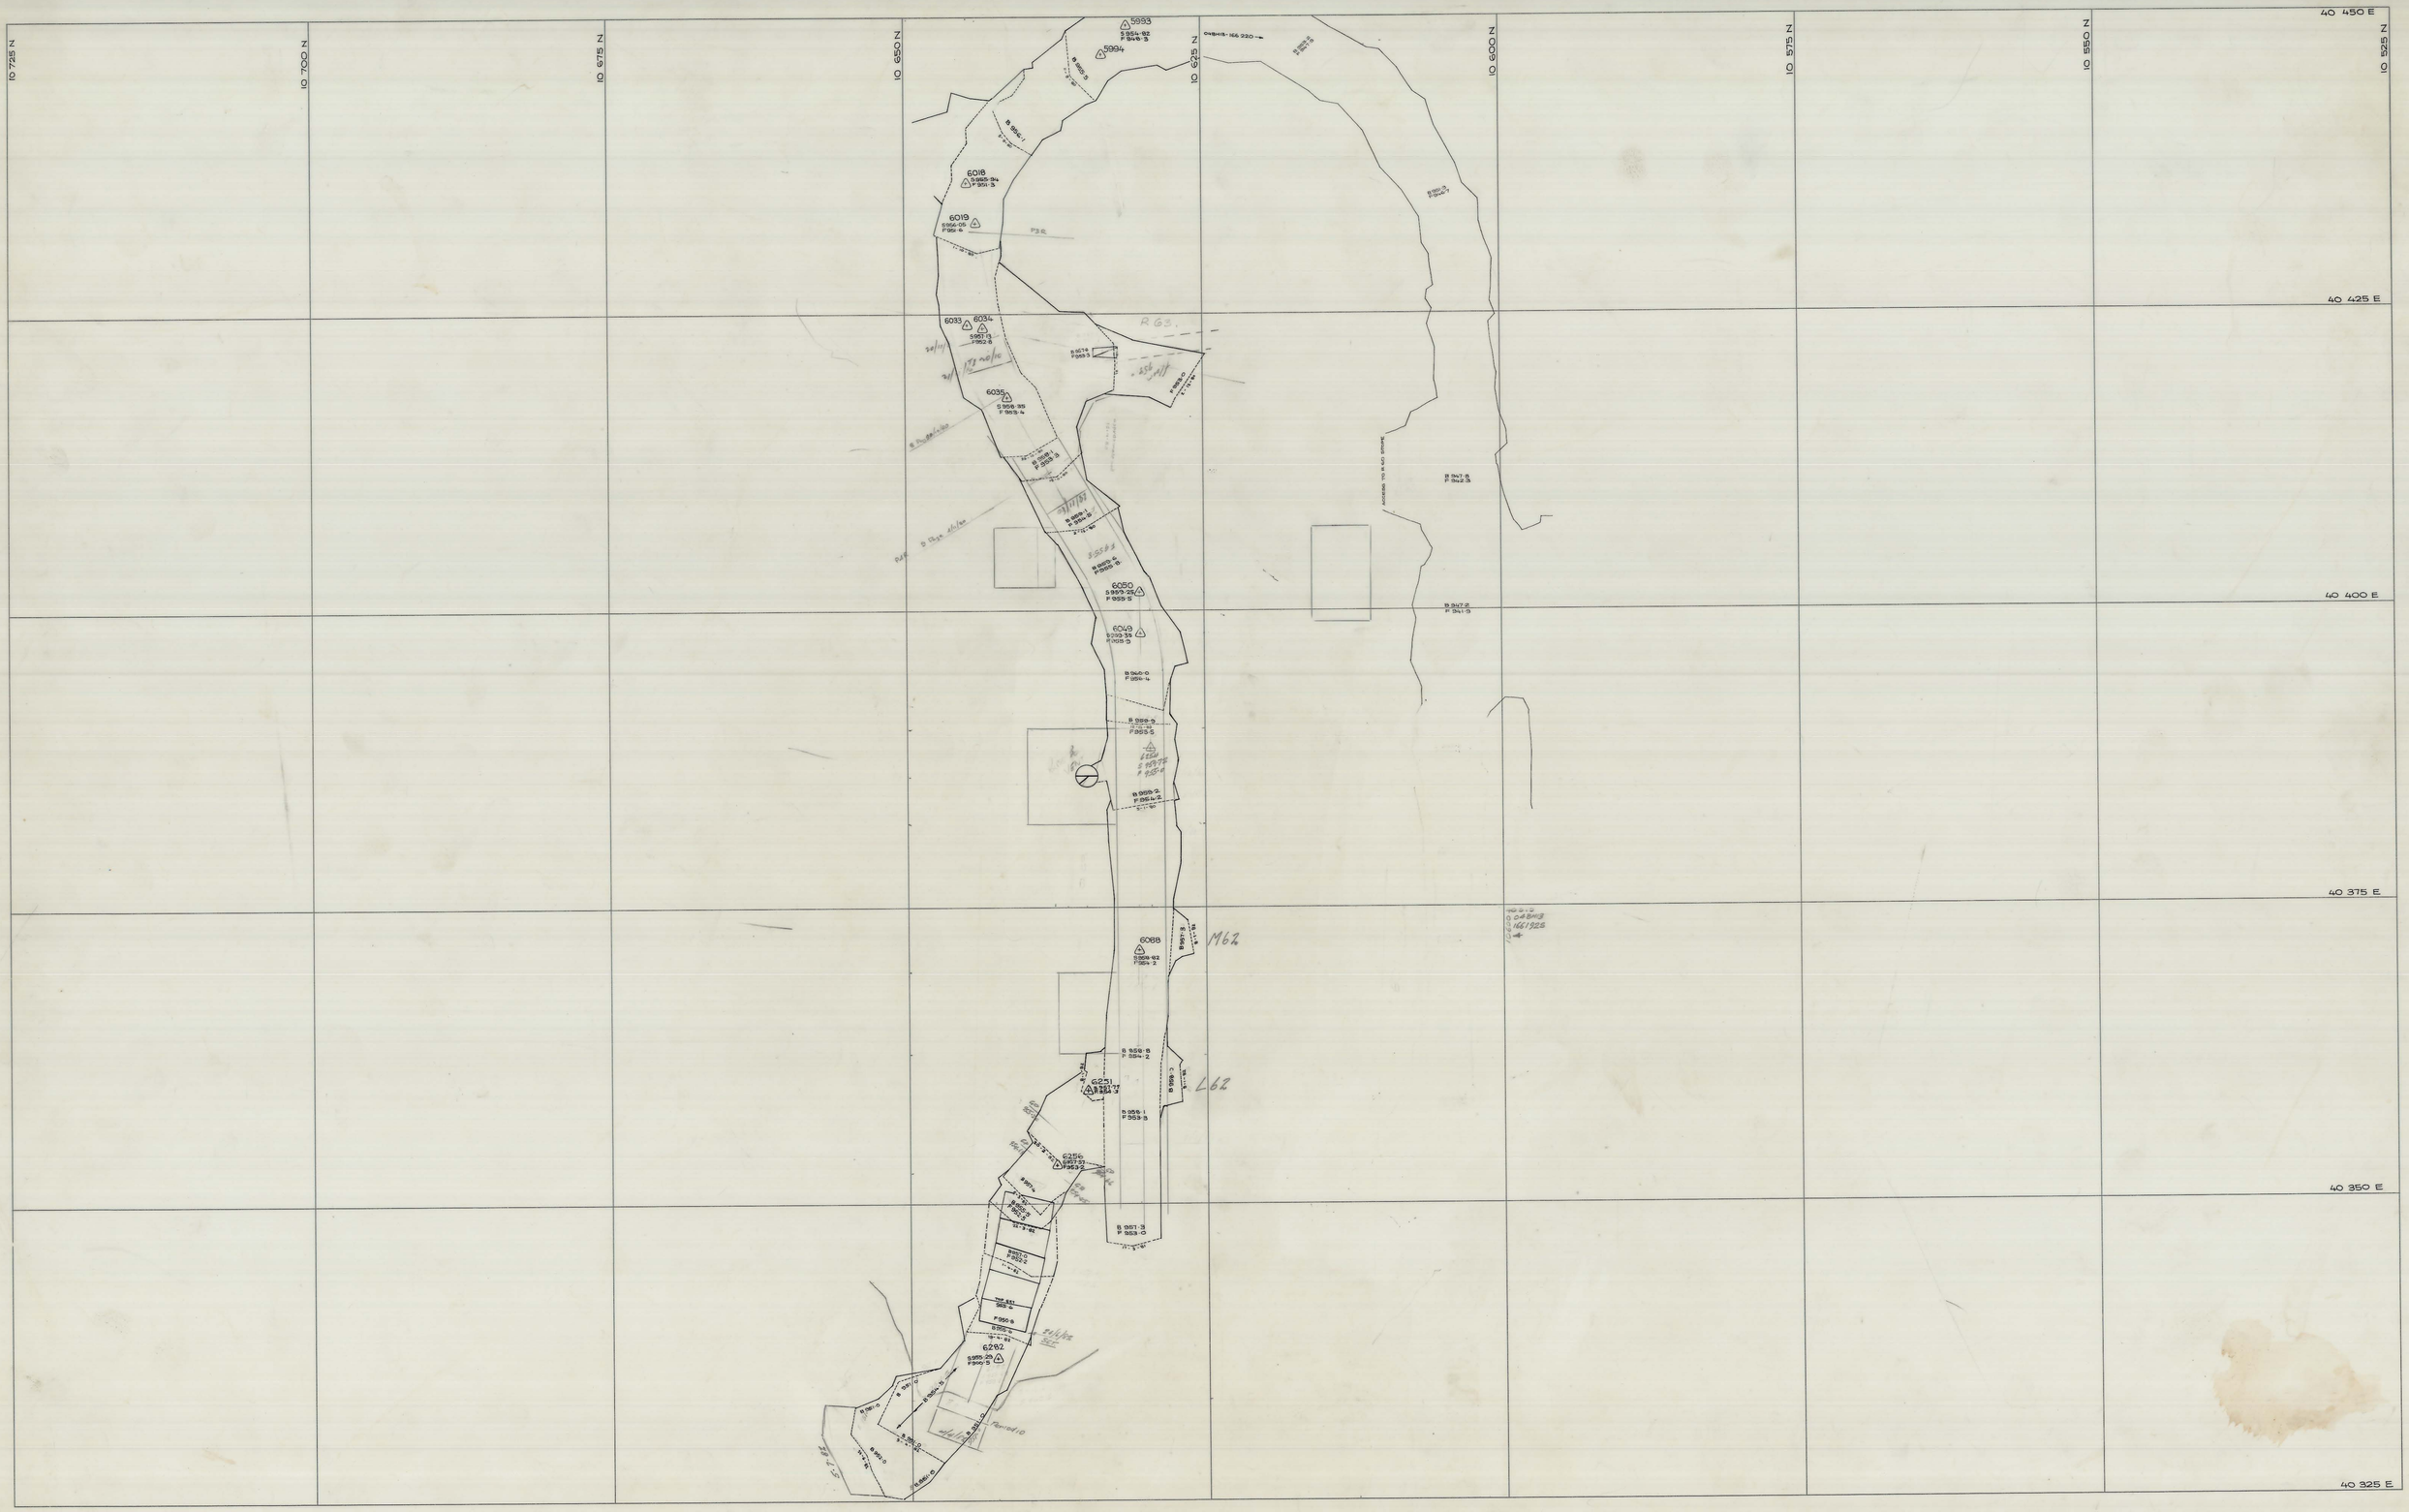

	SCALE 1: 250 Design Plans: L60 03BH04-1009, 03BH04-3005	north	LOCATION BOLD HEAD MINE SUBJECT L 60 Access to C2 lens	KIS KING ISLAND SCHEELITE A DIVISION OF WARMAN INTERNATIONAL GRASSY KING ISLAND PLAN NUMBER 04BH12 - 166 192 S