27 JUN 1981

5 cm

04BH13 - 1024

O374_4318

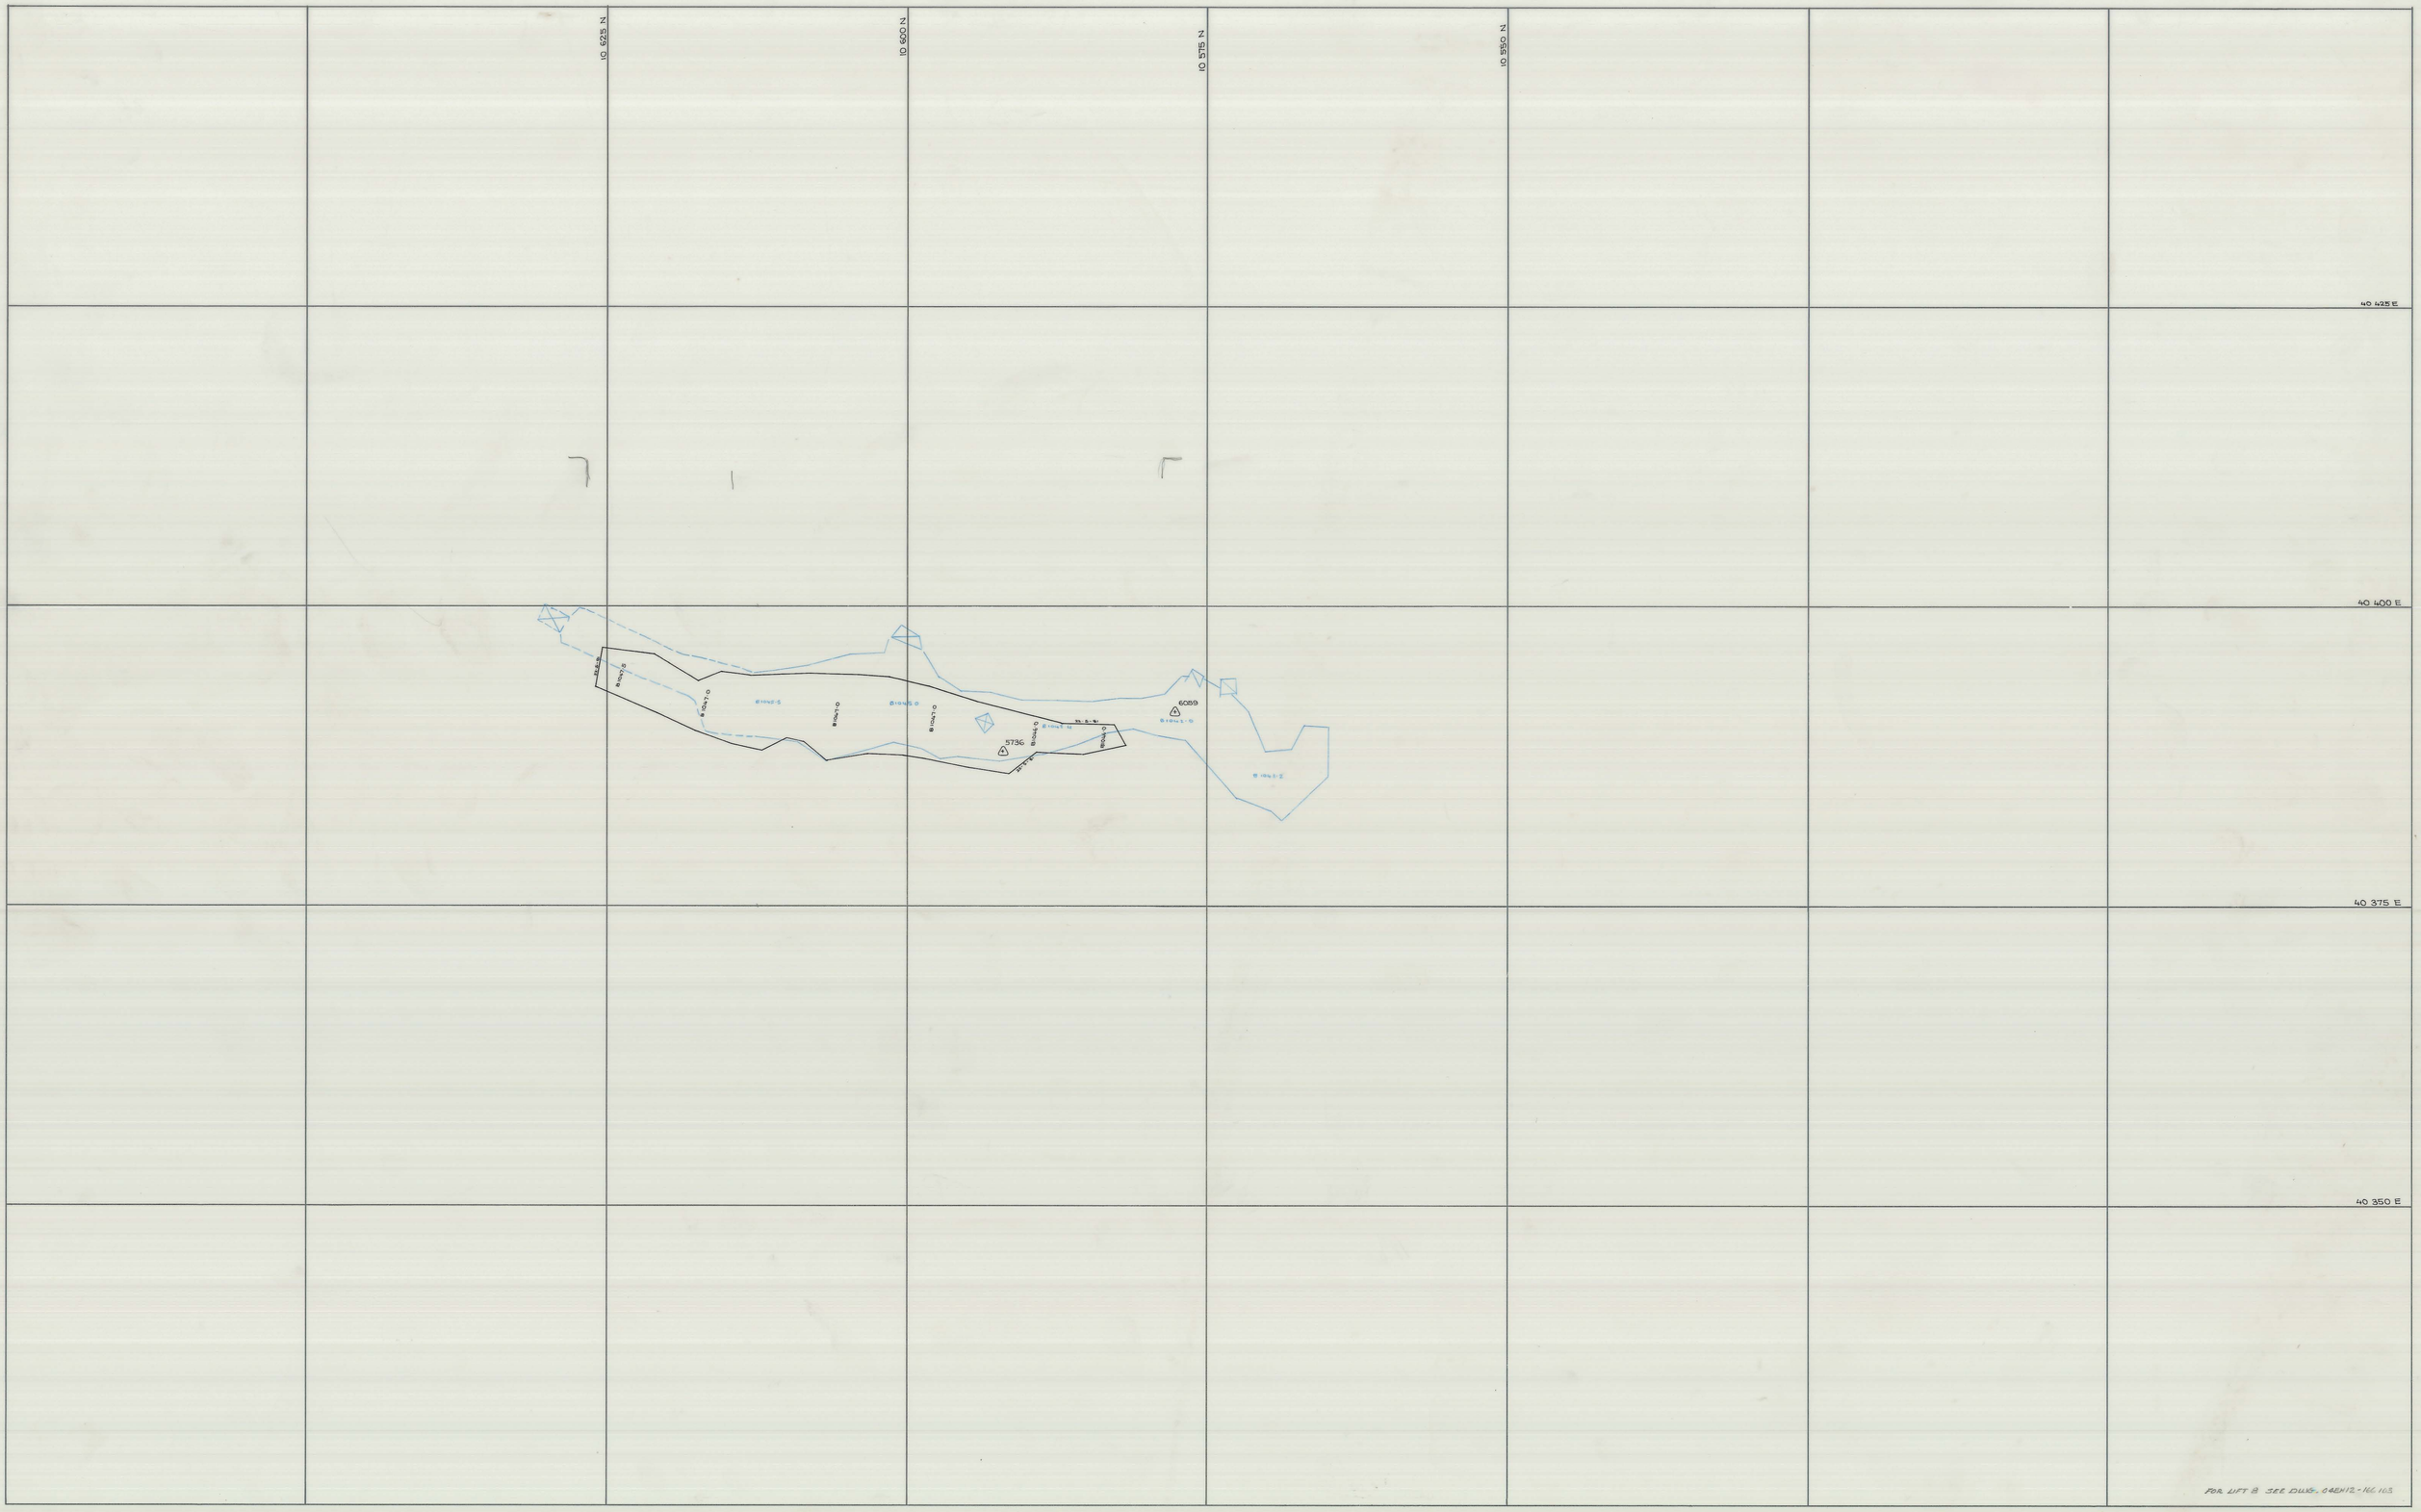

	SCALE 1:250	north	LOCATION: BOLD HEAD MINE SUBJECT: P 57 7th lift	KING ISLAND SCHEELITE A DIVISION OF WARMAN INTERNATIONAL GRASSY KING ISLAND Gof MAP/Sh PLAN NUMBER 04BH13 - 1024