5 cm

04BH13 - 155 262S

0374_4324

M37
LIFT 2

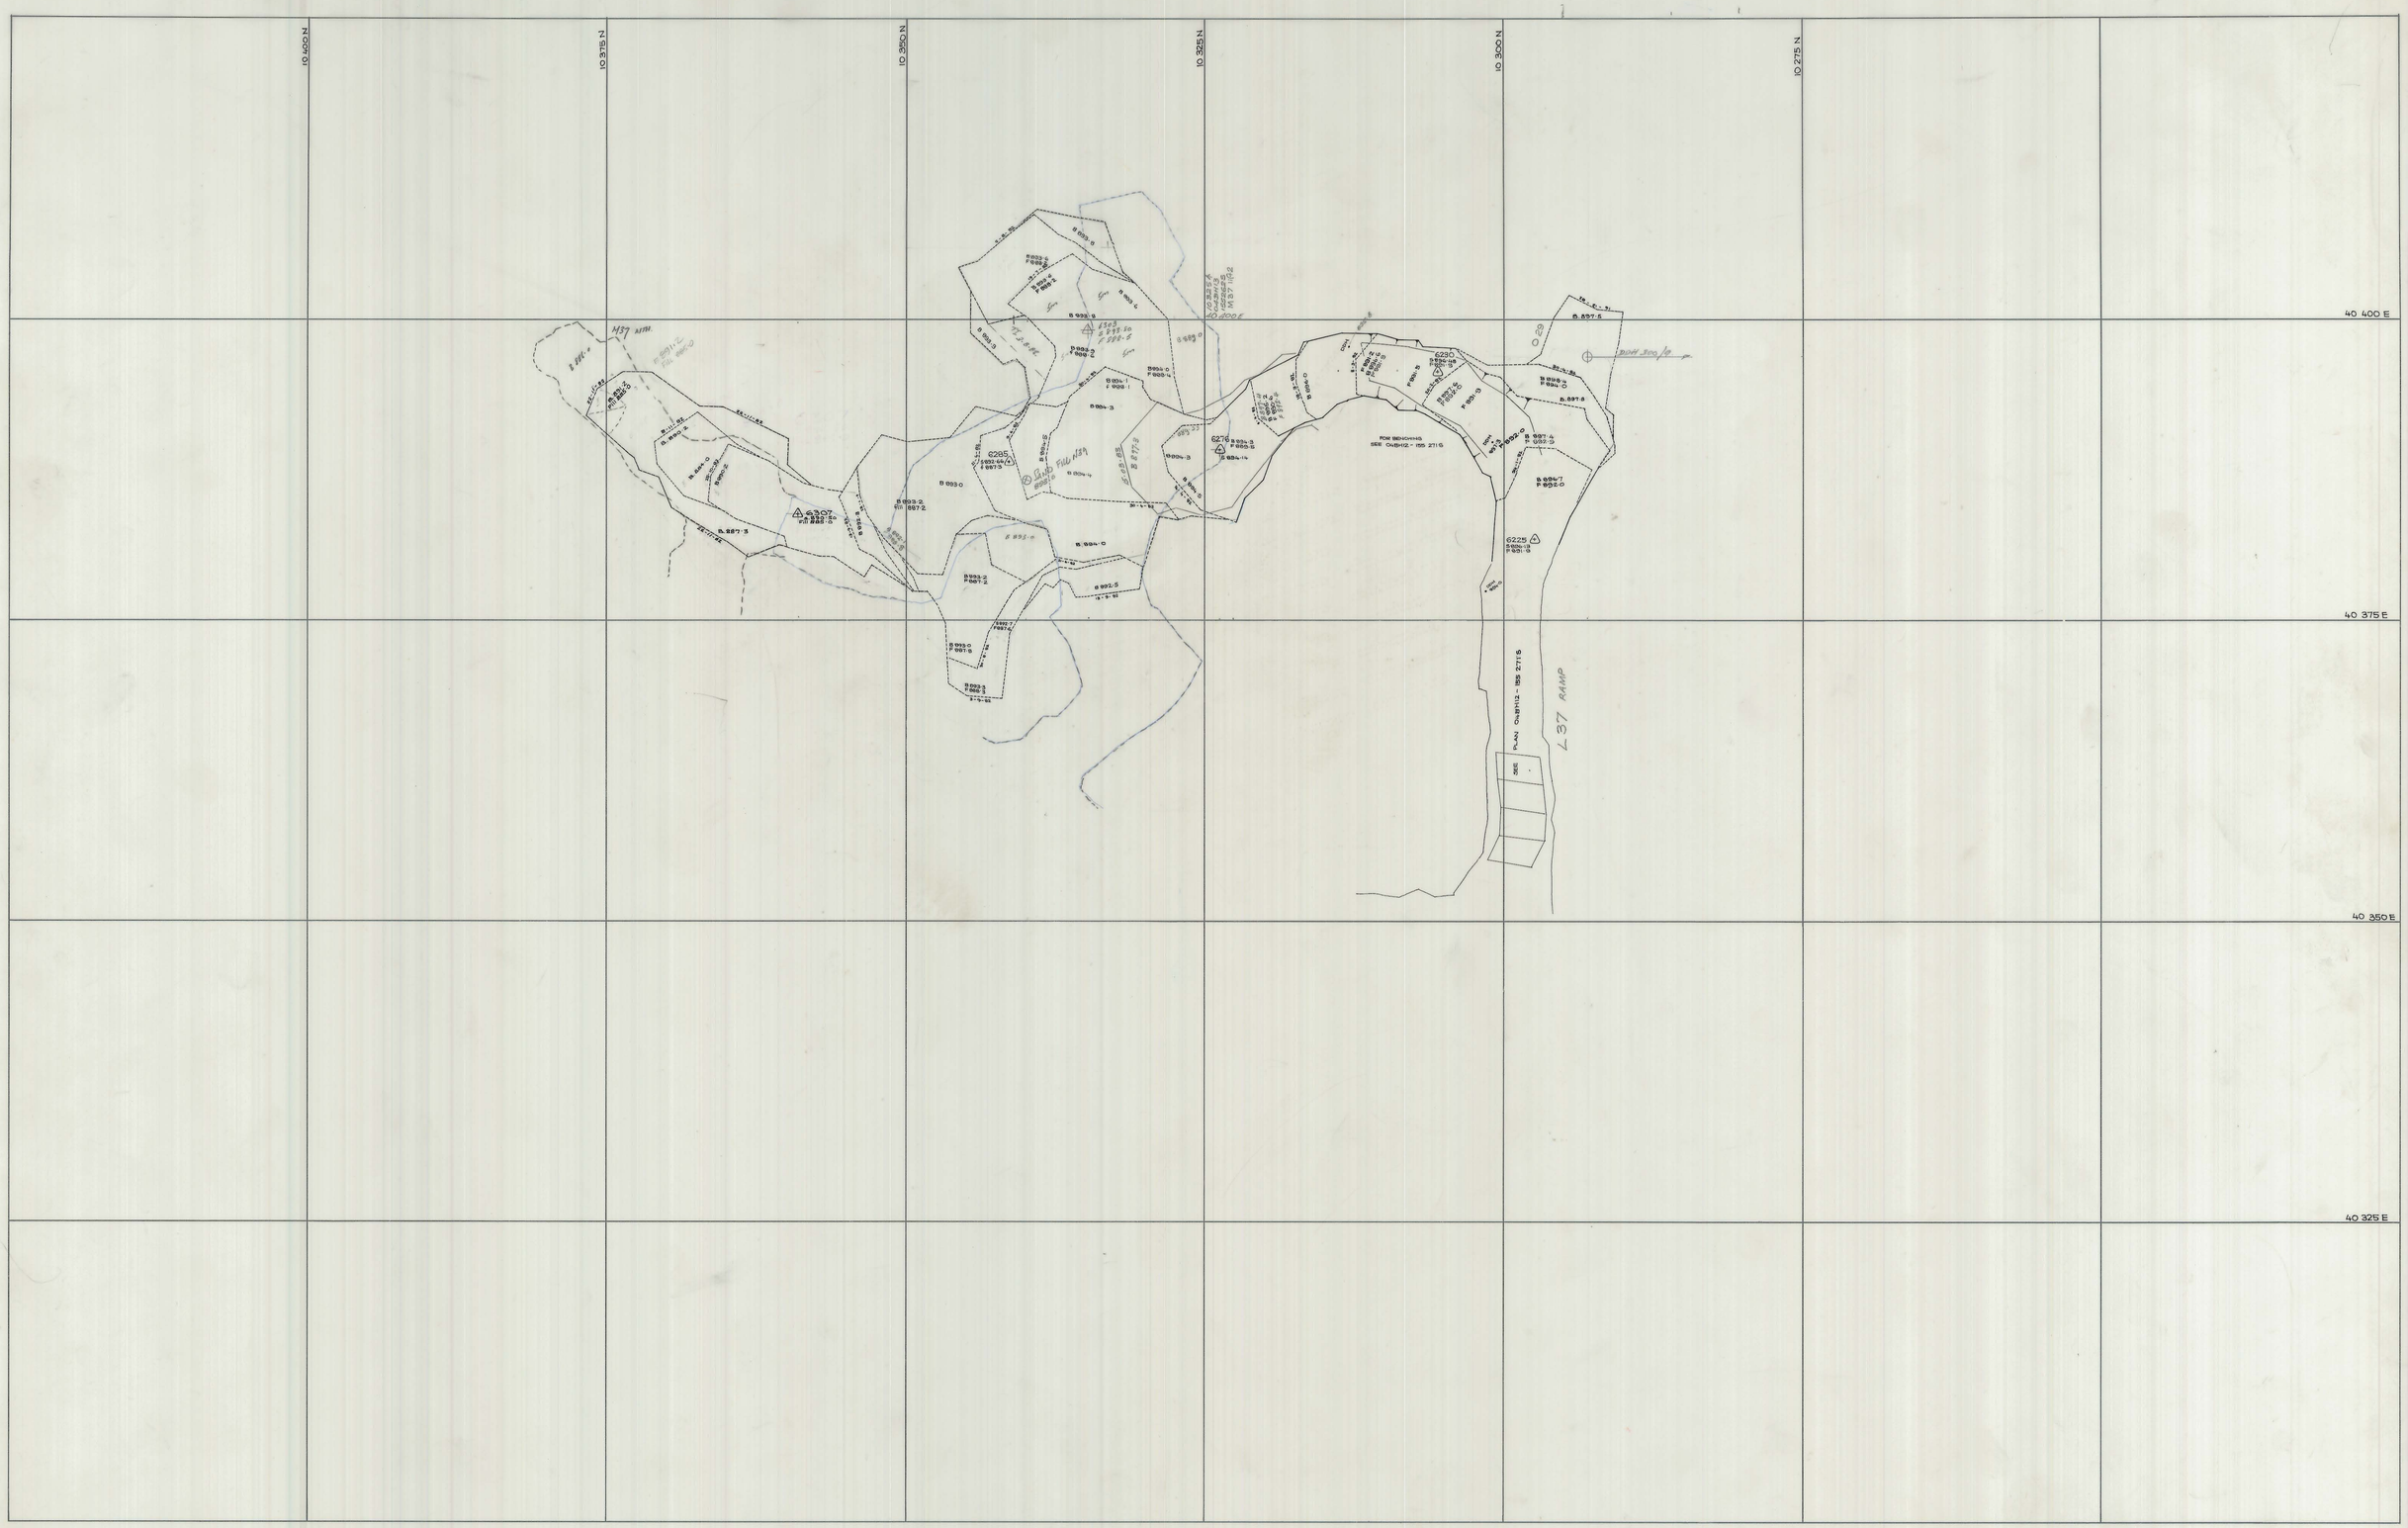

	SCALE 1: 250	north	LOCATION: BOLD HEAD MINE SUBJECT: M 37 STOPE 2nd lift	KING ISLAND SCHEELITE A DIVISION OF WARMAN INTERNATIONAL GRASSY KING ISLAND Grid Mark'n PLAN NUMBER 04BH13 - 155 262 S