27 JUN 1994

5 cm

04BH13-155 265S

M37
LIFT 1

0374_4325

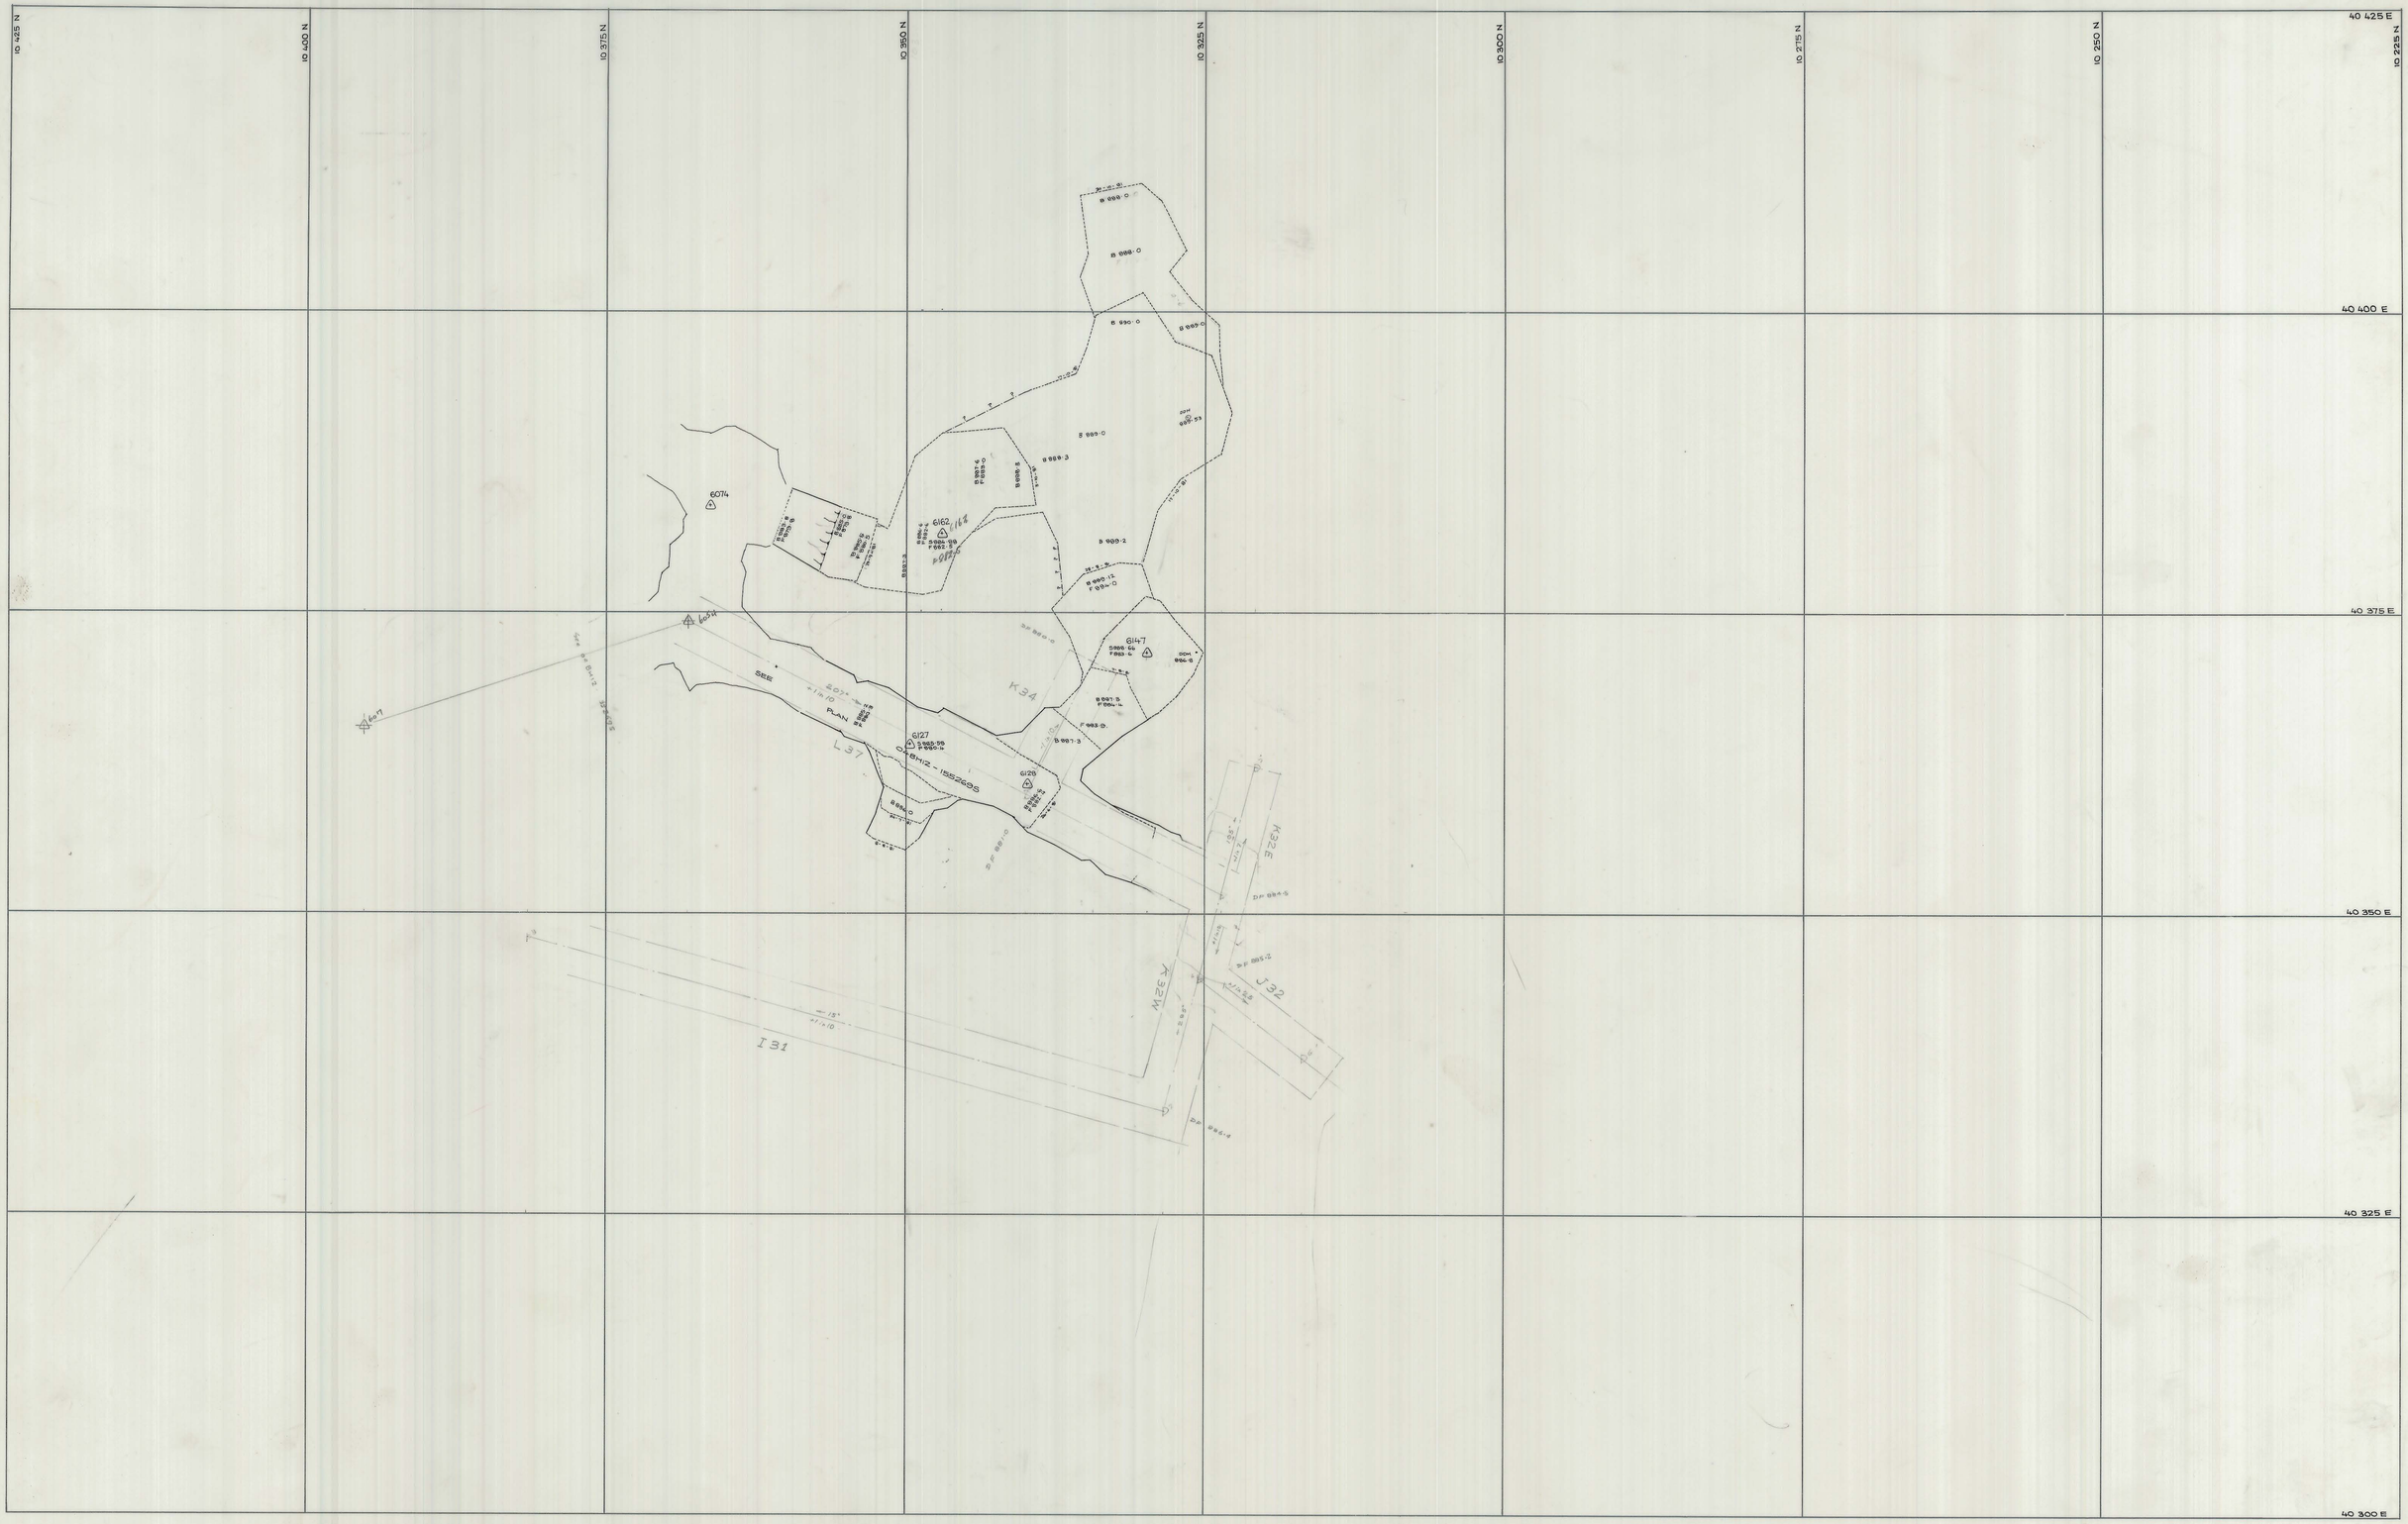

SCALE 1: 250	north	LOCATION: BOLD HEAD MINE SUBJECT: M 37 STOPE - 1st lift	KING ISLAND SCHEELITE A DIVISION OF WARMAN INTERNATIONAL GRASSY KING ISLAND PLAN NUMBER: 04BH13 - 155 265 S