27 JUN 1981

0374 - 437

04DM15 - 1020
SECTIONS JUNE 1984

119

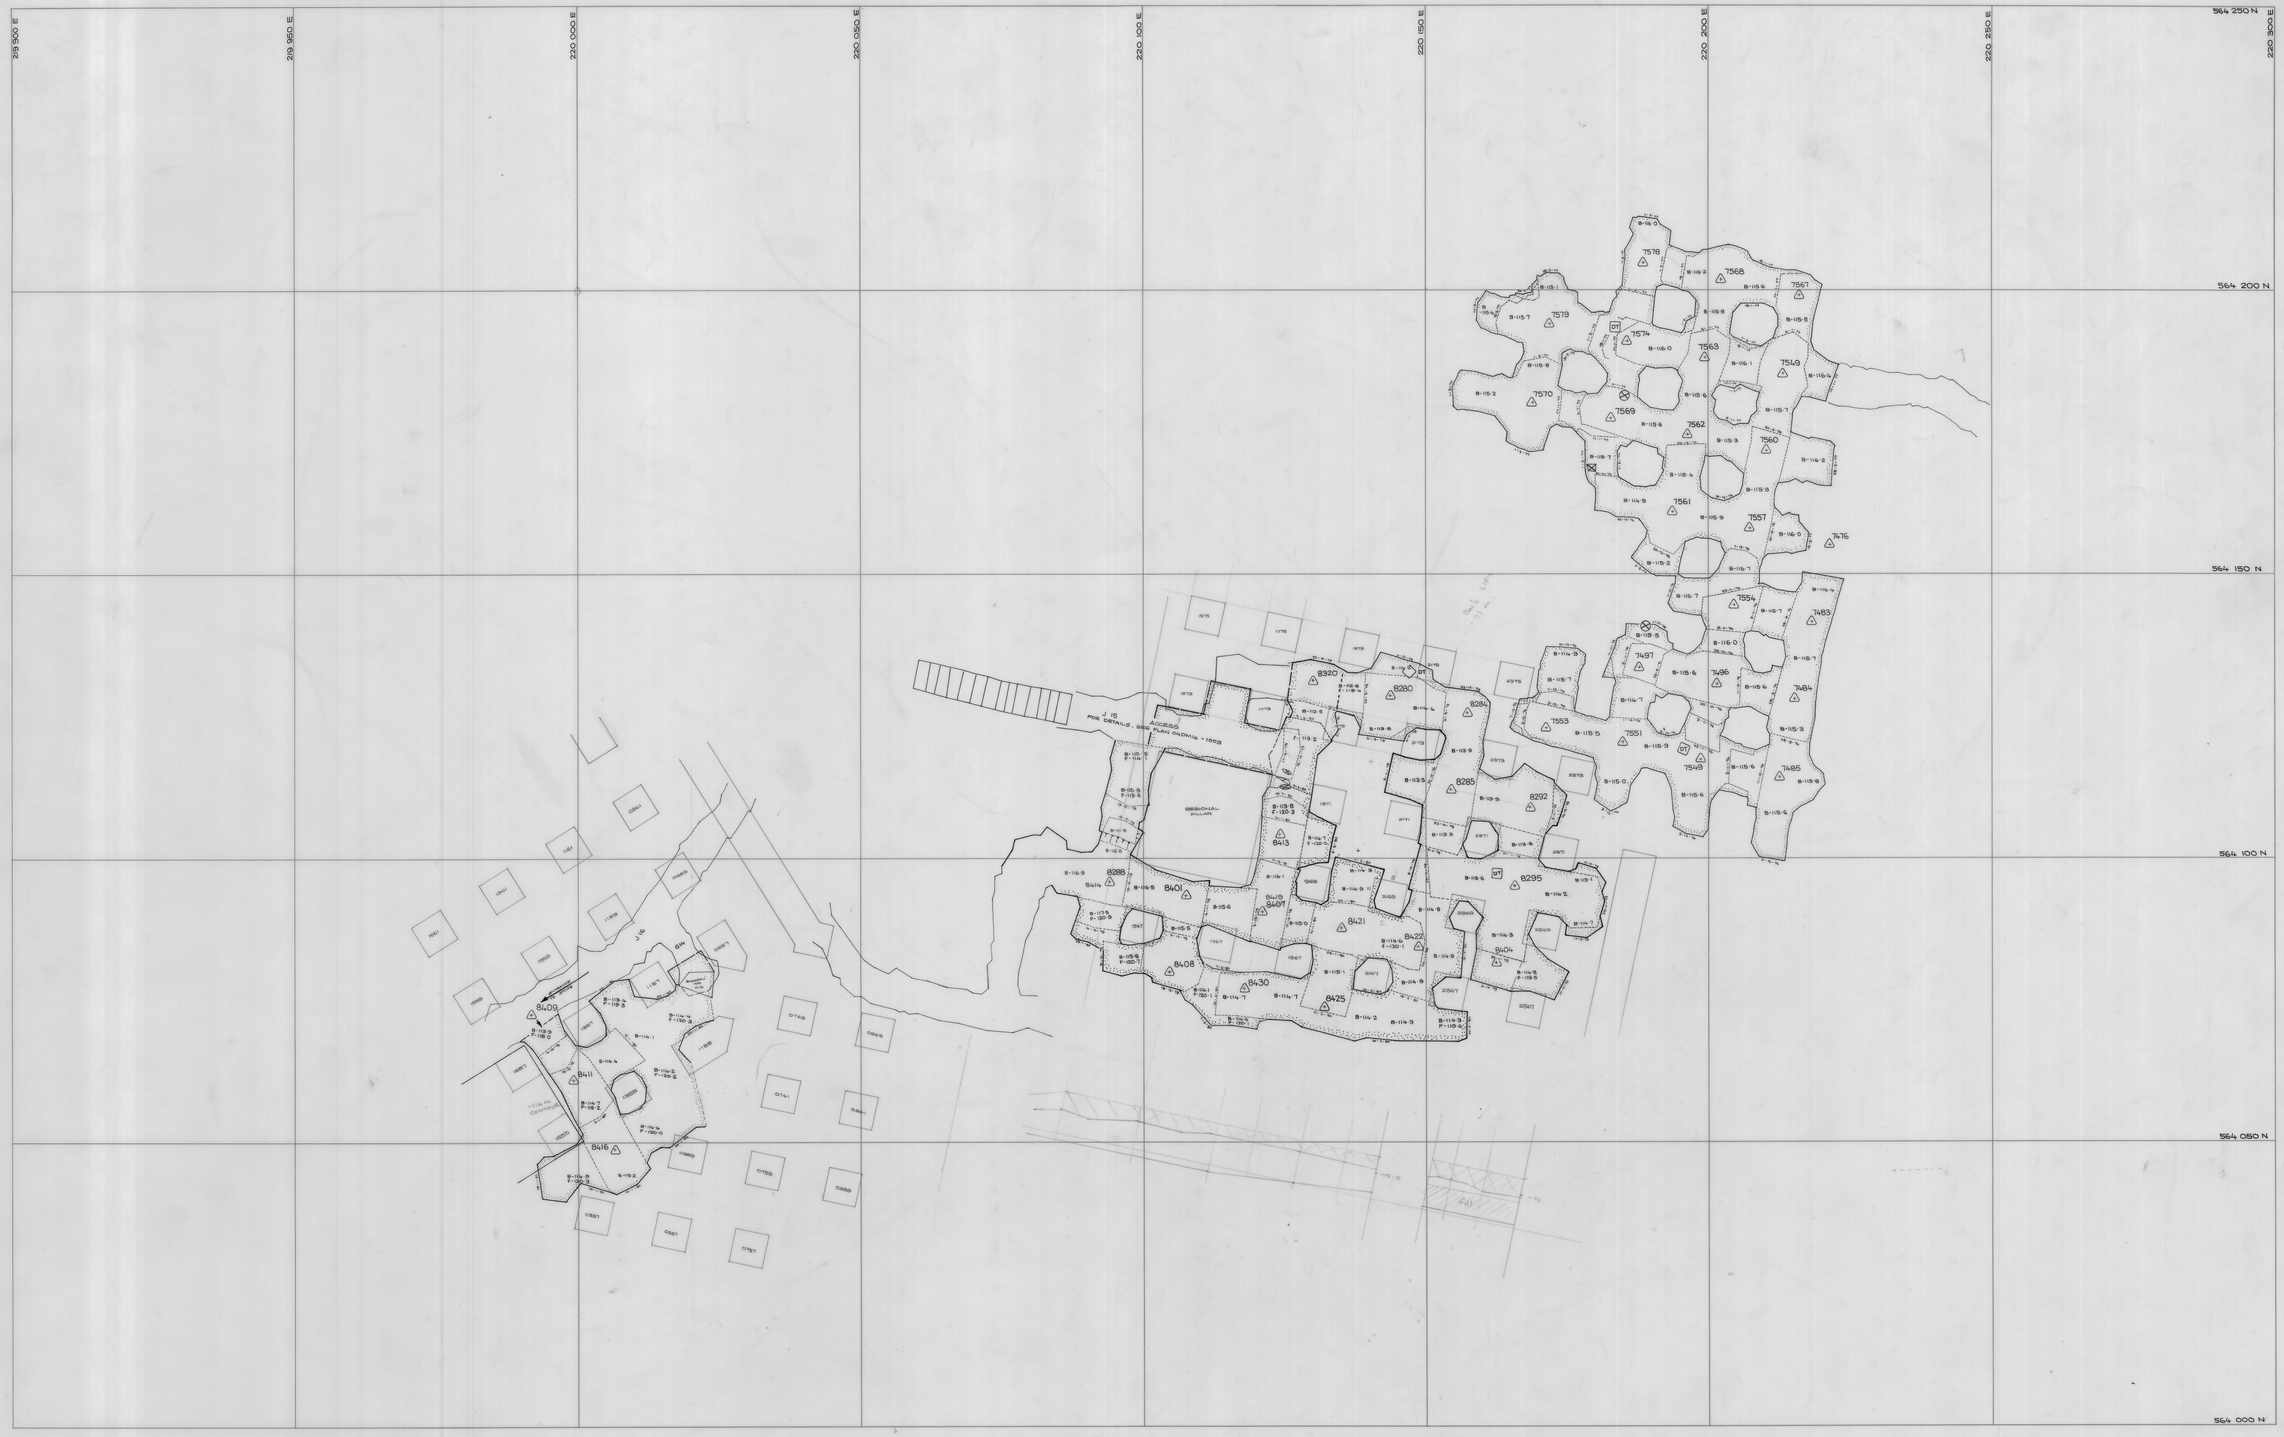

	SCALE 1:500 Note C Wedge Stope - Lift Nº 3 C Central Stope - Lift Nº 9 C Pit Stope - Lift Nº 10 - 117.5 m Contour 5 cm	north	LOCATION: DOLPHIN MINE SUBJECT: C WEDGE, CENTRAL & PIT STOPES - -119 m CONTOUR

KIS KING ISLAND SCHEELITE
A DIVISION OF WARMAN INTERNATIONAL
GRASSY KING ISLAND

PLAN NUMBER
04DM15 - 1020