5 cm

04BH13 - 155 240

0374_4331

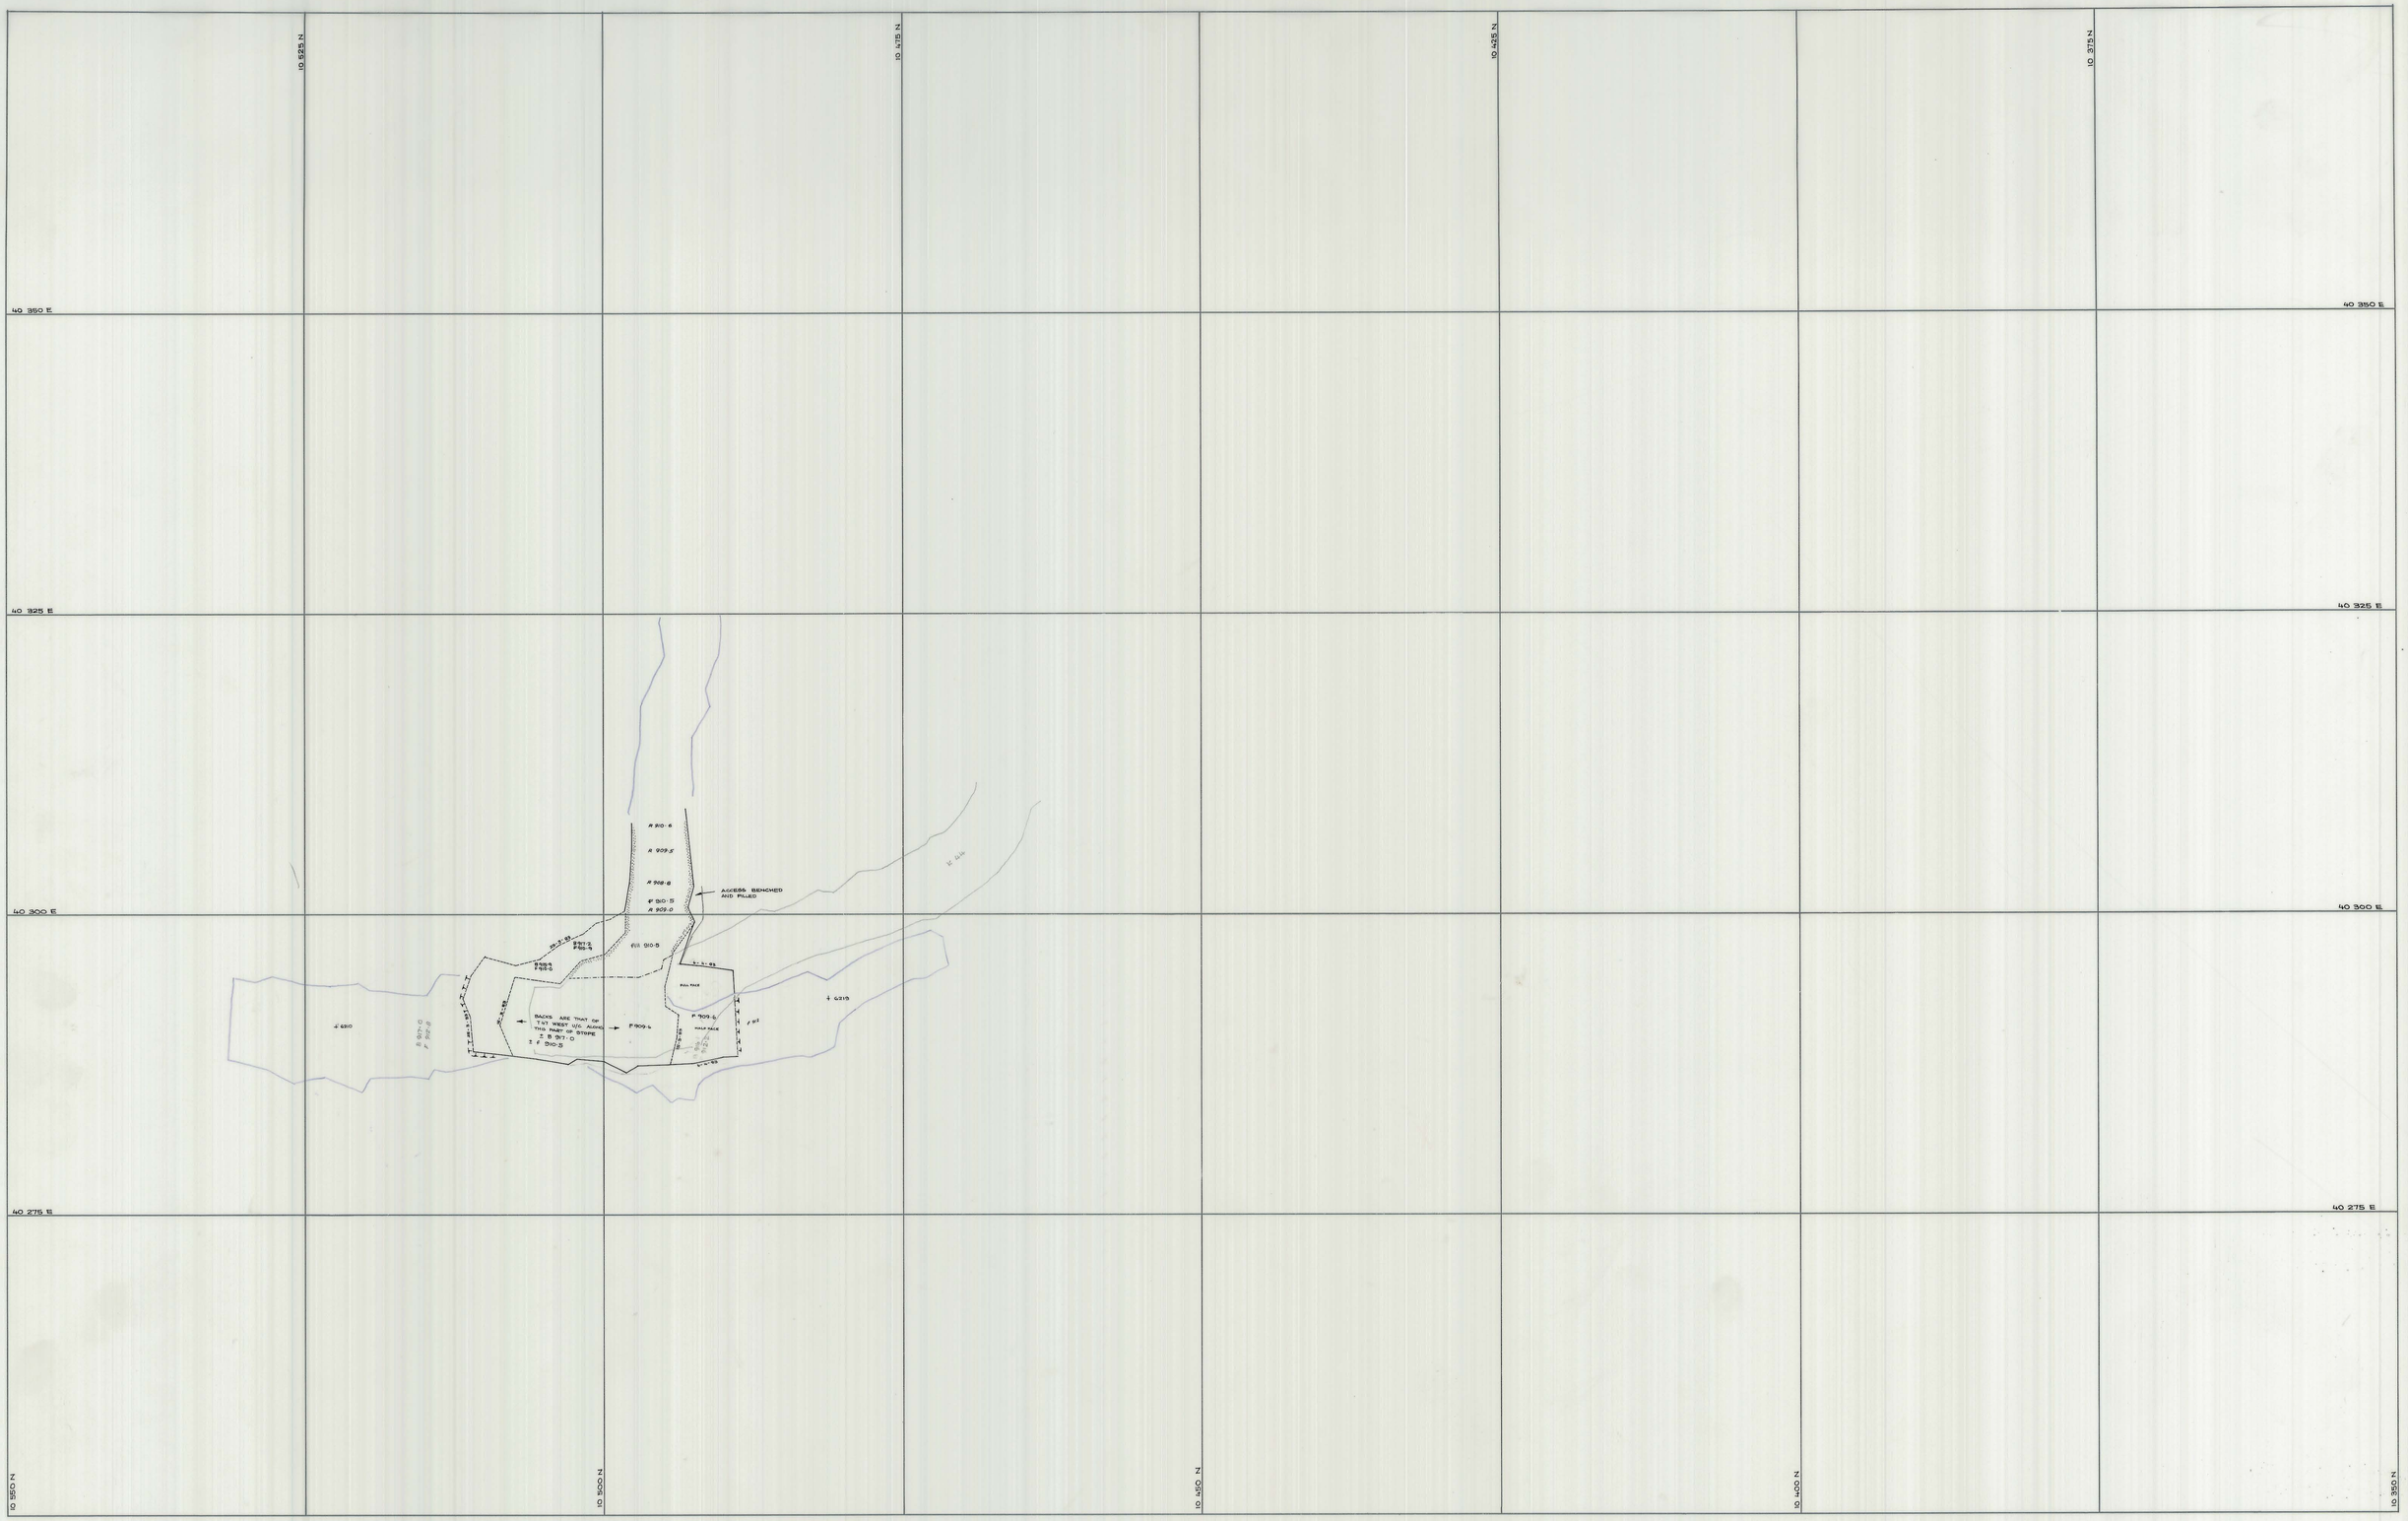

SCALE 1: 250

north

LOCATION

BOLD HEAD MINE

SUBJECT

T47 west - BENCHING

K44 - 1st. lift

KING ISLAND SCHEELITE

A DIVISION OF WARMAN INTERNATIONAL

GRASSY KING ISLAND

GAP MAP No

PLAN NUMBER

04BH13 - 155 240