5 cm

04 BH 13 - 155 241 S

0374_4332

N 51
LIFT 2

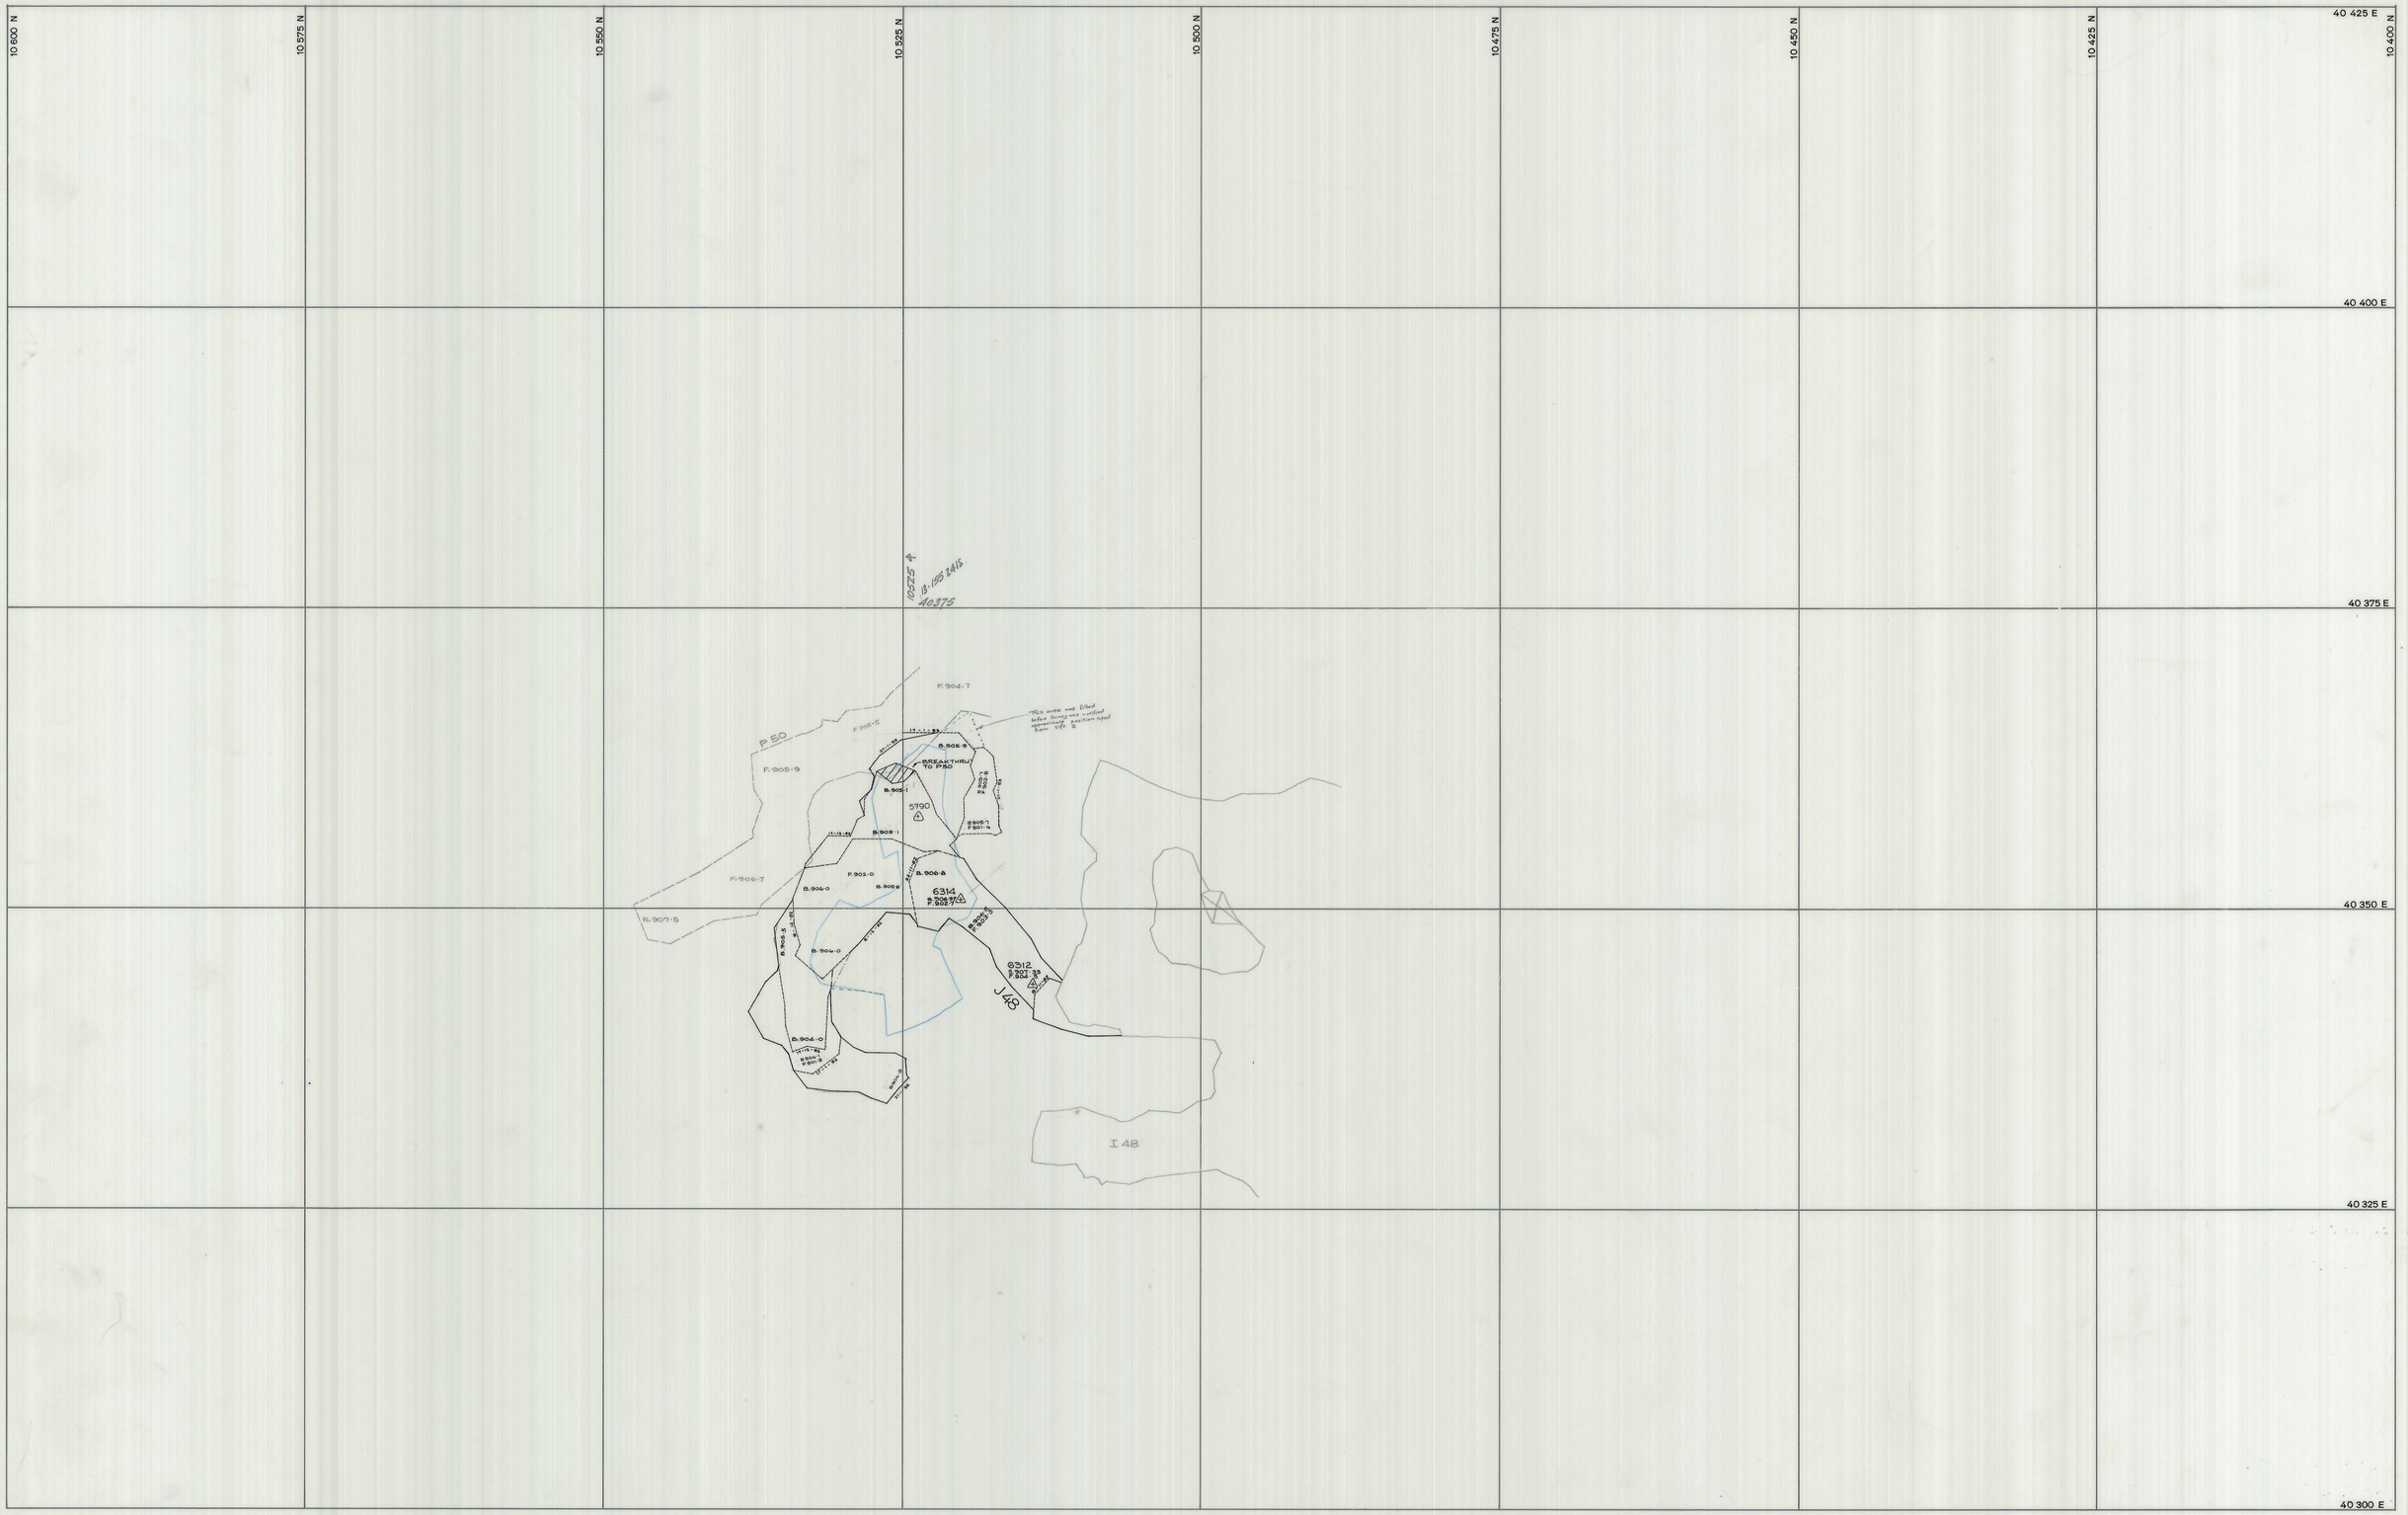

SCALE 1: 250	north	LOCATION: BOLD HEAD MINE SUBJECT: N 51 2nd Lift	KING ISLAND SCHEELITE A DIVISION OF WARMAN INTERNATIONAL GRASSY KING ISLAND PLAN NUMBER: 04BH13 - 155 241 S