27 JUN 1981

5 cm

04BH13-156 206S

0374_4347

046
LIFT 7.

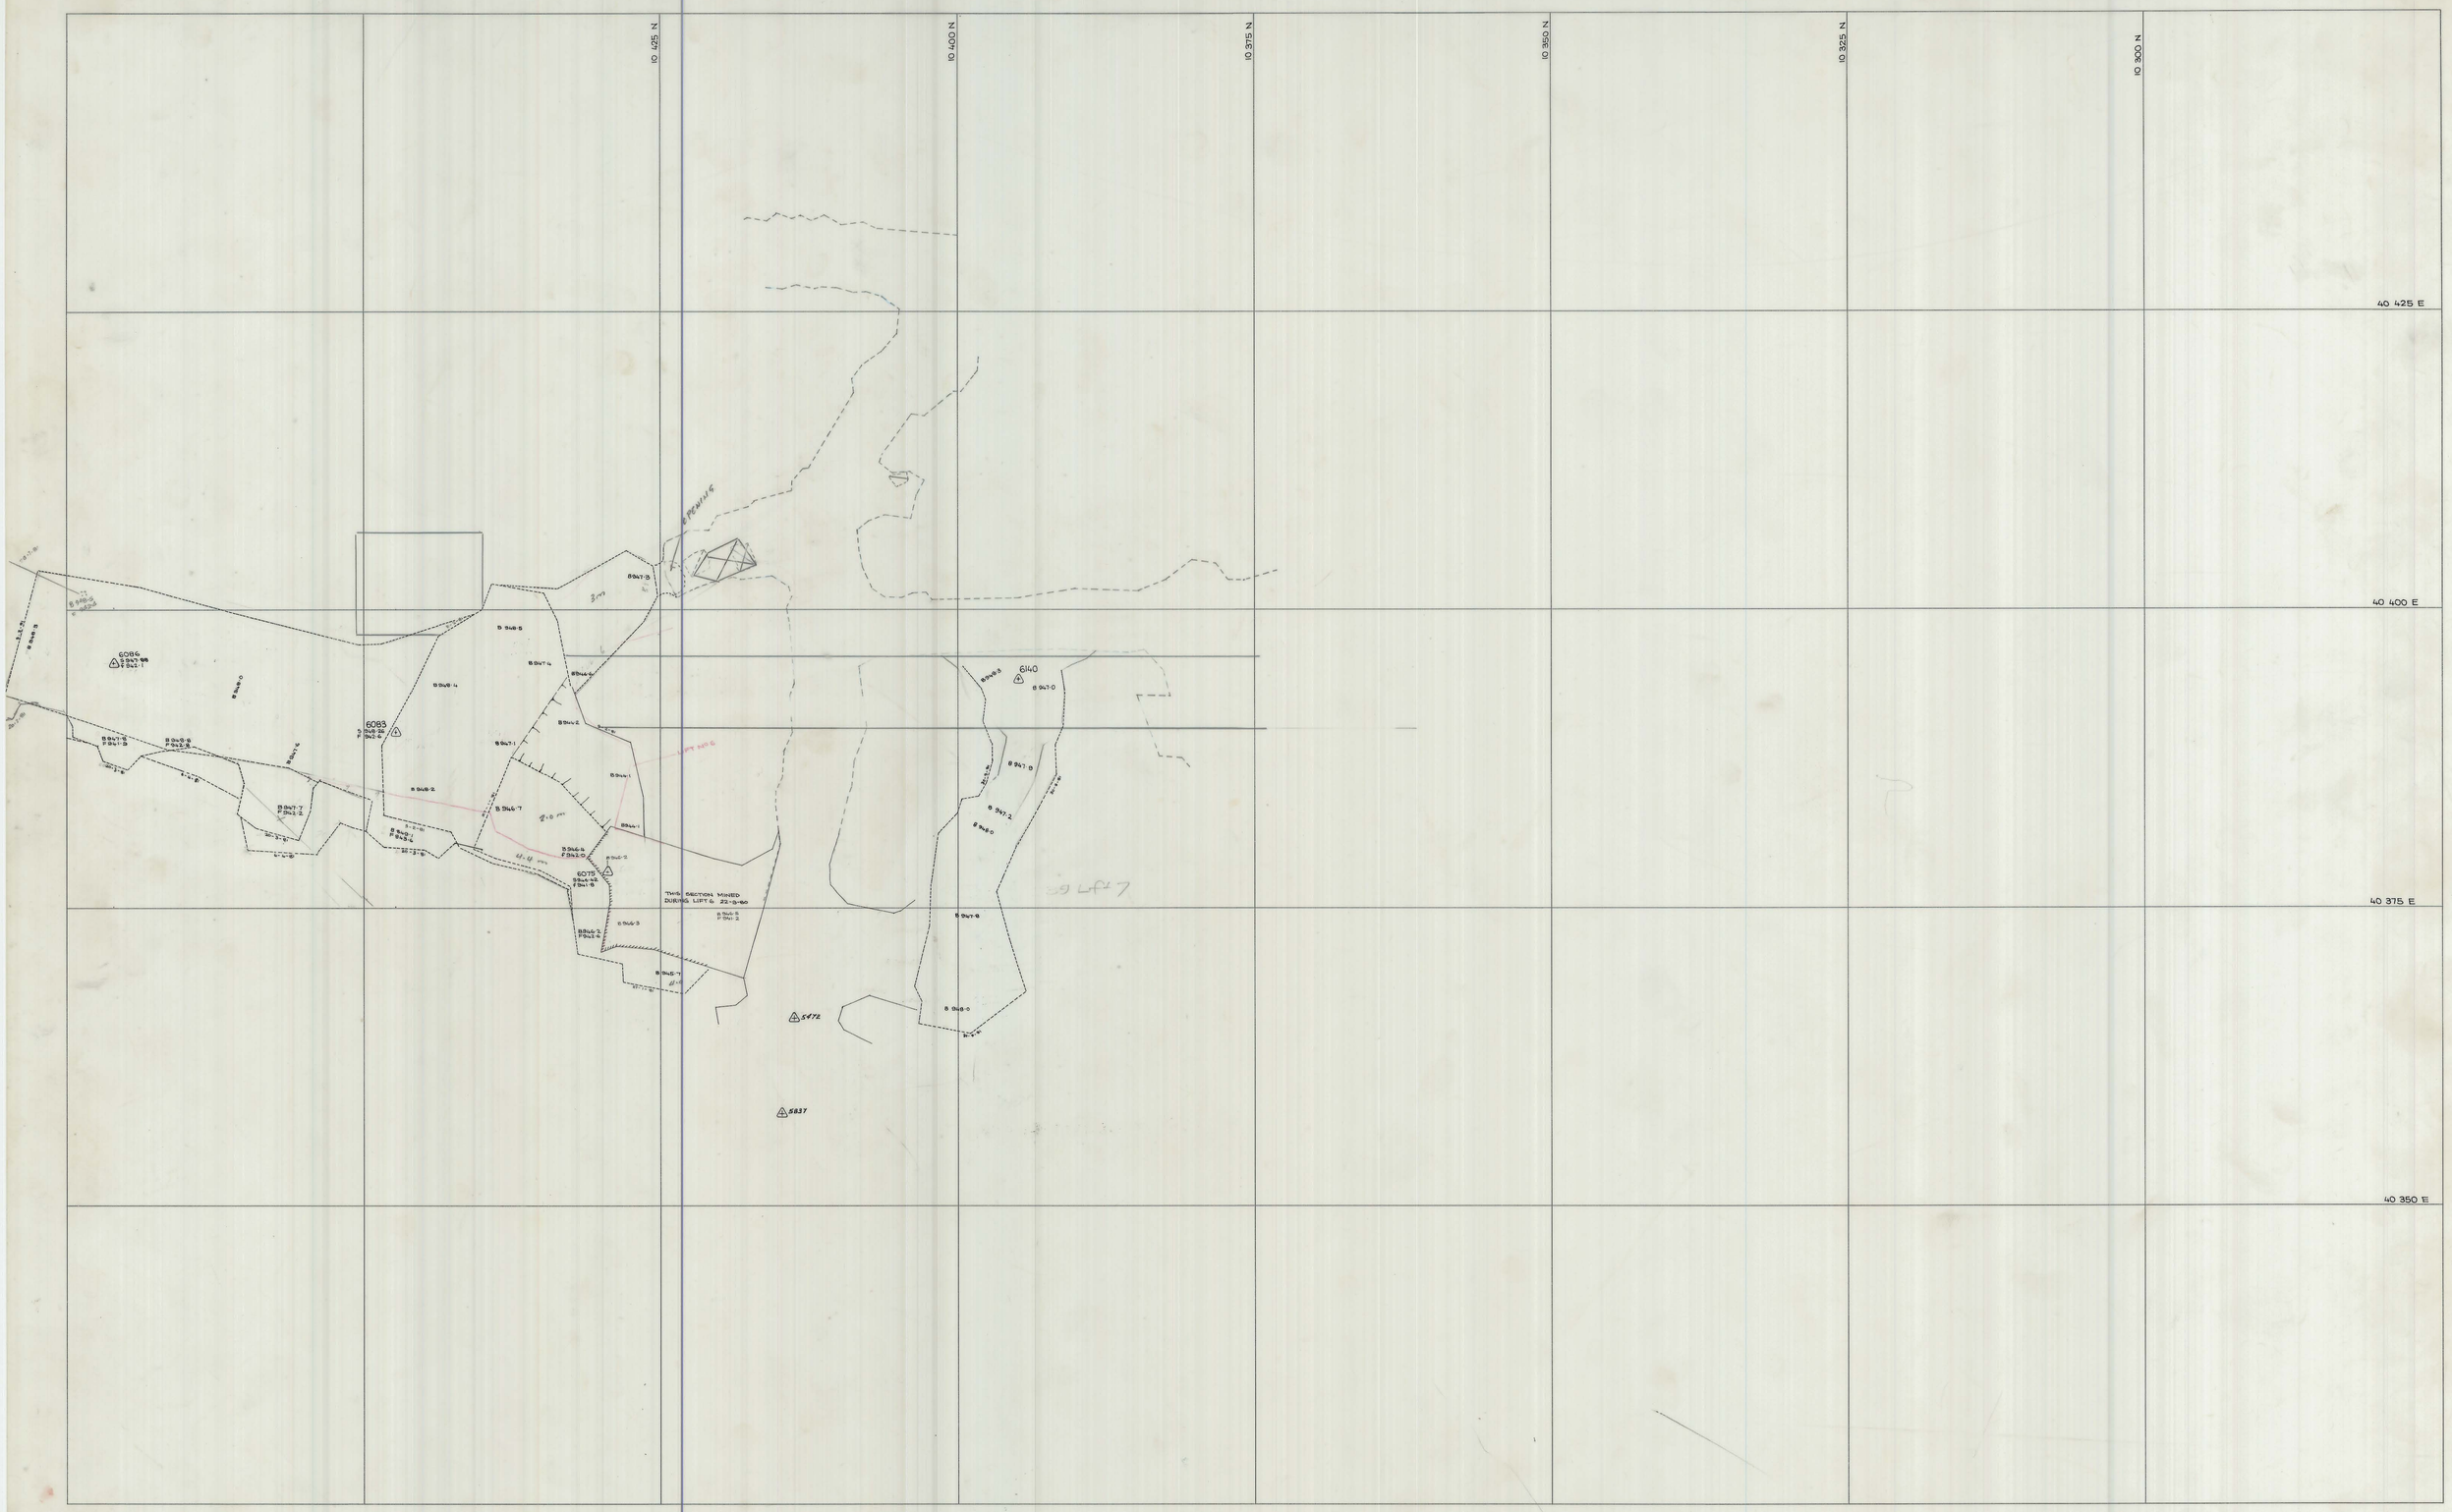

	SCALE 1:250	north	LOCATION: BOLD HEAD MINE
			SUBJECT: 043 & 037 STOPES 7th LIFT
			KING ISLAND SCHEELITE — A DIVISION OF WARMAN INTERNATIONAL — GRASSY KING ISLAND
			PLAN NUMBER: 04BH13 - 156 206S