27 JUN 1981

5 cm

04BH13- 156 218 S

037 LIFT 3

0374_4351

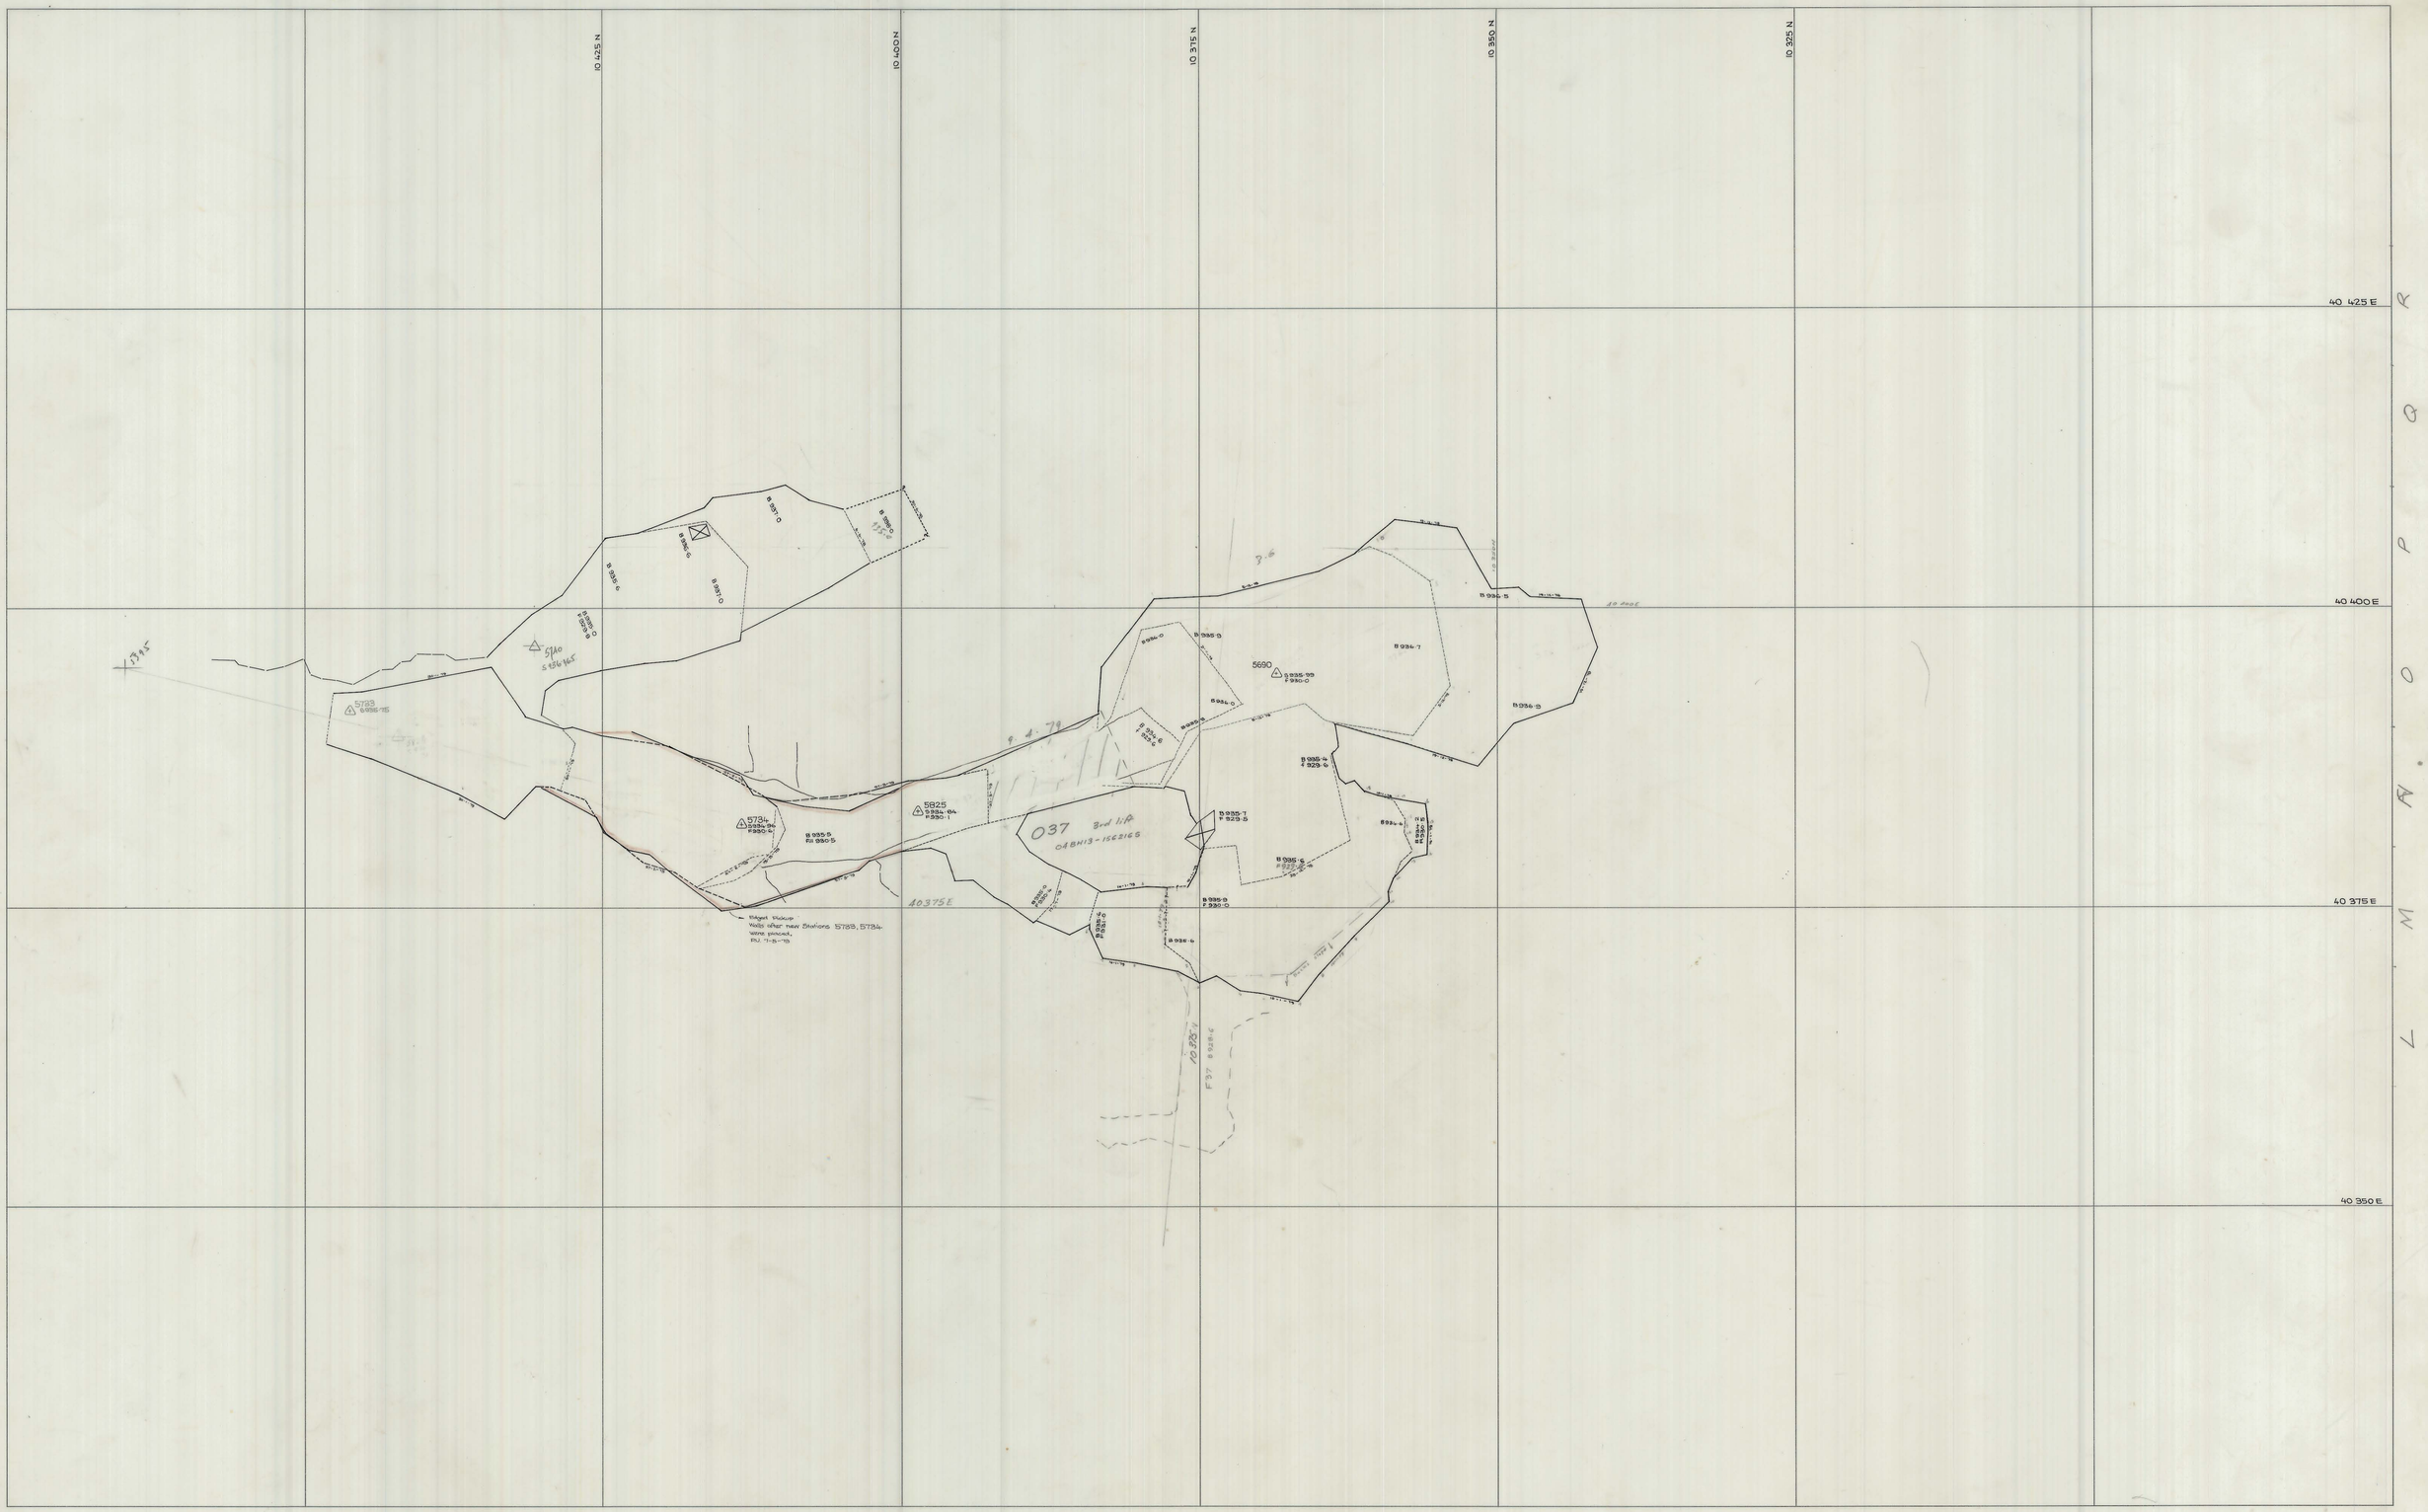

SCALE 1:250	LOCATION BOLD HEAD MINE	KING ISLAND SCHEELITE A DIVISION OF WARMAN INTERNATIONAL	
SECOND LIFT FINAL -	SUBJECT 037 (046) - 3rd LIFT B F2	GRASSY KING ISLAND	
north		PLAN NUMBER 04BH13- 156 218 S	