04BH13- 156222S
0374_4353
046
LIFT 0

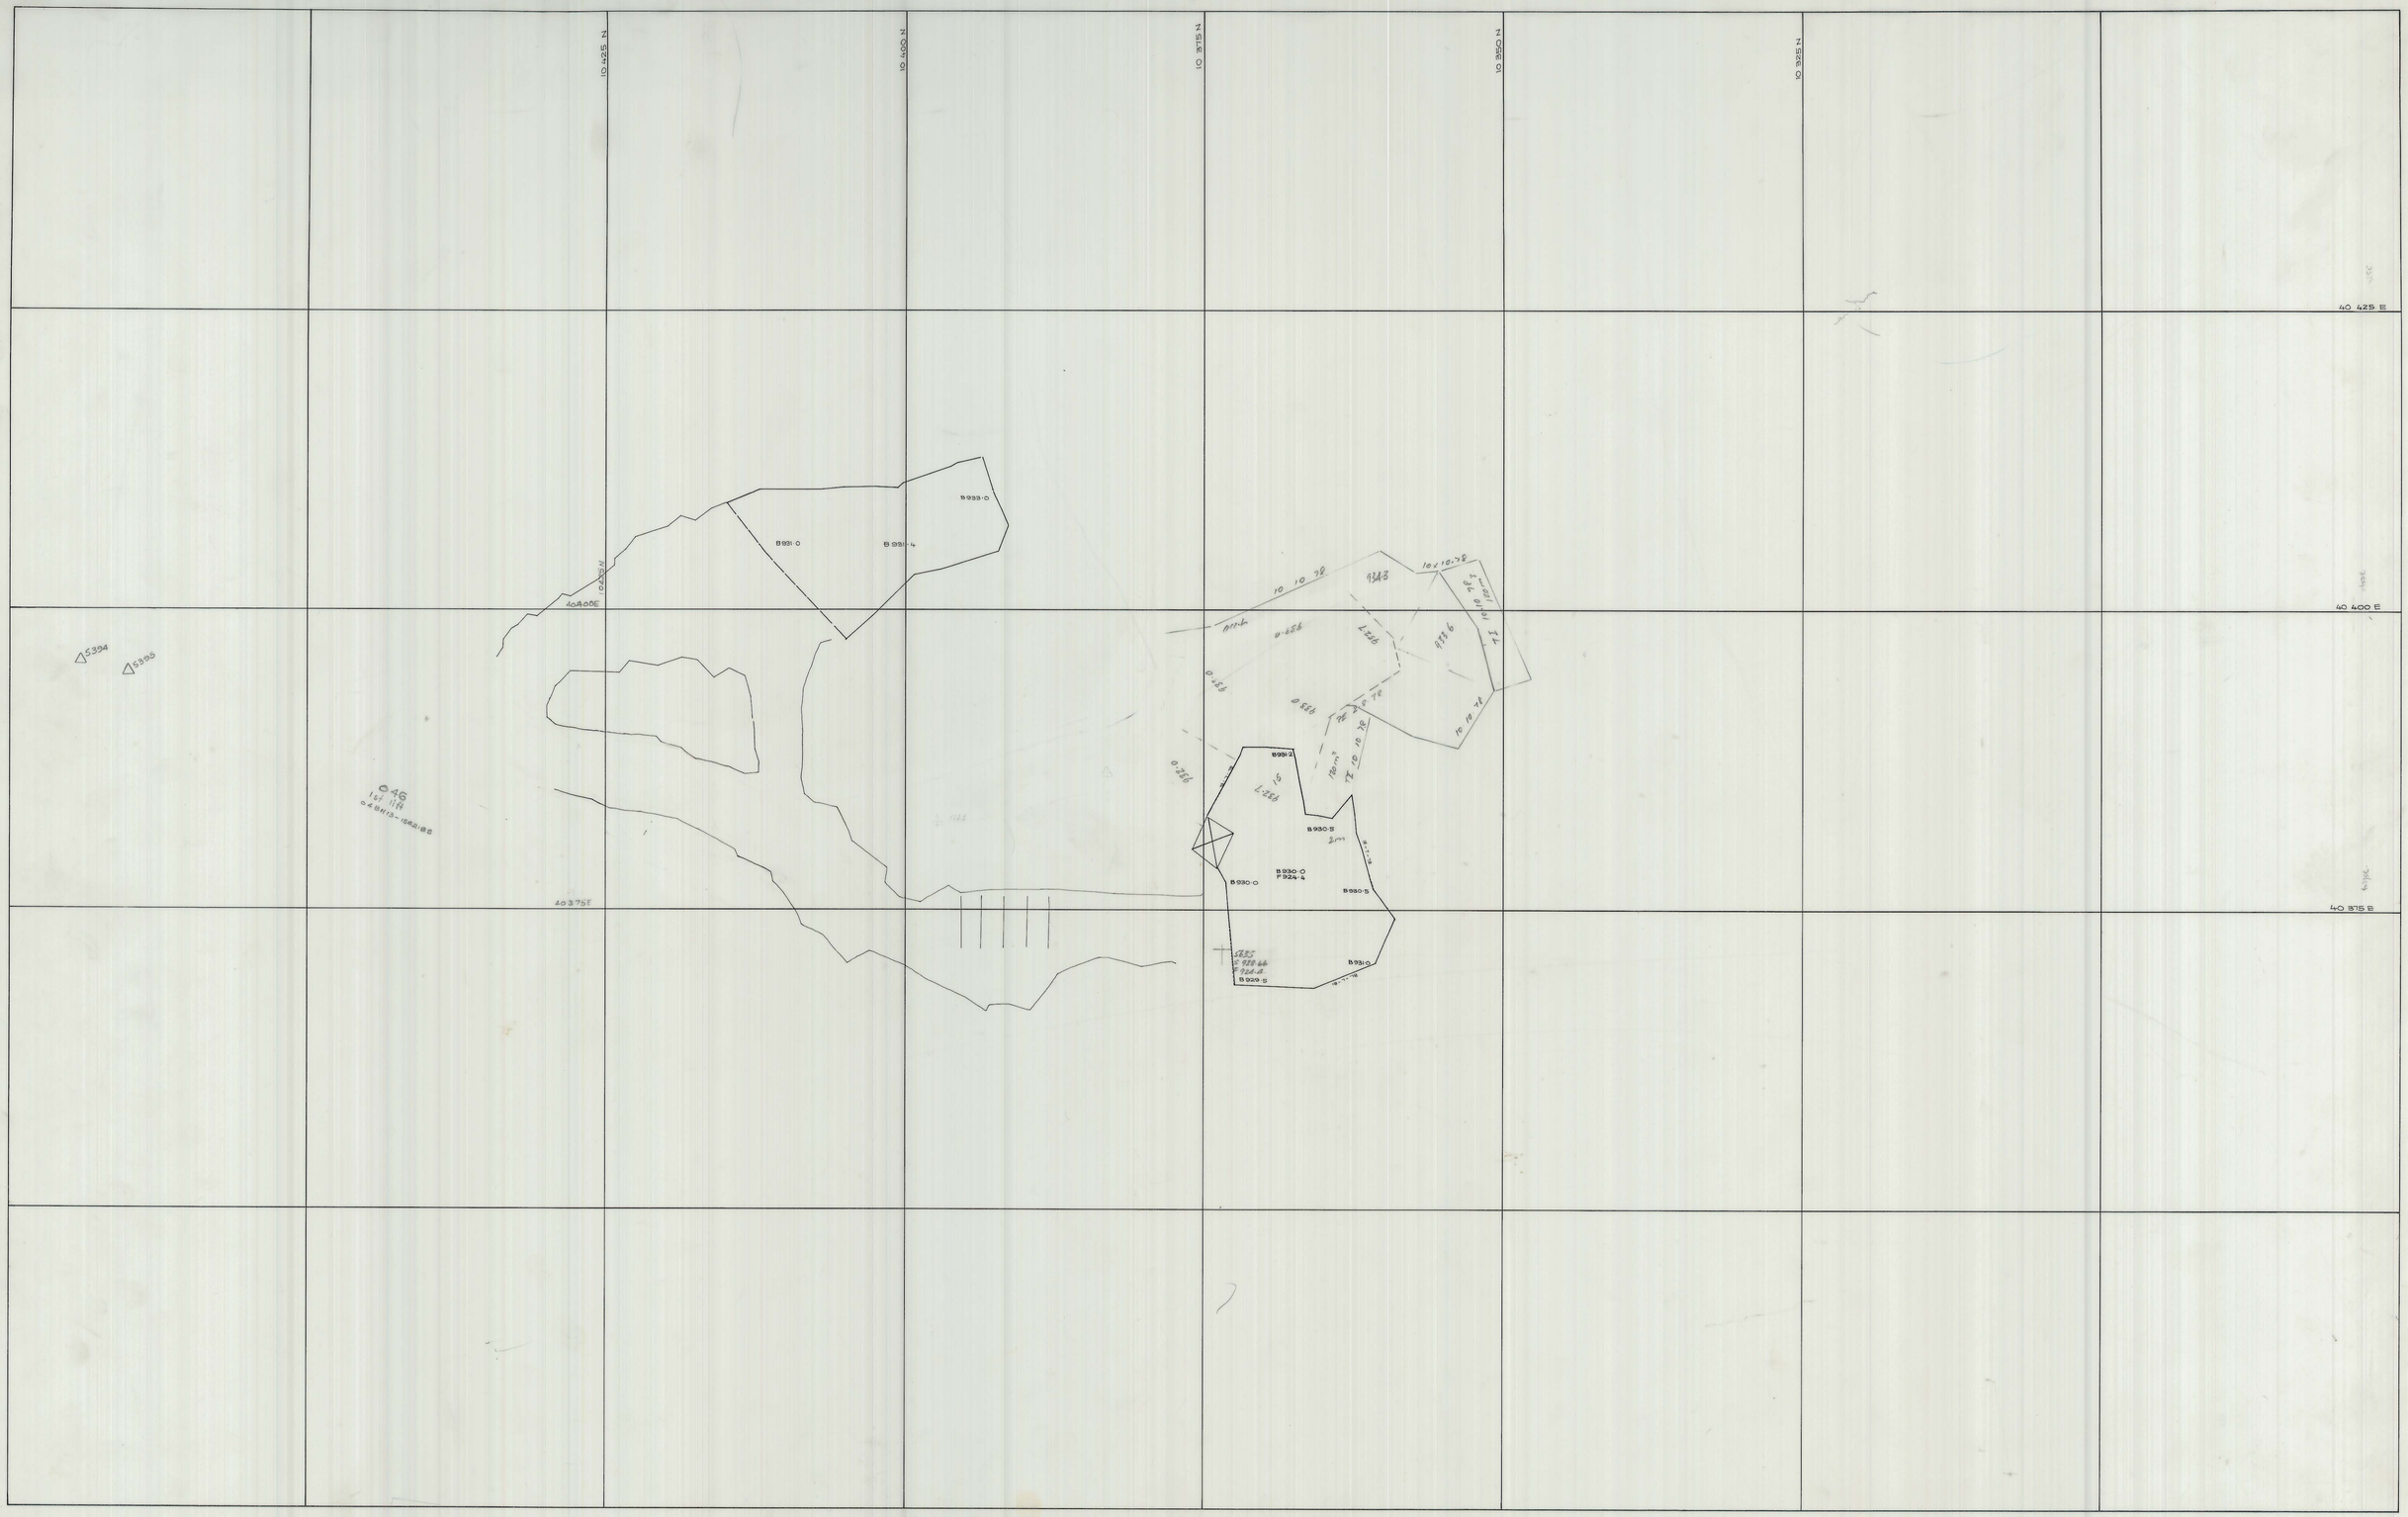

SCALE 1: 250	north	LOCATION: BOLD HEAD MINE SUBJECT: 046 - 1st LIFT B.F. 2	KING ISLAND SCHEELITE A DIVISION OF WARMAN INTERNATIONAL GRASSY KING ISLAND PLAN NUMBER: 04BH13- 156 222 S