27 JUN 1981

5 cm

04BH13-2003 13-2003

M71

0374_4369

40 350 E

40 375 E

40 400 E

10 775 N

10 750 N

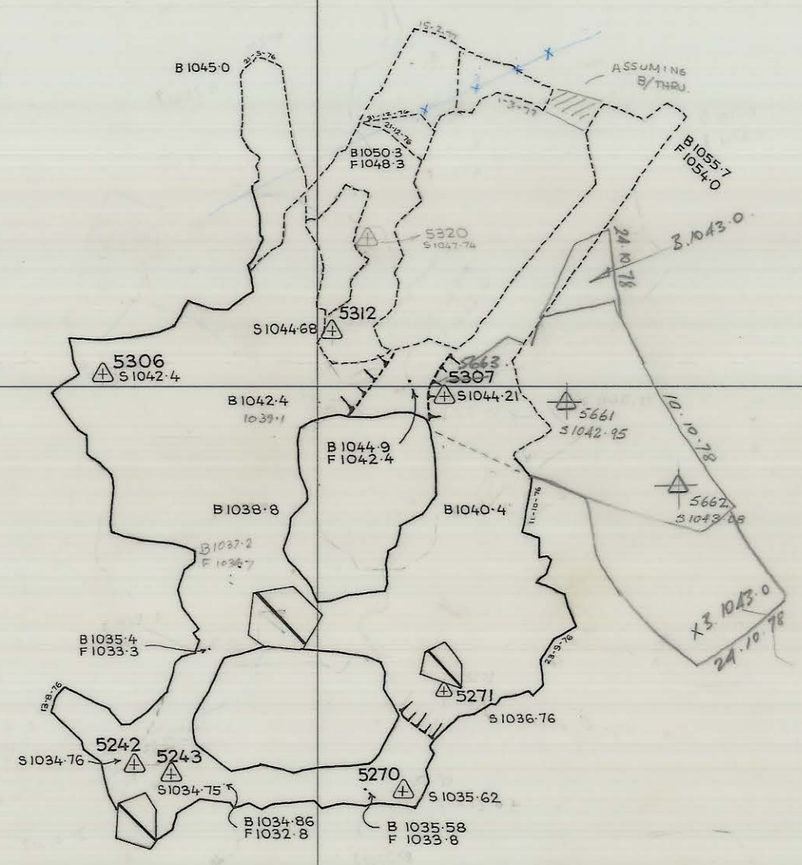

10 725 N

10 700 N

SCALE 1:250

north

LOCATION

BOLD HEAD MINE

SUBJECT

M71 STOPE

UPPER B LENS

KING ISLAND SCHEELITE
A DIVISION OF WARMAN INTERNATIONAL

GRASSY KING ISLAND

PLAN NUMBER

04BH13 - 2003