0374_4398

04BH17 - 2008.

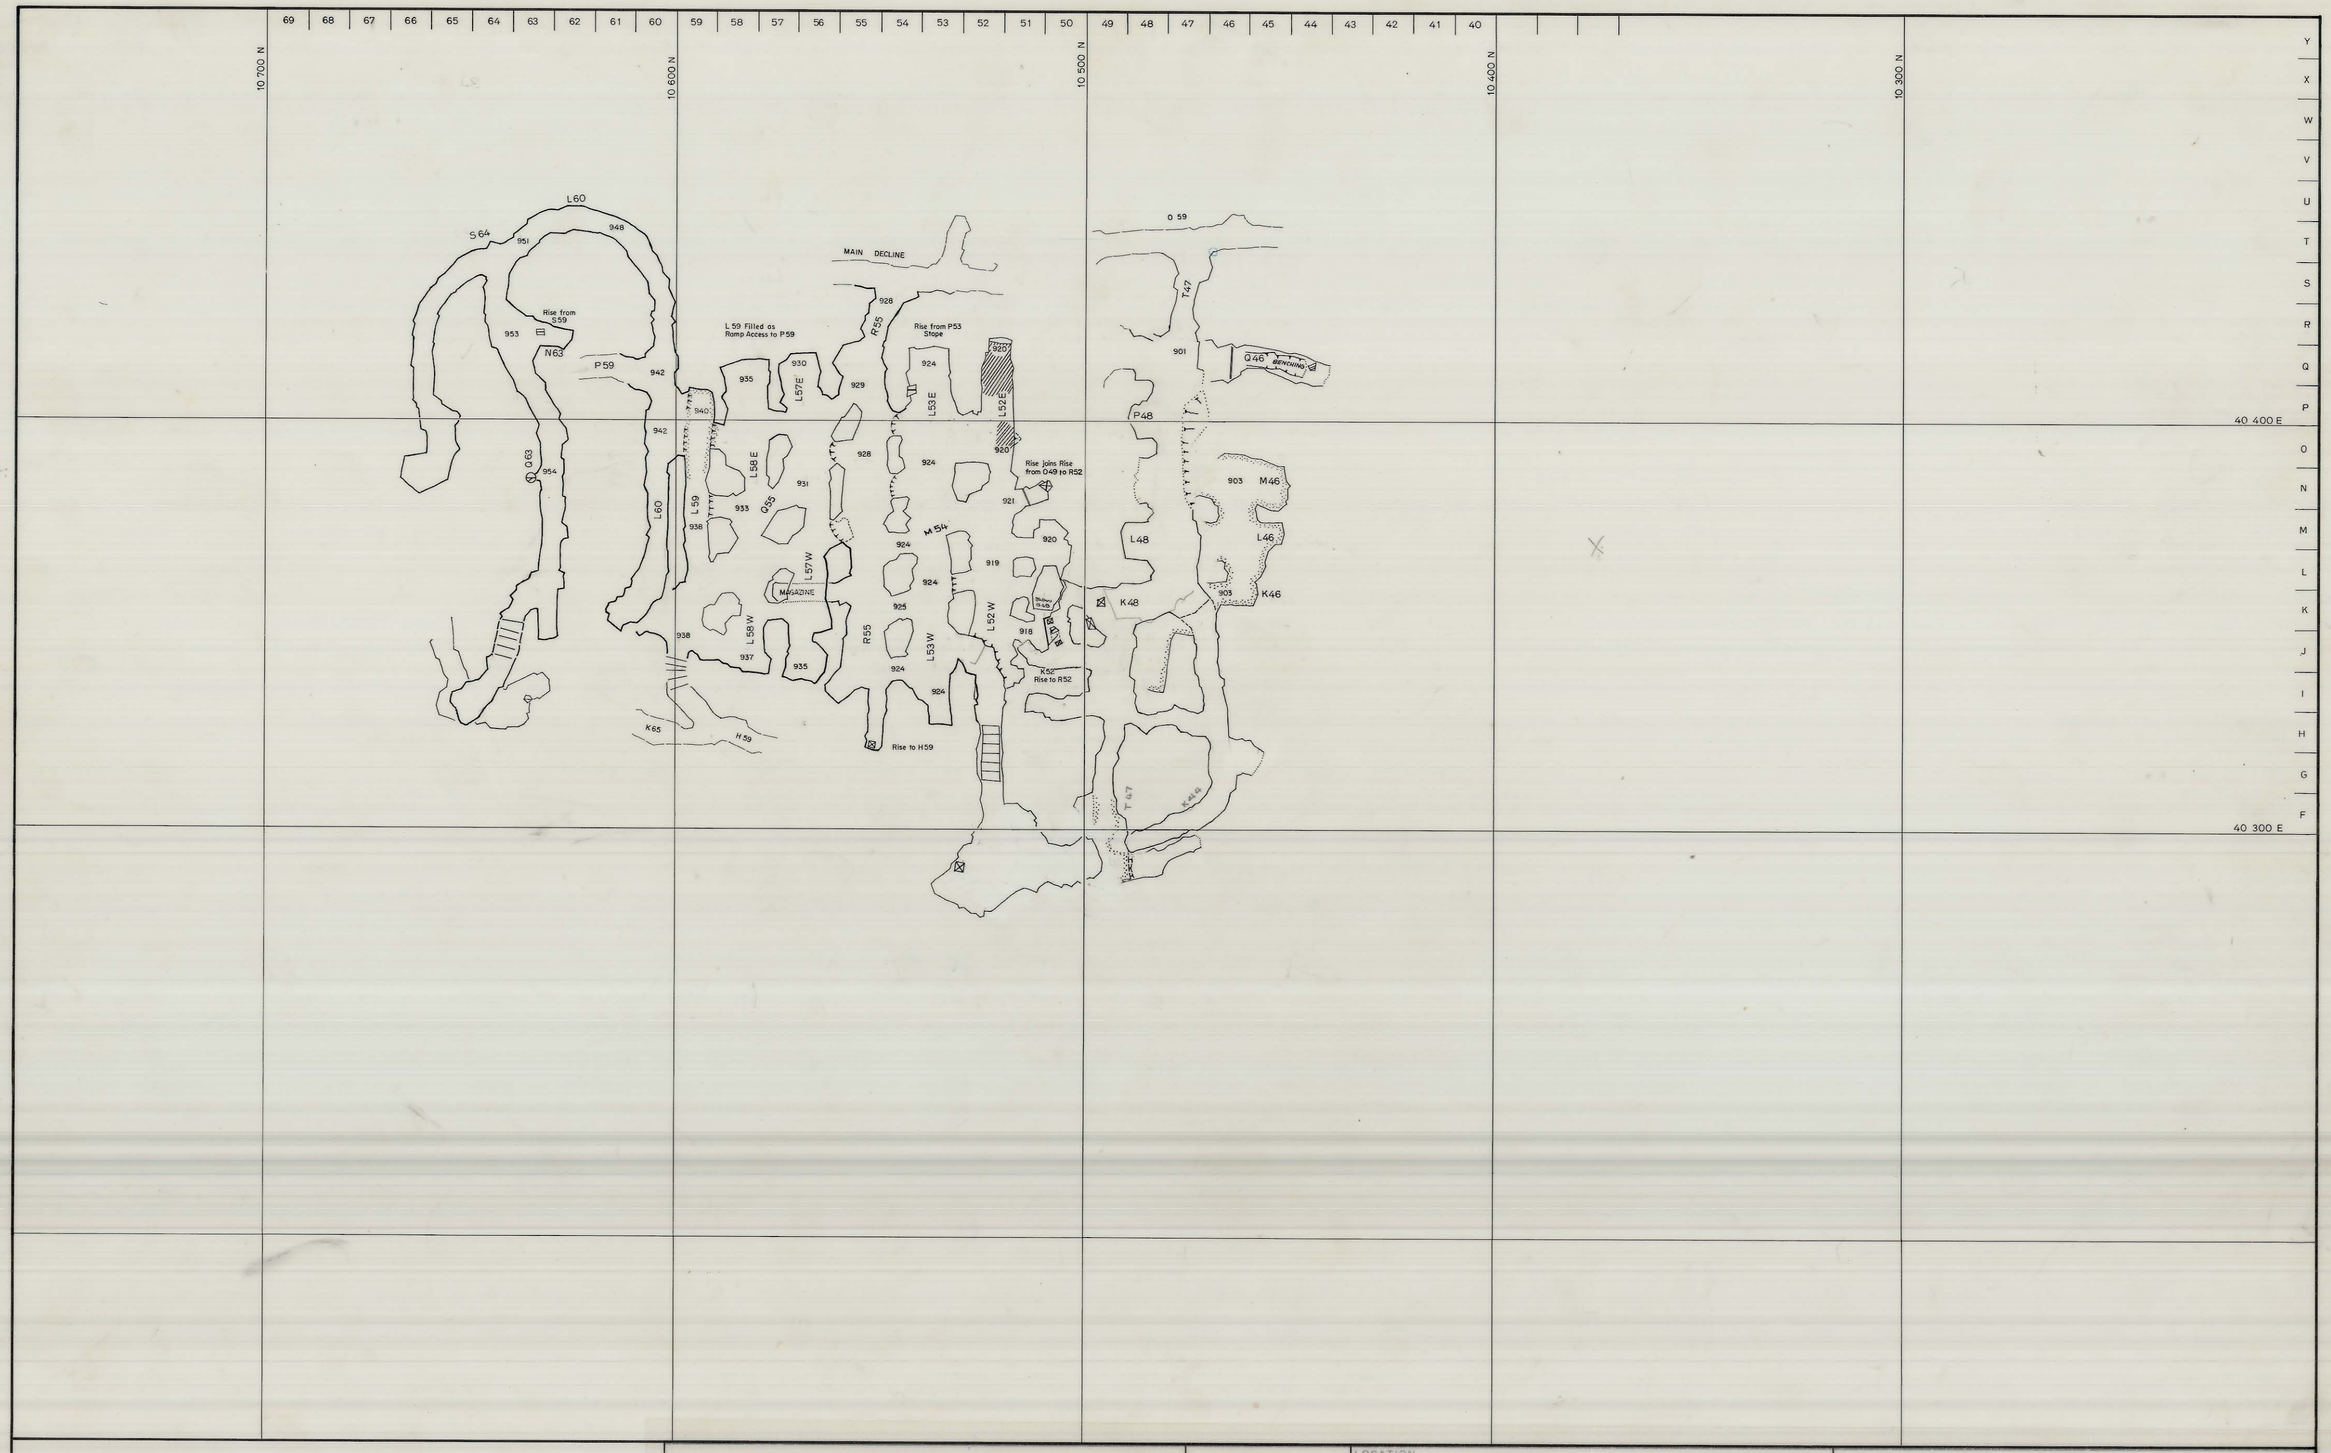

SCALE 1:1000

37 664 m³

north

LOCATION

BOLD HEAD MINE

SUBJECT

C_1 LENS OREBODY

KING ISLAND SCHEELITE
A DIVISION OF WARMAN INTERNATIONAL

GRASSY KING ISLAND

PLAN NUMBER

04BH17 - 2008

5 cm

27 JUN 1981