27 JUN 1981

5 cm

04BH13 - 156239S

T 53
1st lift.

0374_4423

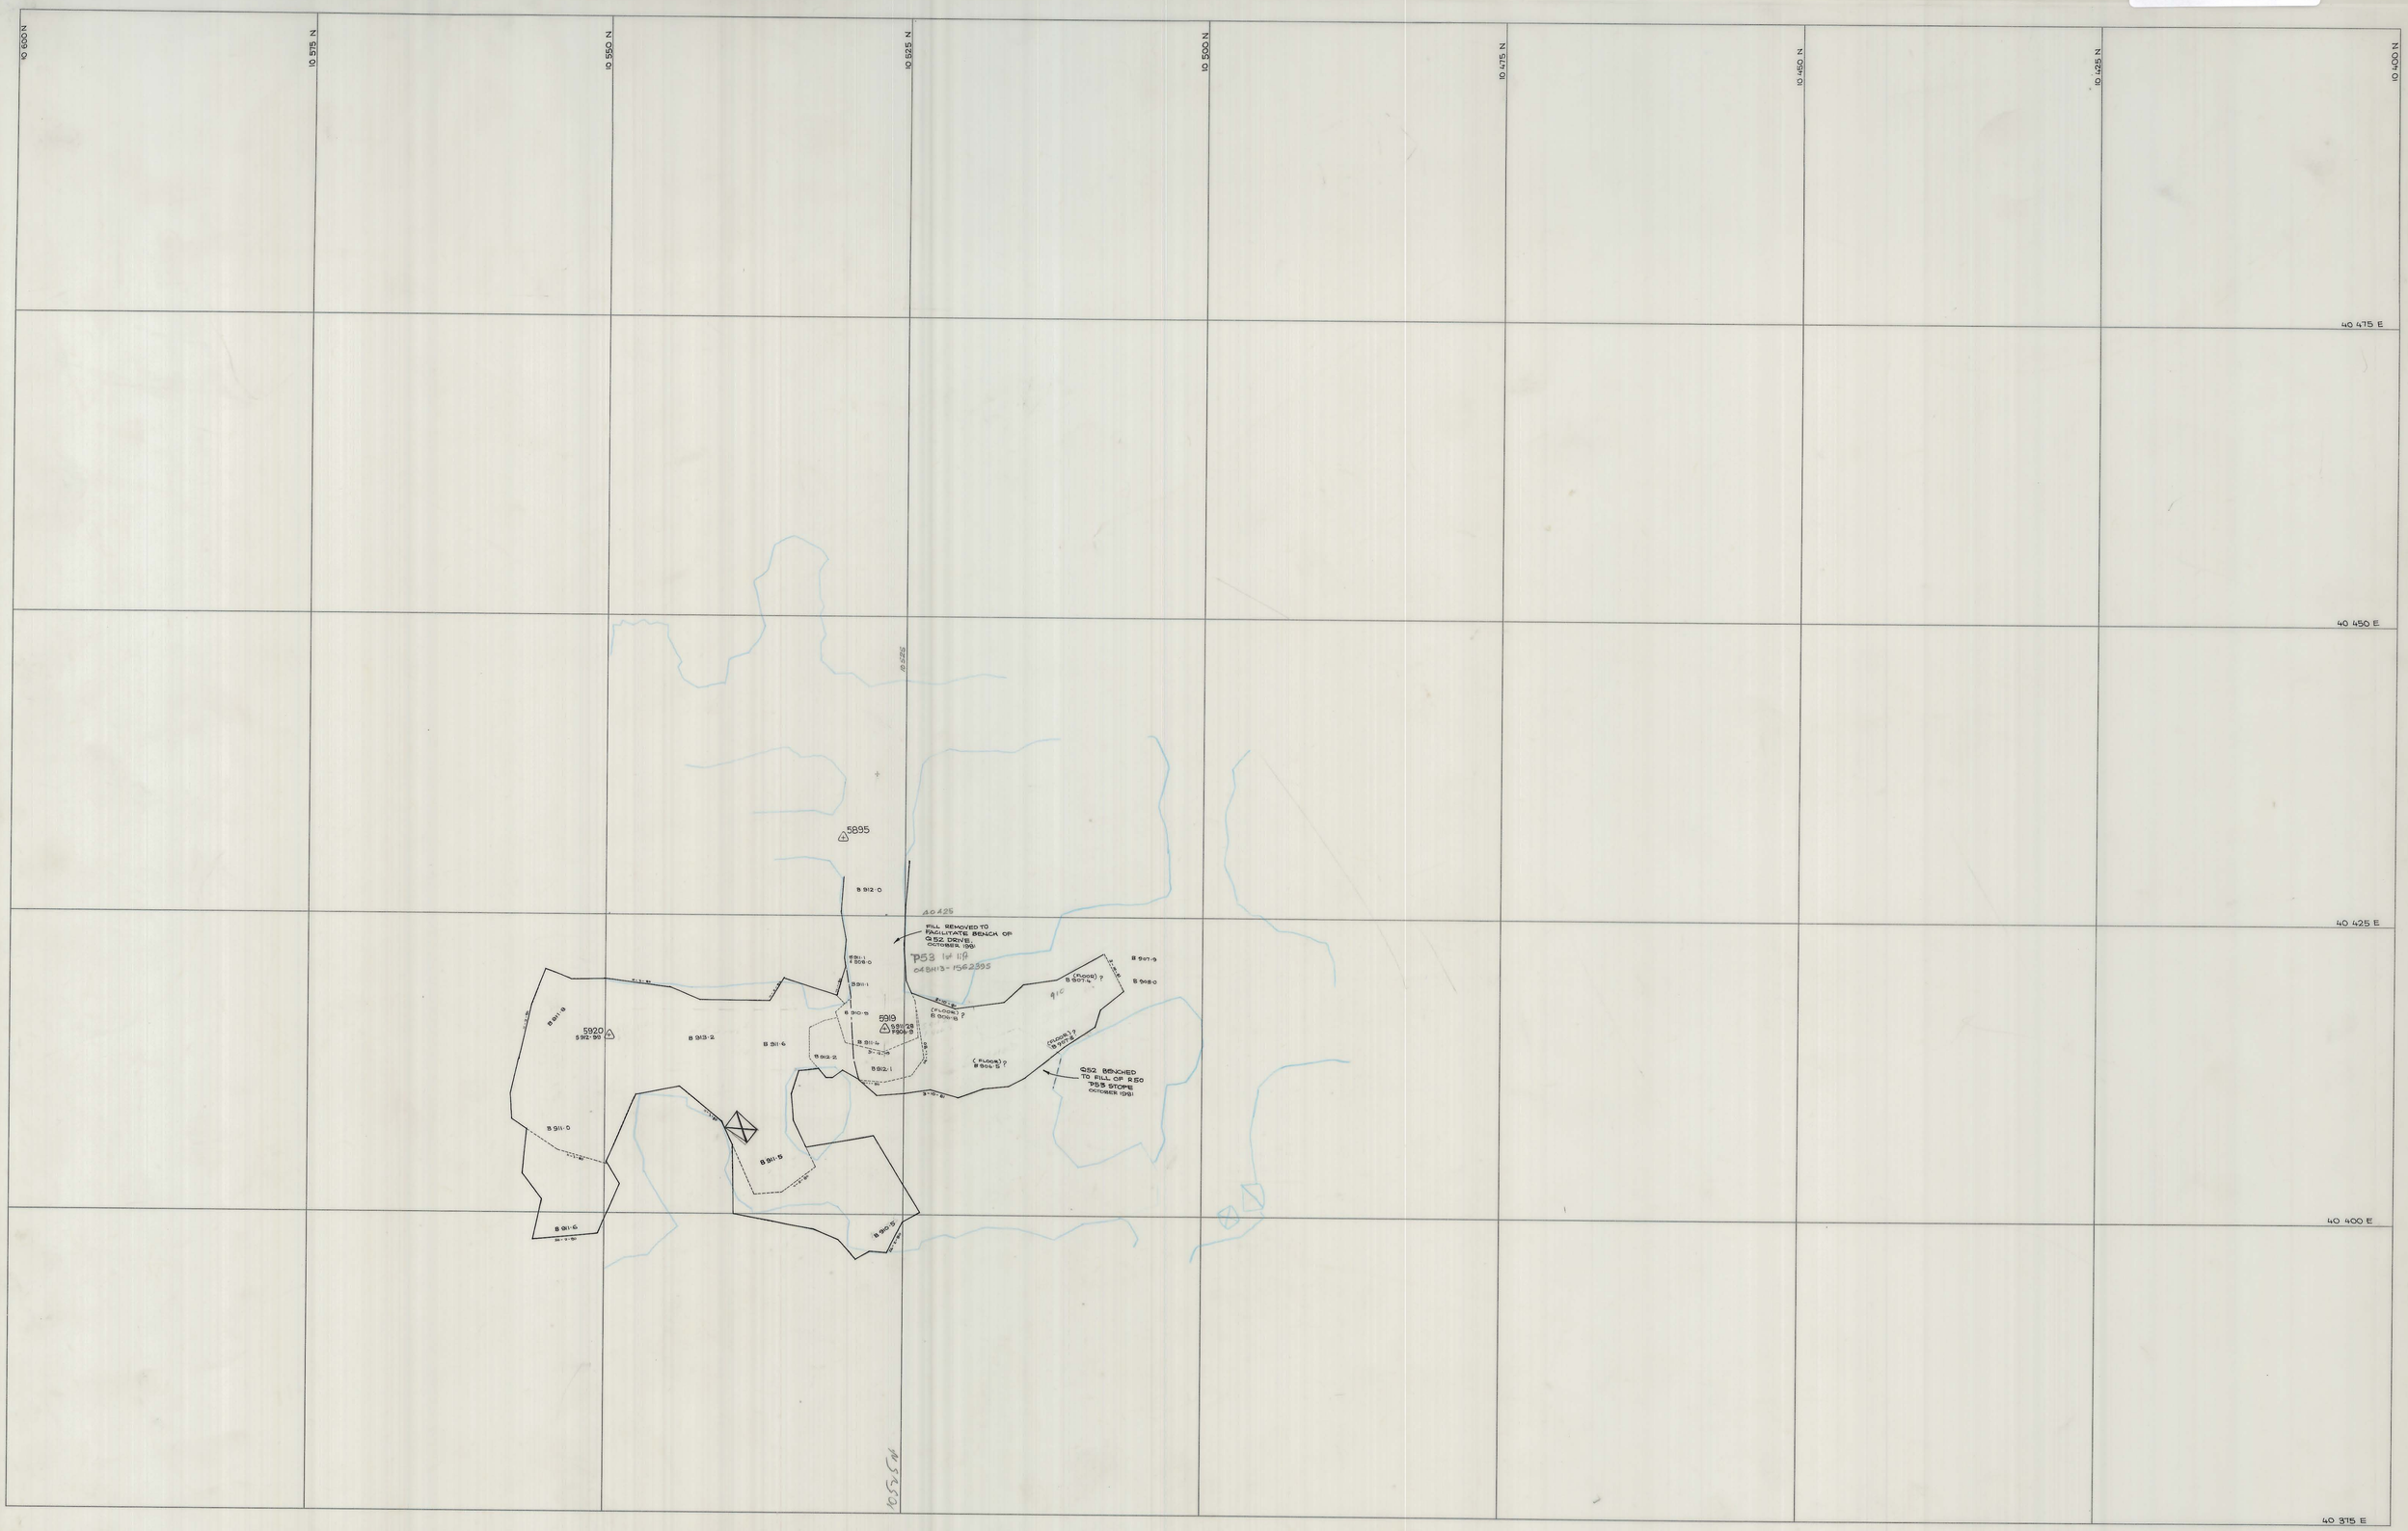

	SCALE 1: 250	north	LOCATION: Bold Head Mine SUBJECT: T 53 1st lift
			KING ISLAND SCHEELITE — A DIVISION OF WARMAN INTERNATIONAL GRASSY — KING ISLAND PLAN NUMBER: 04BH13 - 156 239 S