27 JUN 1981

5 cm

04BH13 - 165 085S

0374_4475

H 50
LIFT 9

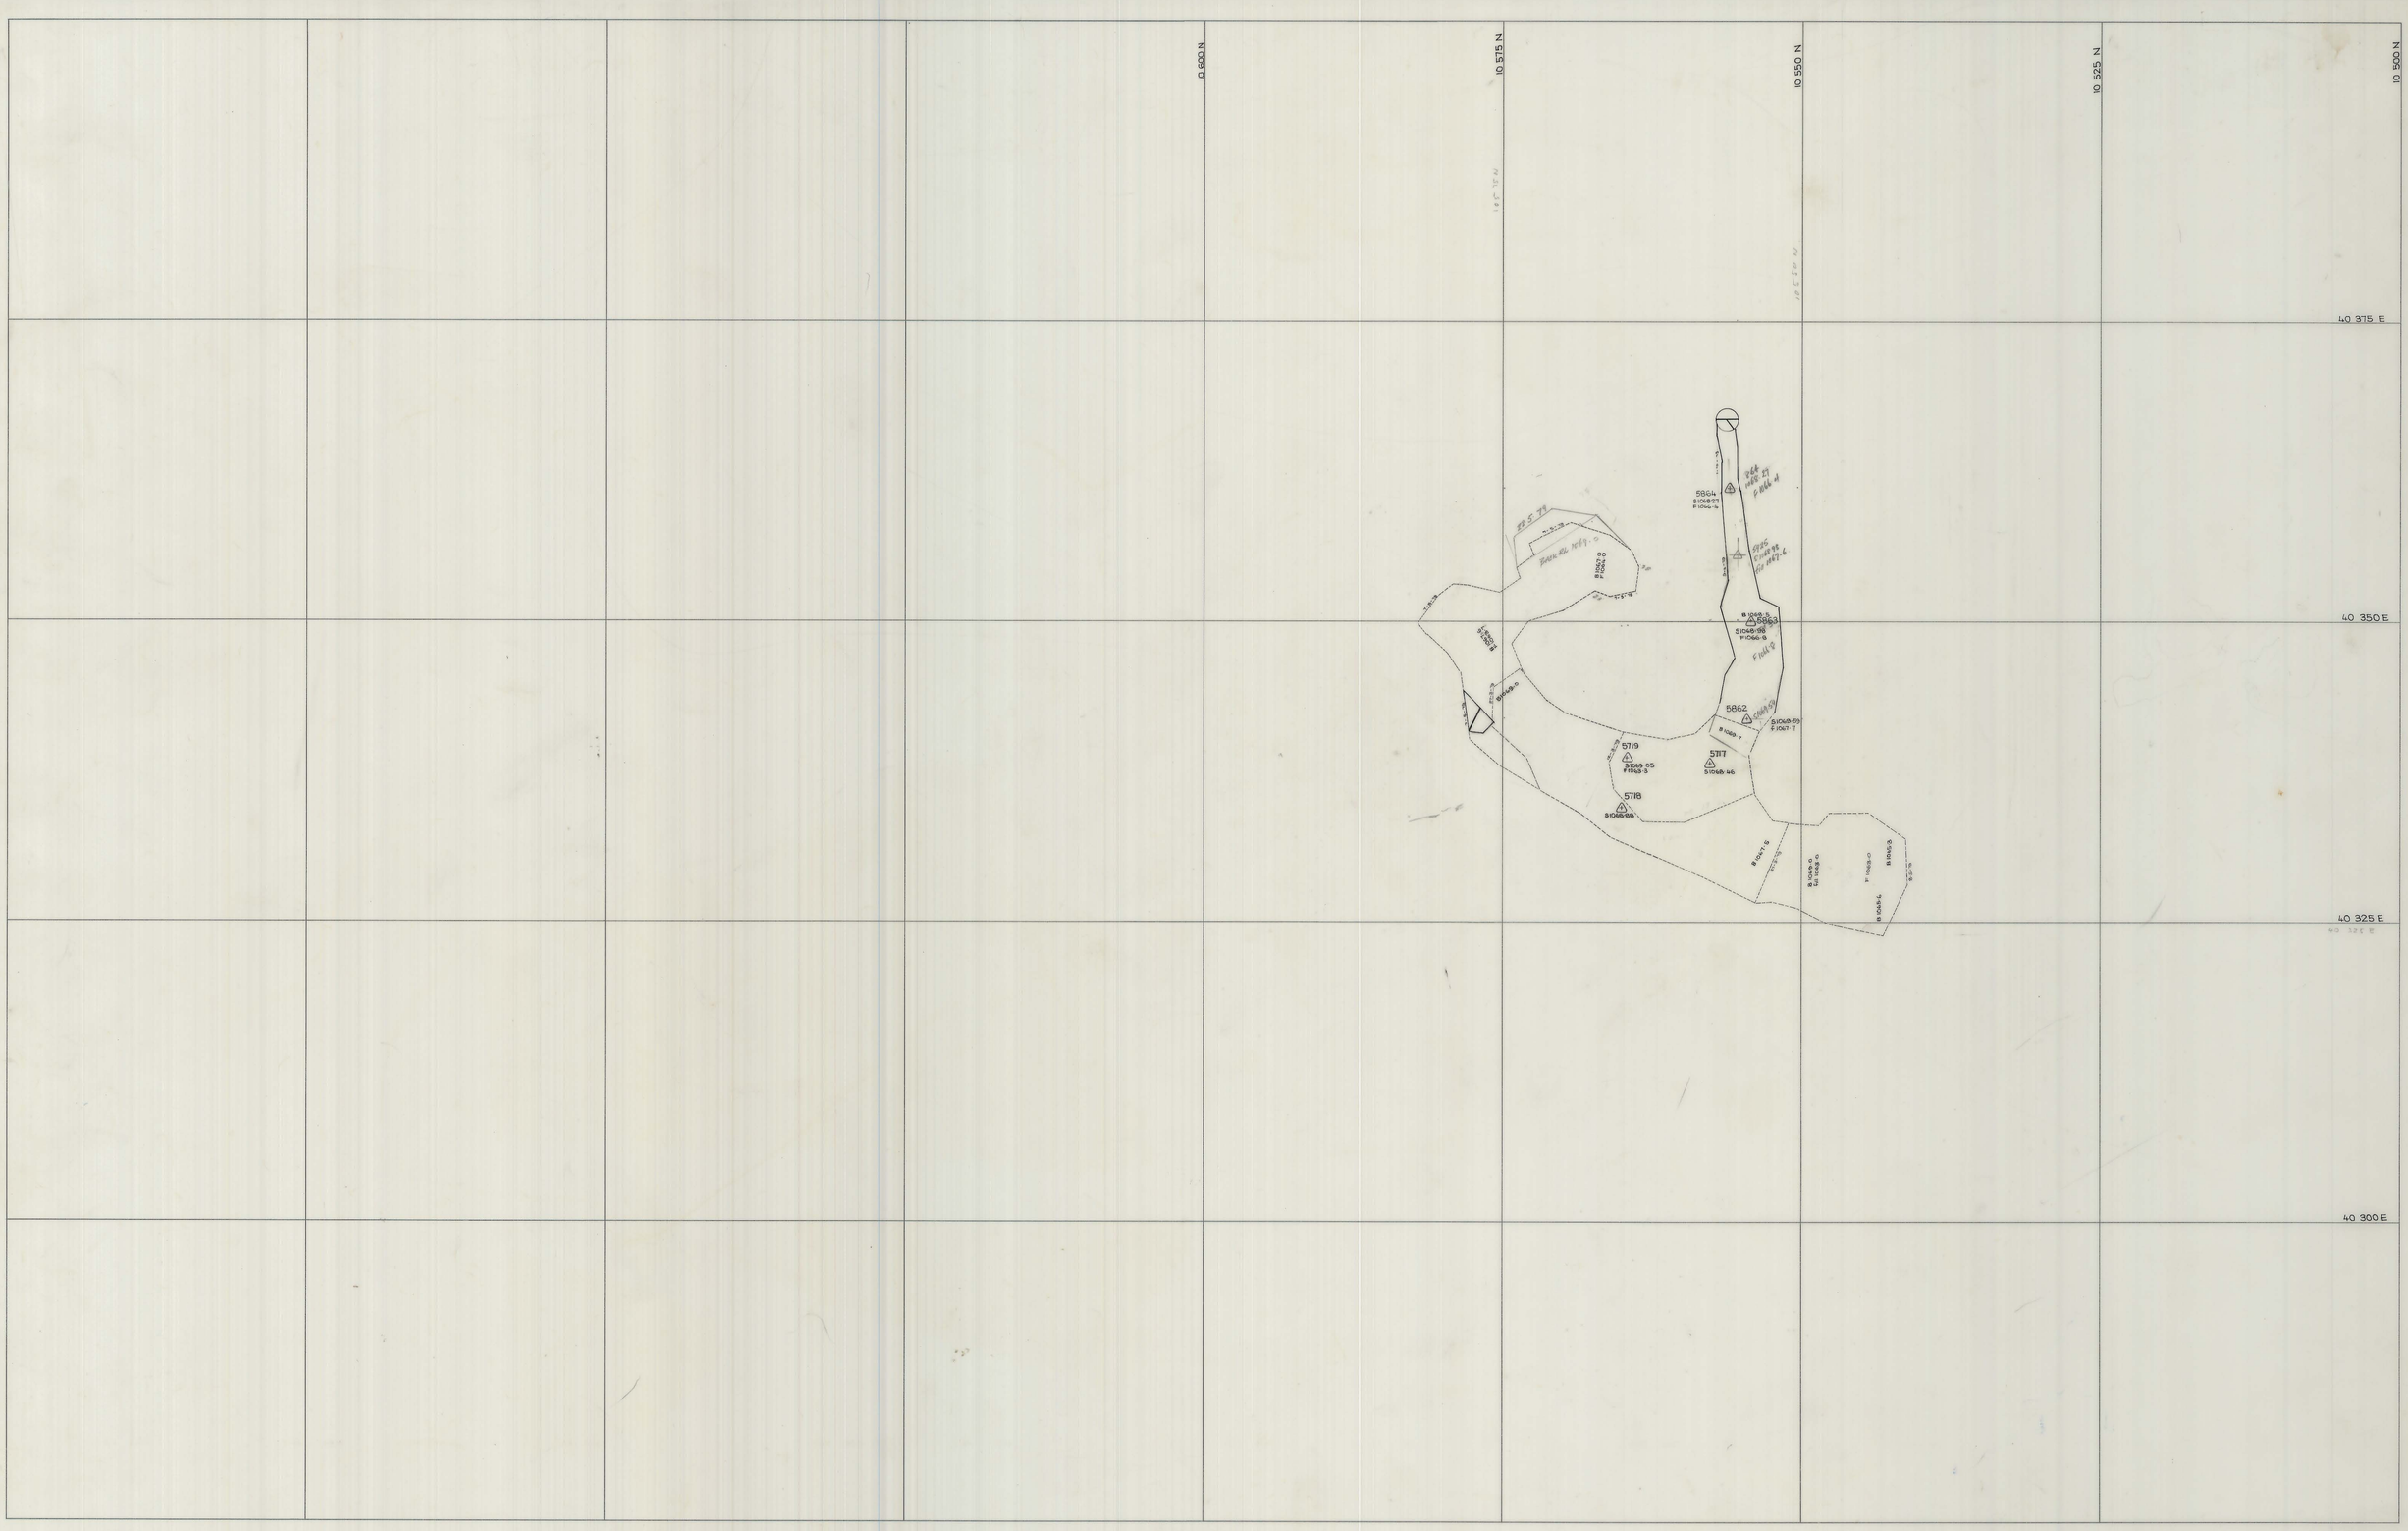

SCALE 1: 250	north	LOCATION BOLD HEAD MINE SUBJECT A LENS H 50 STOPE LIFT 9	KING ISLAND SCHEELITE A DIVISION OF WARMAN INTERNATIONAL GRASSY KING ISLAND PLAN NUMBER 04BH13- 165 085S