0374 - 448

04DM15 - 1048
SEETHANS JOAK 1987

190

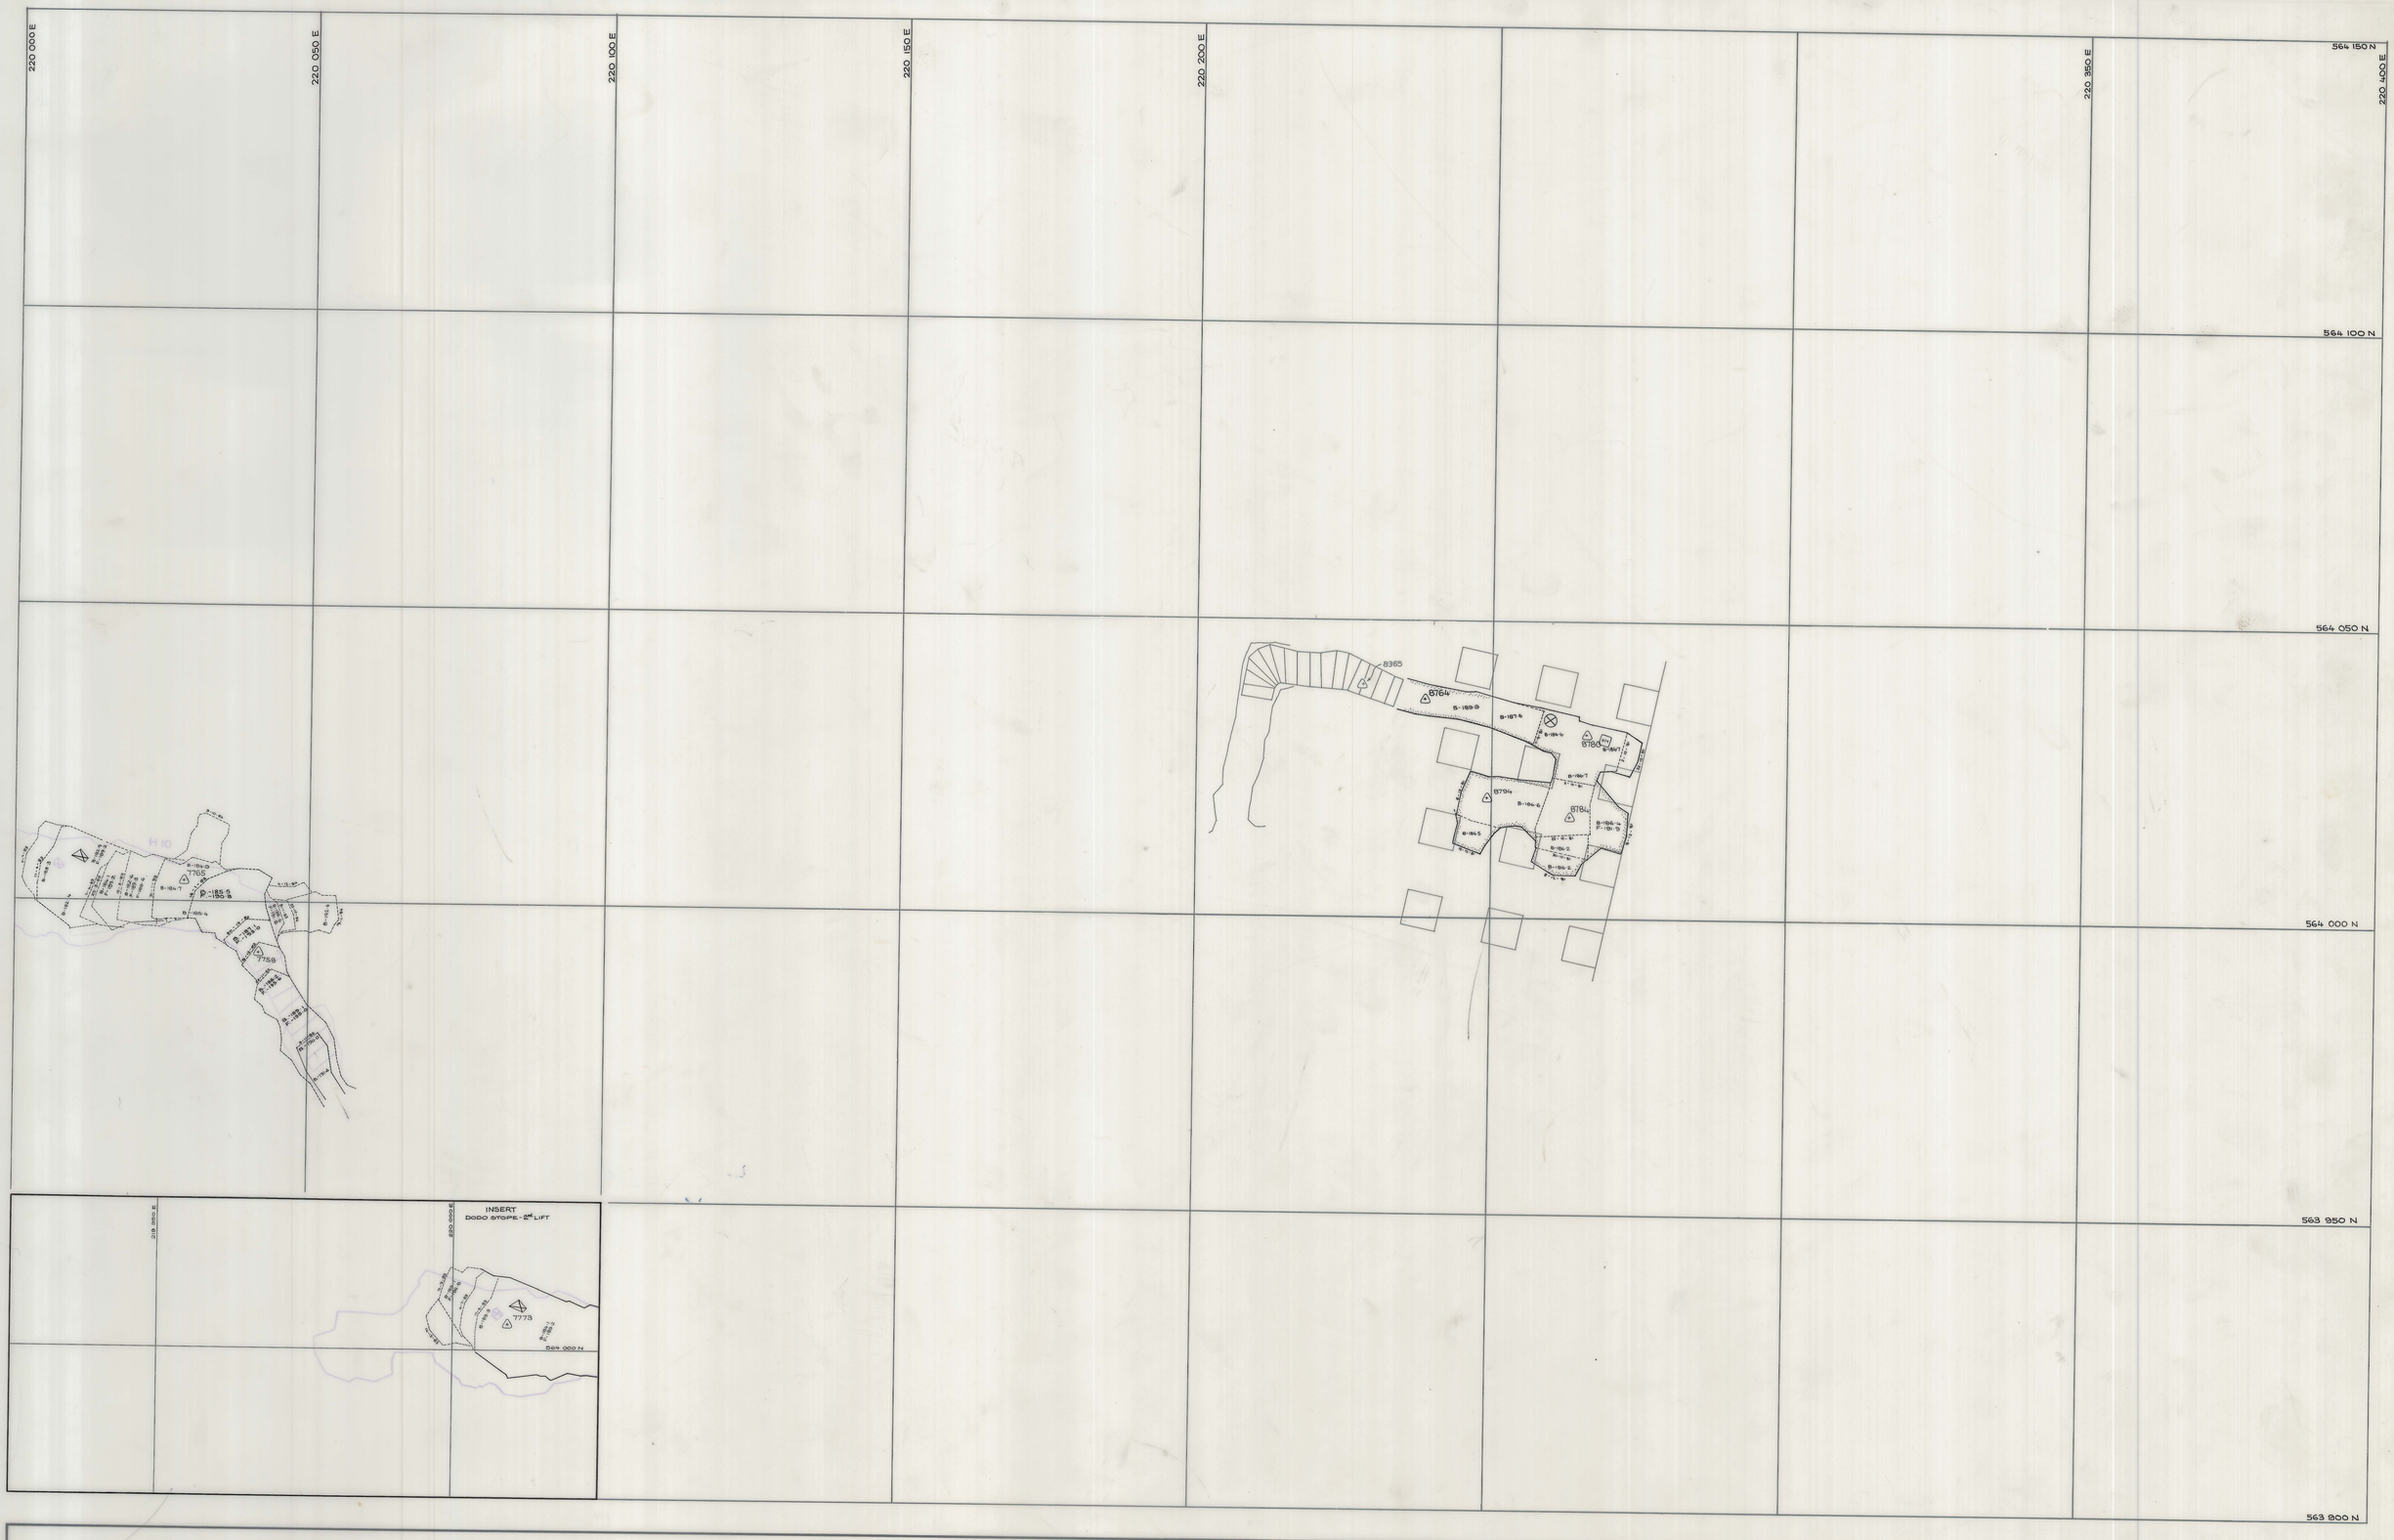

SCALE	1:500
LOWER PIT STOPE	LIFT 11
MID WEDGE SOUTH	LIFT 3
MID WEDGE NORTH	UNDERCUT.

5 cm

north

LOCATION: DOLPHIN MINE

SUBJECT: MID WEDGE - 190 m CONTOUR
LOWER PIT - 188·5m CONTOUR

KING ISLAND SCHEELITE
A DIVISION OF WARMAN INTERNATIONAL

GRASSY — KING ISLAND

Our marks

PLAN NUMBER: 04DM15 - 1048