


5 cm

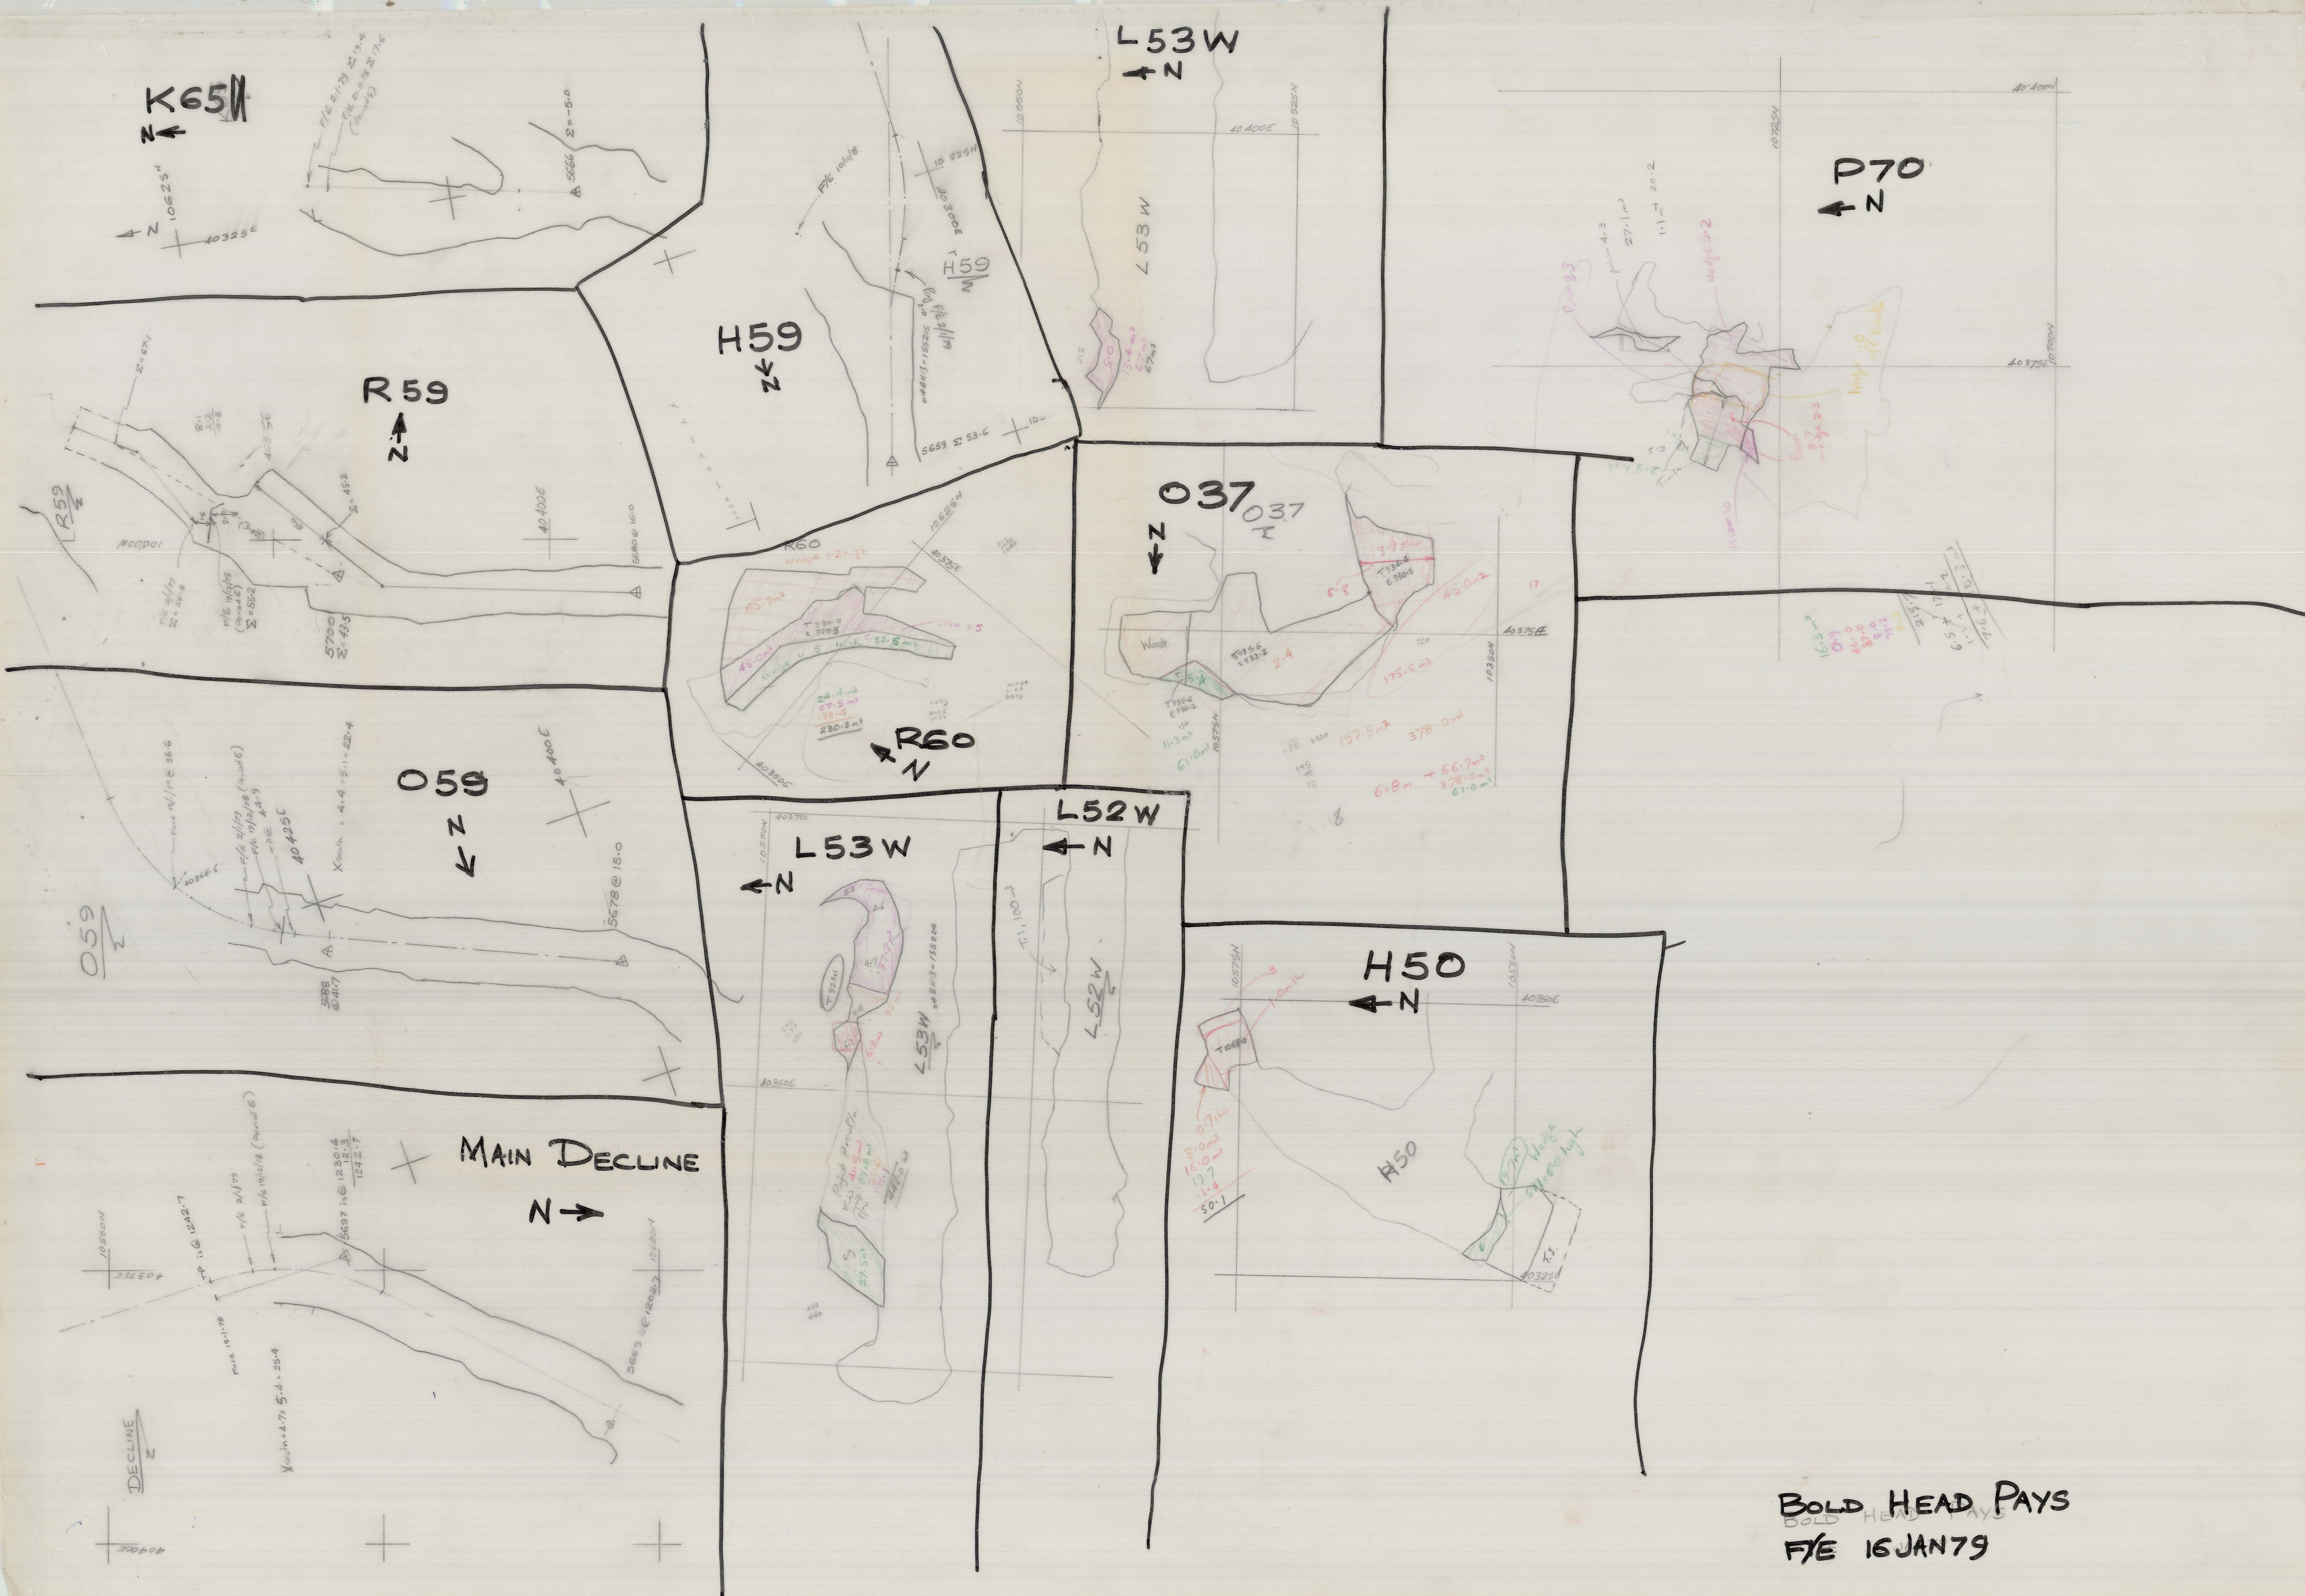

BOLD HEAD PAYS
F/E 16JAN79