27 JUN 1981

04 BH 13-166125

0374_4511

5 cm

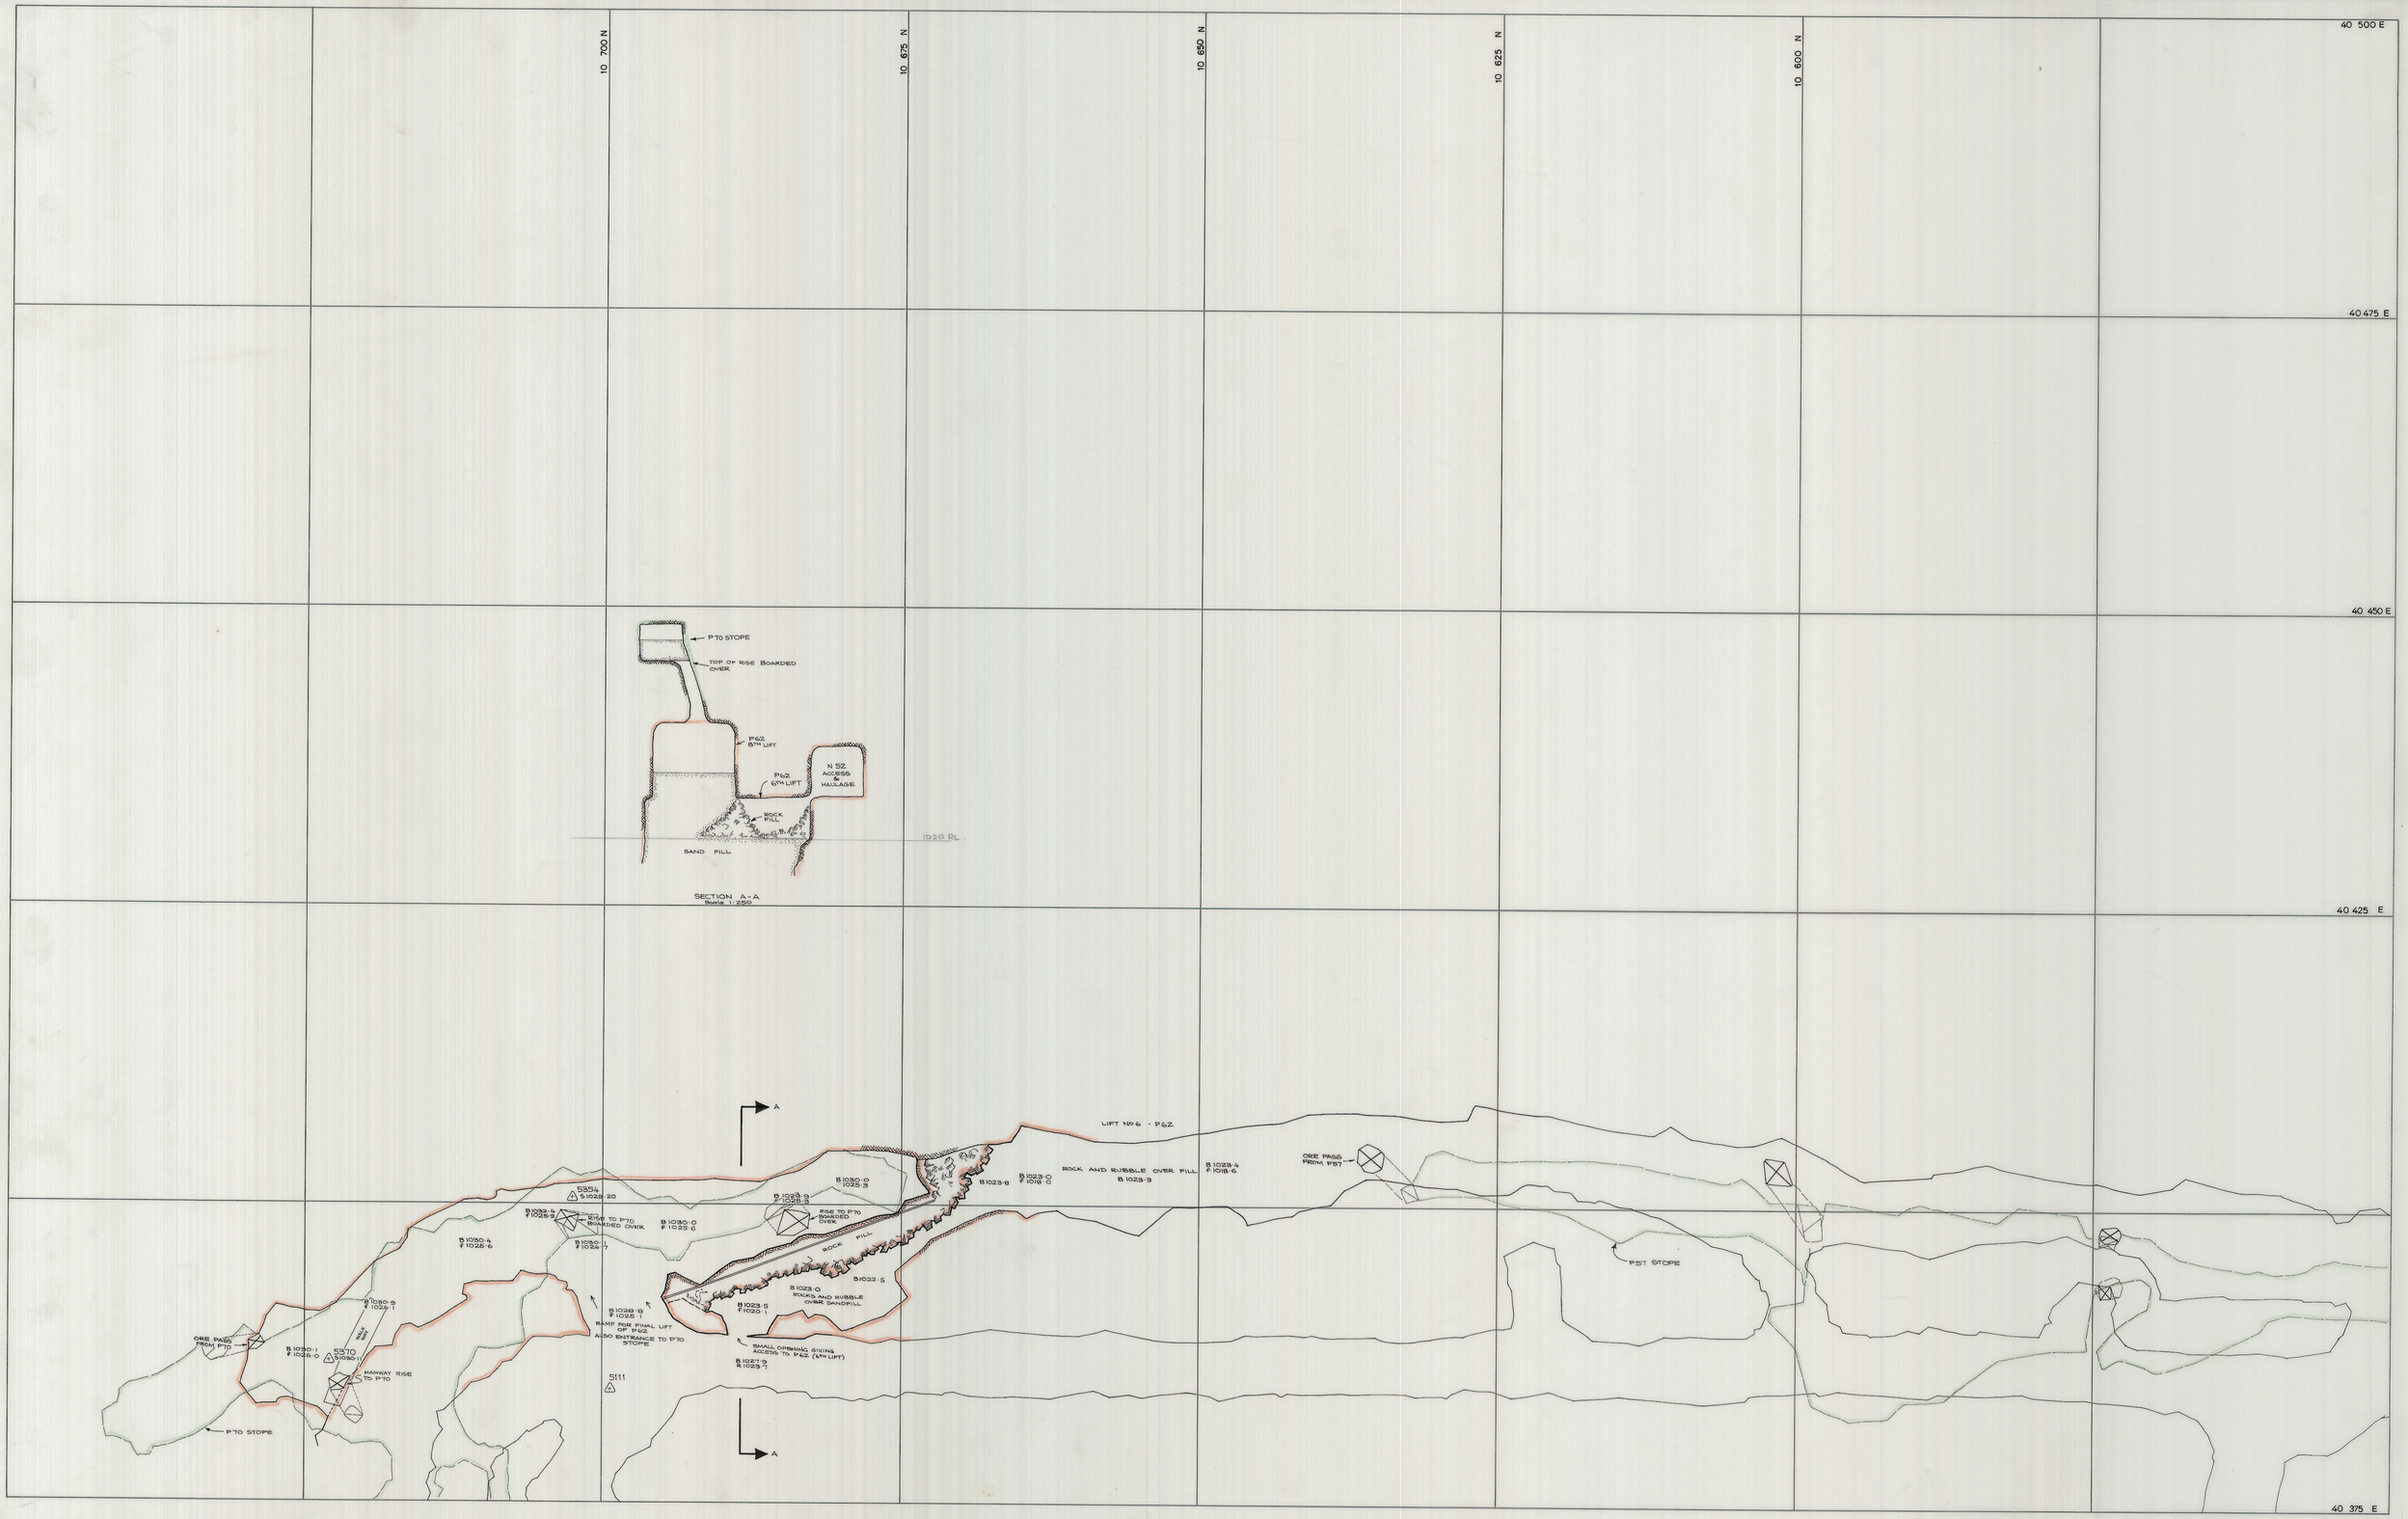

SCALE 1: 250	north	LOCATION: BOLD HEAD MINE	KING ISLAND SCHEELITE — A DIVISION OF WARMAN INTERNATIONAL	
		SUBJECT: DETAIL P 62 LIFT Nº 8	GRASSY	KING ISLAND
			PLAN NUMBER: 04BH13-166 125	