27 JUN 1981

5 cm

04BH13-166 228S

R 59
N59

0374_4542

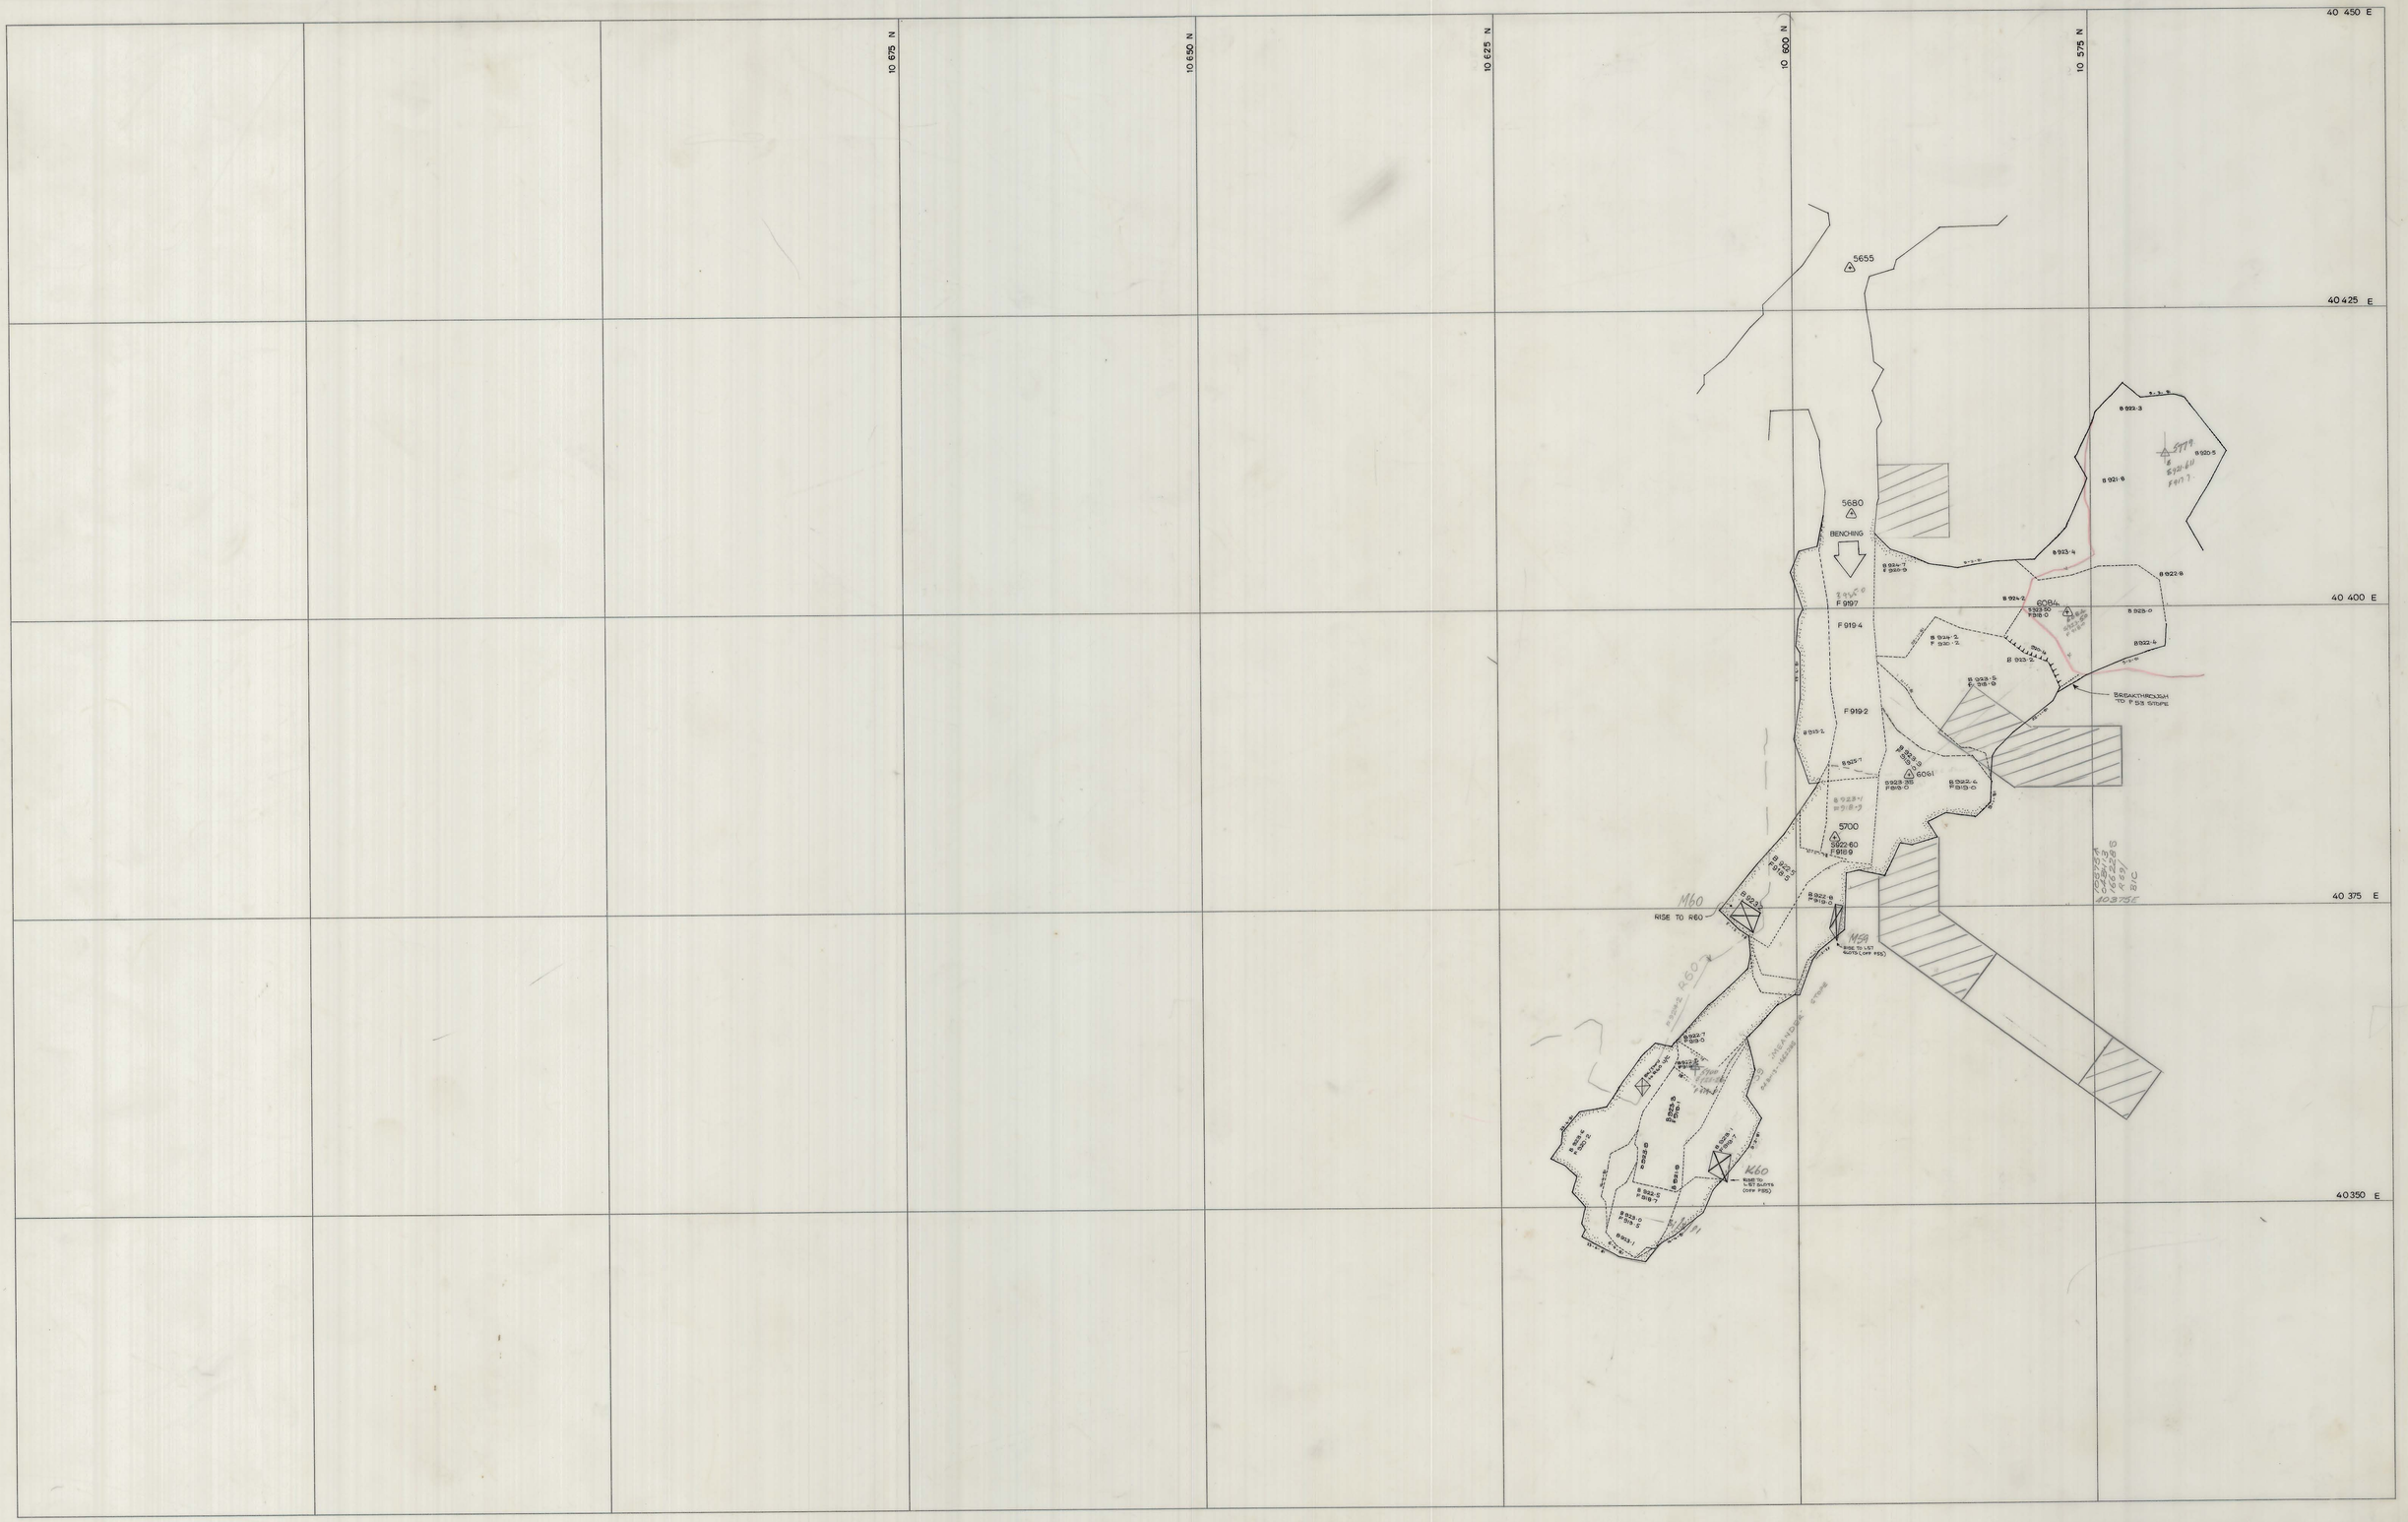

	SCALE 1:250	north	LOCATION: BOLD HEAD MINE SUBJECT: R59- C2 OREBODY

KING ISLAND SCHEELITE
A DIVISION OF WARRIAN INTERNATIONAL
GRASSY KING ISLAND

PLAN NUMBER 04BH13 - 166 228S