5 cm

04BC03-3002

0374_4548
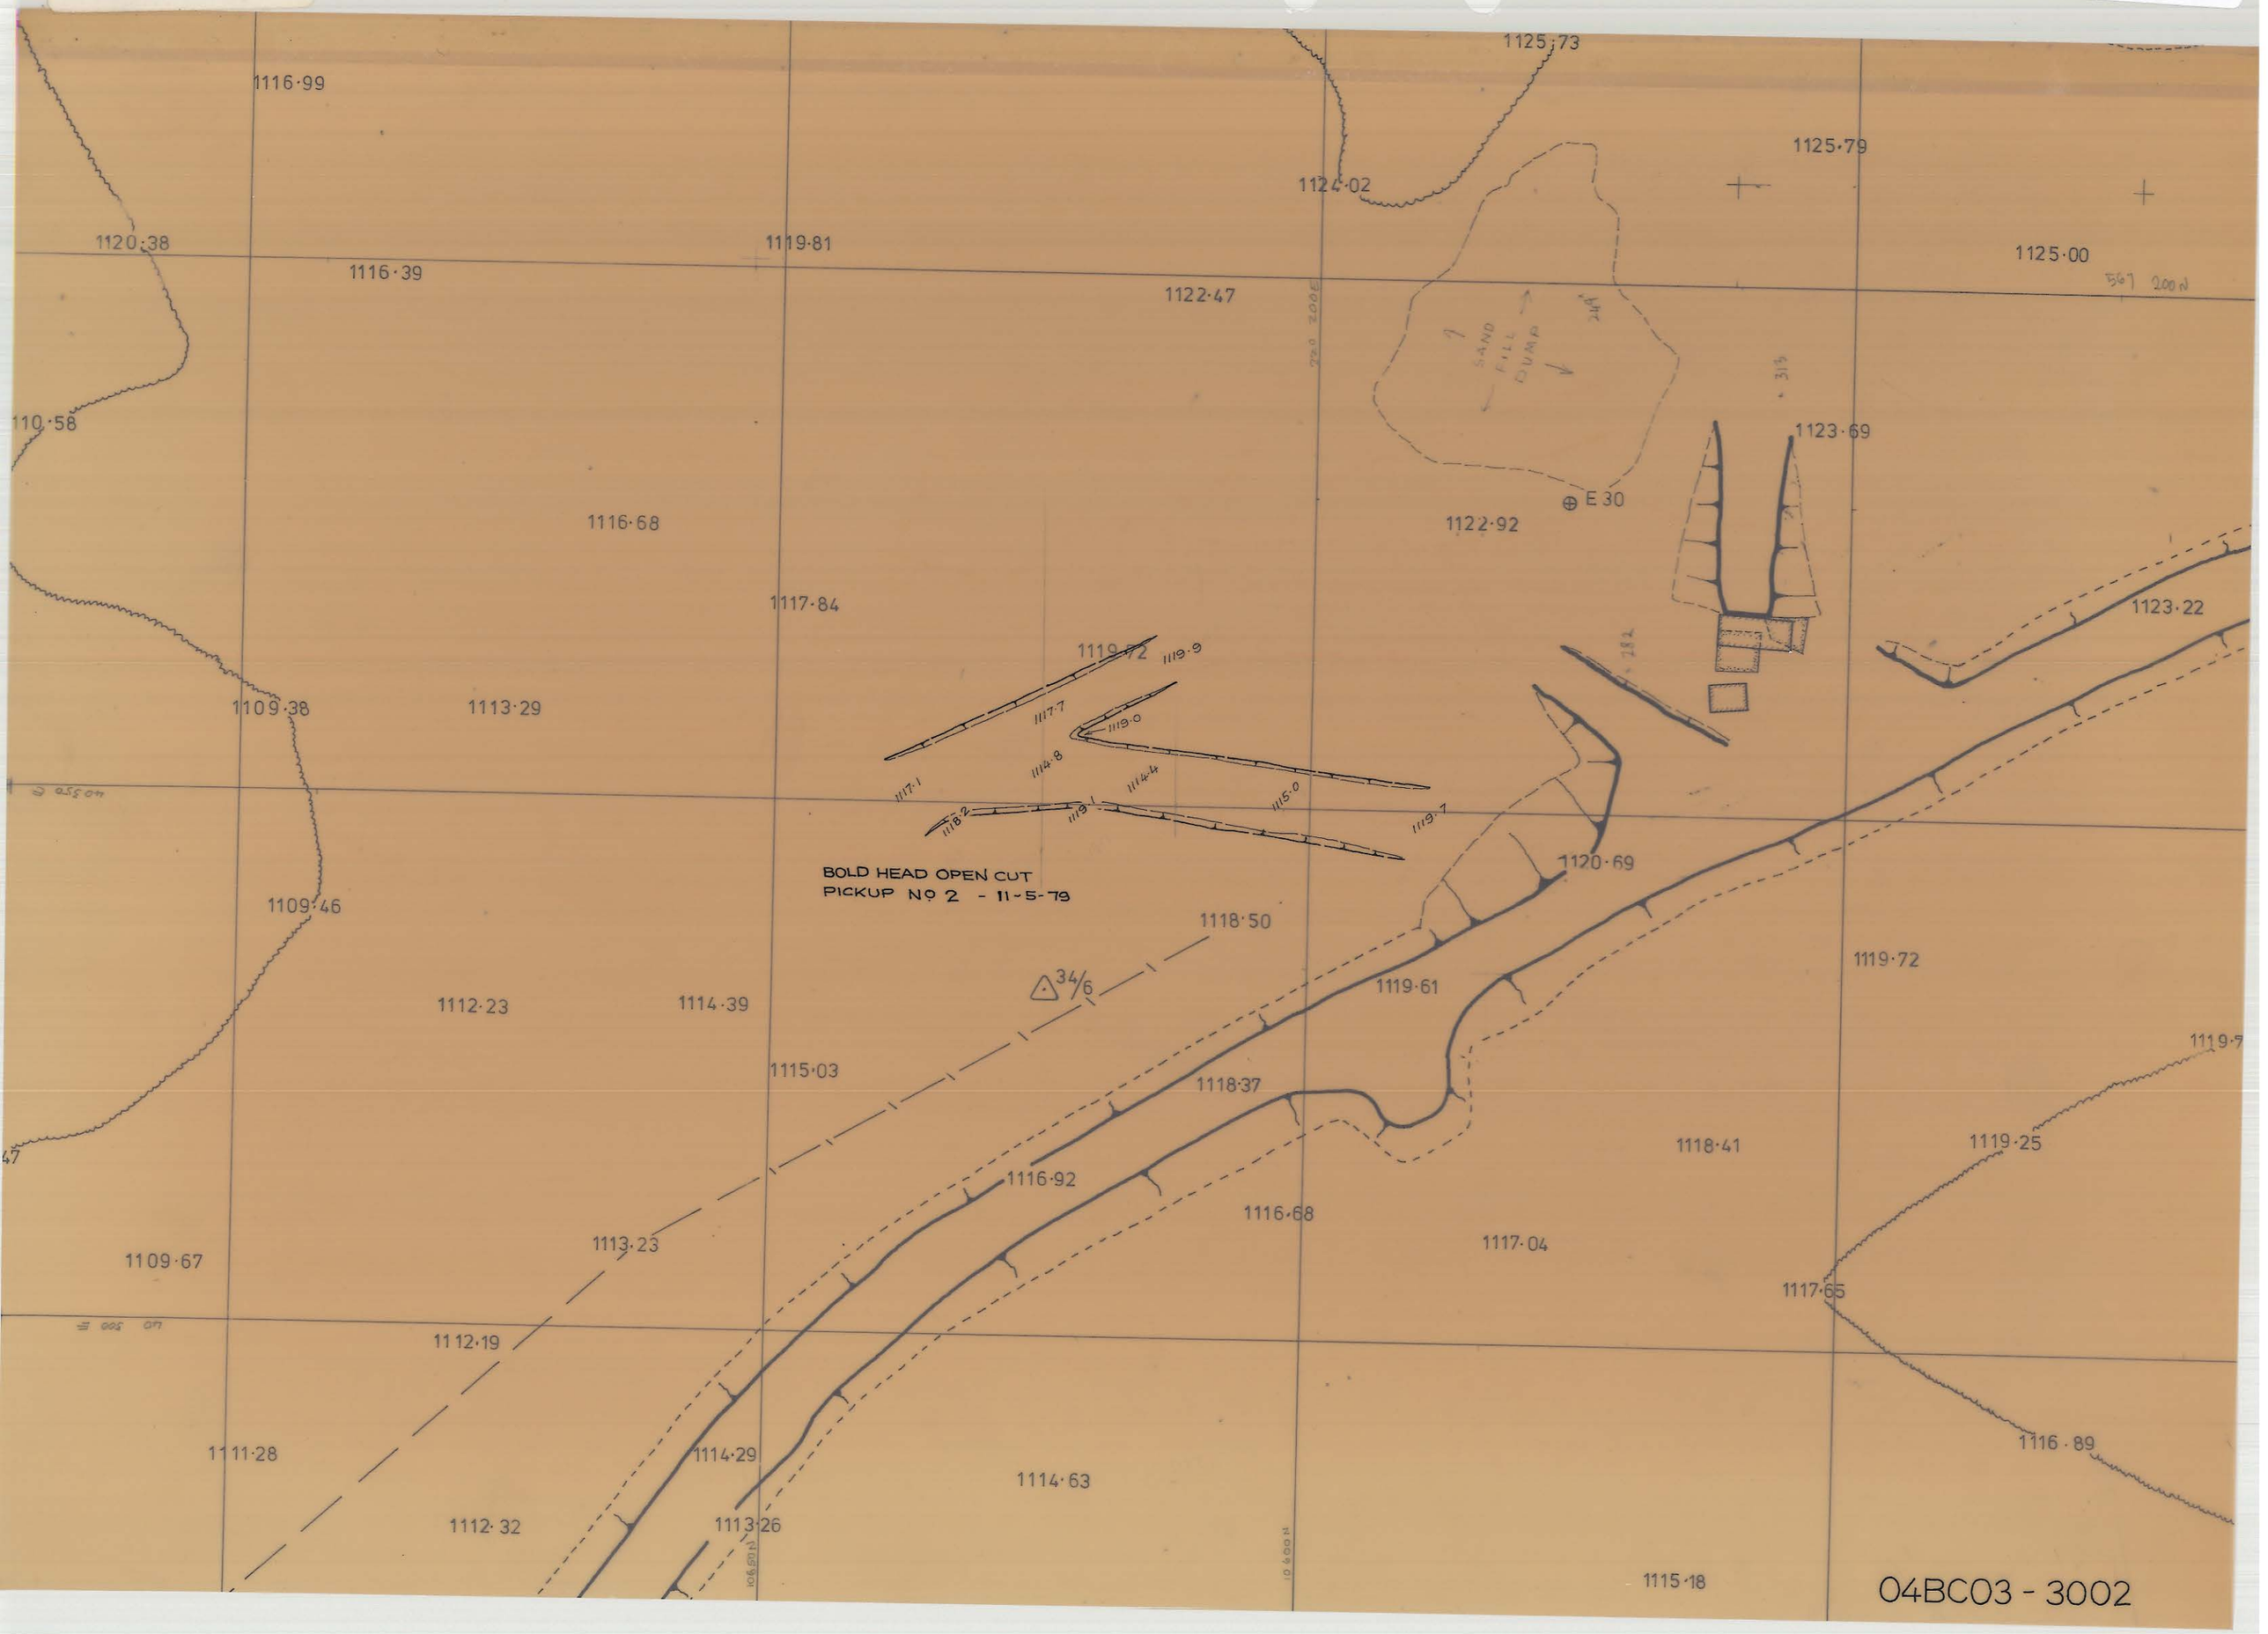
27 JUN 1981