



0374\_4556

04BH29-3001

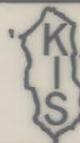

KING ISLAND SCHEELITE LTD.

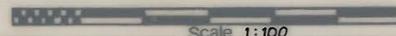

Scale 1:100

No 1-5-124

DATE 6:6:75  
SURVEYED J.C.  
DRAWN J.C.  
TRACED  
CHECKED

057 RISE ; PLAN AND SECTION.

RL 1045

RL 1040

RL 1035

RL 1030

Longitudinal Section.

SURVEY REFERENCE STRINGLINE

RL 1025

10395 E 10555 N

10560 N

10565 N

10390 E

10570 N

10575 N

10400 E

Plan.

5 cm