



0374_4562

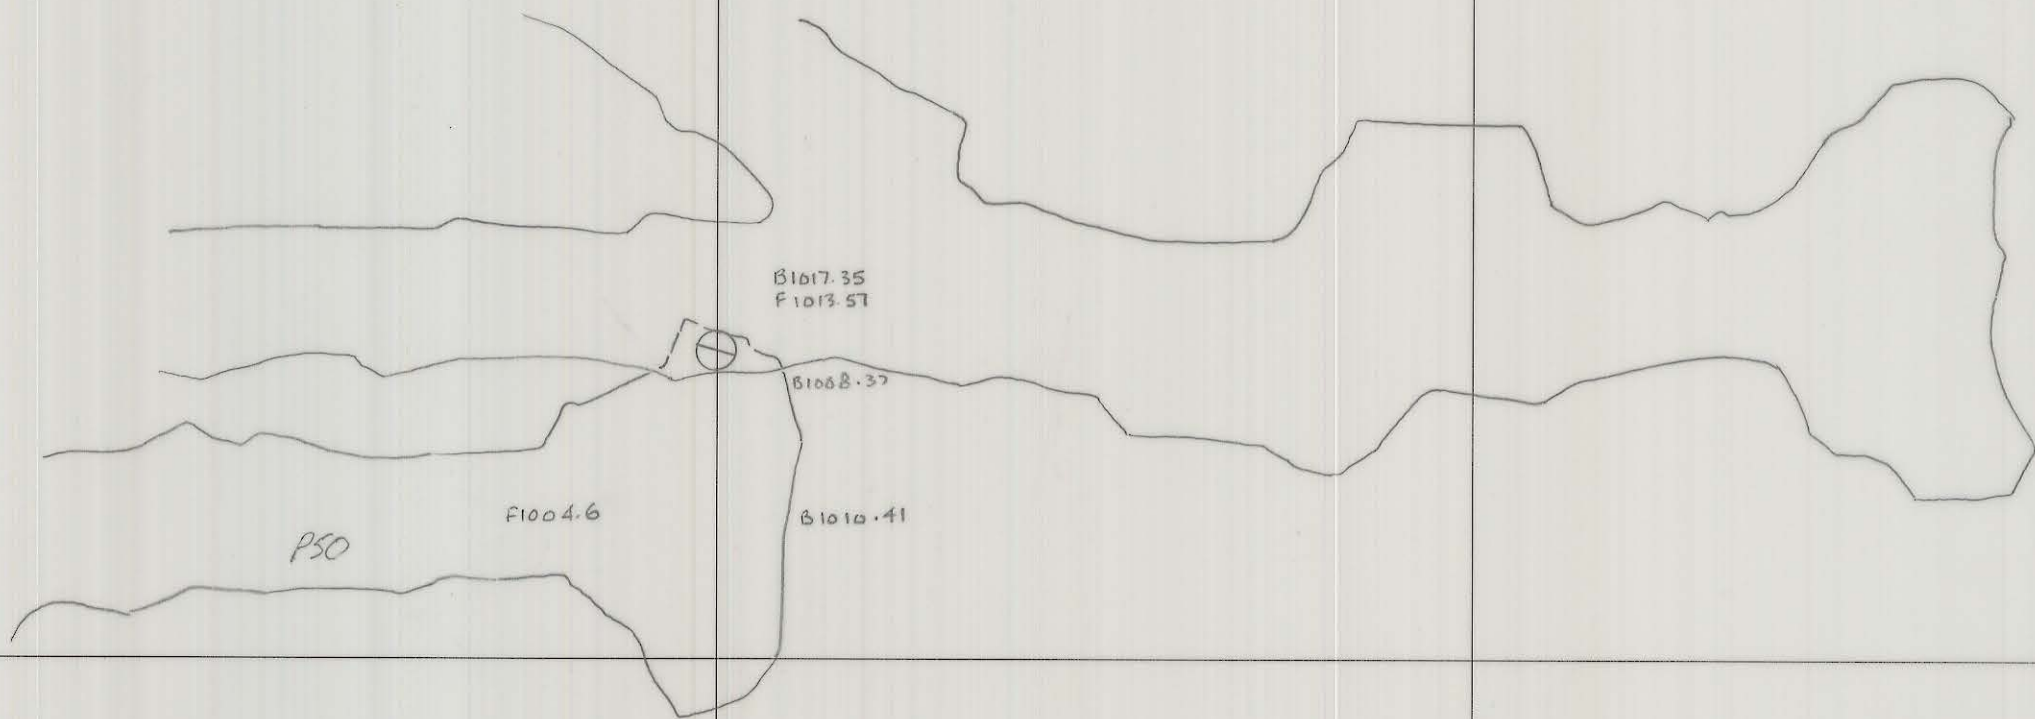

Scale 1:250

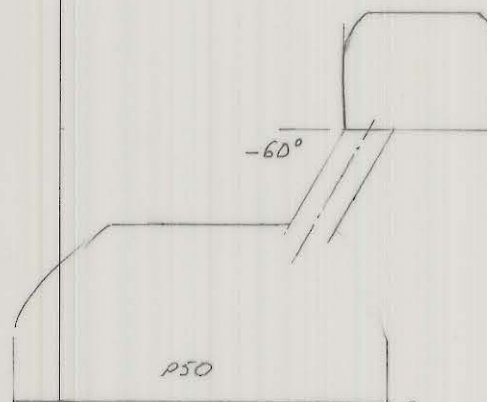

RL 1000.0

Section 40 425

Scale 1:250